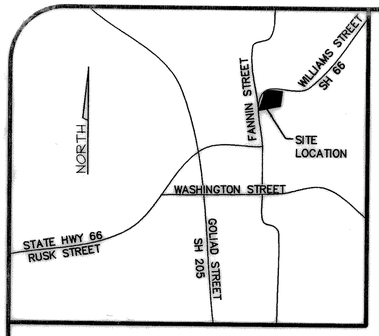

LOCATION MAP
NO SCALE

SITE CONSTRUCTION PLANS

FOR

SMITTY'S ROADHOUSE GRILLE
THOMAS & SMITH ADDITION
LOTS 1 & 2, BLOCK A

IN THE

CITY OF ROCKWALL, TEXAS

"THE NEW HORIZON"

SMITTY'S ROADHOUSE GRILLE 26108

RECORD DRAWING

SHEET INDEX

Sheet No.	Description
1	Cover Sheet
2	Plat
3	Plat
SP1	Site Plan
C1	Grading Plan
C2	Drainage Area Map
C3	Utility Plan
C4	Erosion Control
C5	Typical Details & Notes

Bentley
ENGINEERING, INC.

4125 BROADWAY BLVD.
SUITE A250
GARLAND, TEXAS 75043
PH. 972.240.4821
FAX. 972.240.0922

JUNE 2006

STATE OF TEXAS
MARC O. BENTLEY
64980
PROFESSIONAL ENGINEER

THE SEAL APPEARING ON THIS DOCUMENT WAS AUTHORIZED BY MARC O. BENTLEY, P.E. NO. 64980 ON 03/22/06

RECORD DRAWING

IMPROVEMENTS INDICATED ON THIS PLAN WHERE MADE IN ACCORDANCE WITH THE PROJECT PLANS & SPECIFICATIONS. THE DESIGN ENGINEER IS NOT AWARE OF ANY CHANGES TO THESE PLANS OTHER THAN THOSE INDICATED.

DATE: MARCH 20, 2007

OWNERS:
JOHN THOMAS
302 WILLIAMS STREET
ROCKWALL, TX 75087
214-629-2249

GLEN SMITH
602 WILLIAMS STREET
ROCKWALL, TX 75087
214-850-2114

H:\2006\26108\bdasite.dwg Tue Mar 20 13:53:47 2007