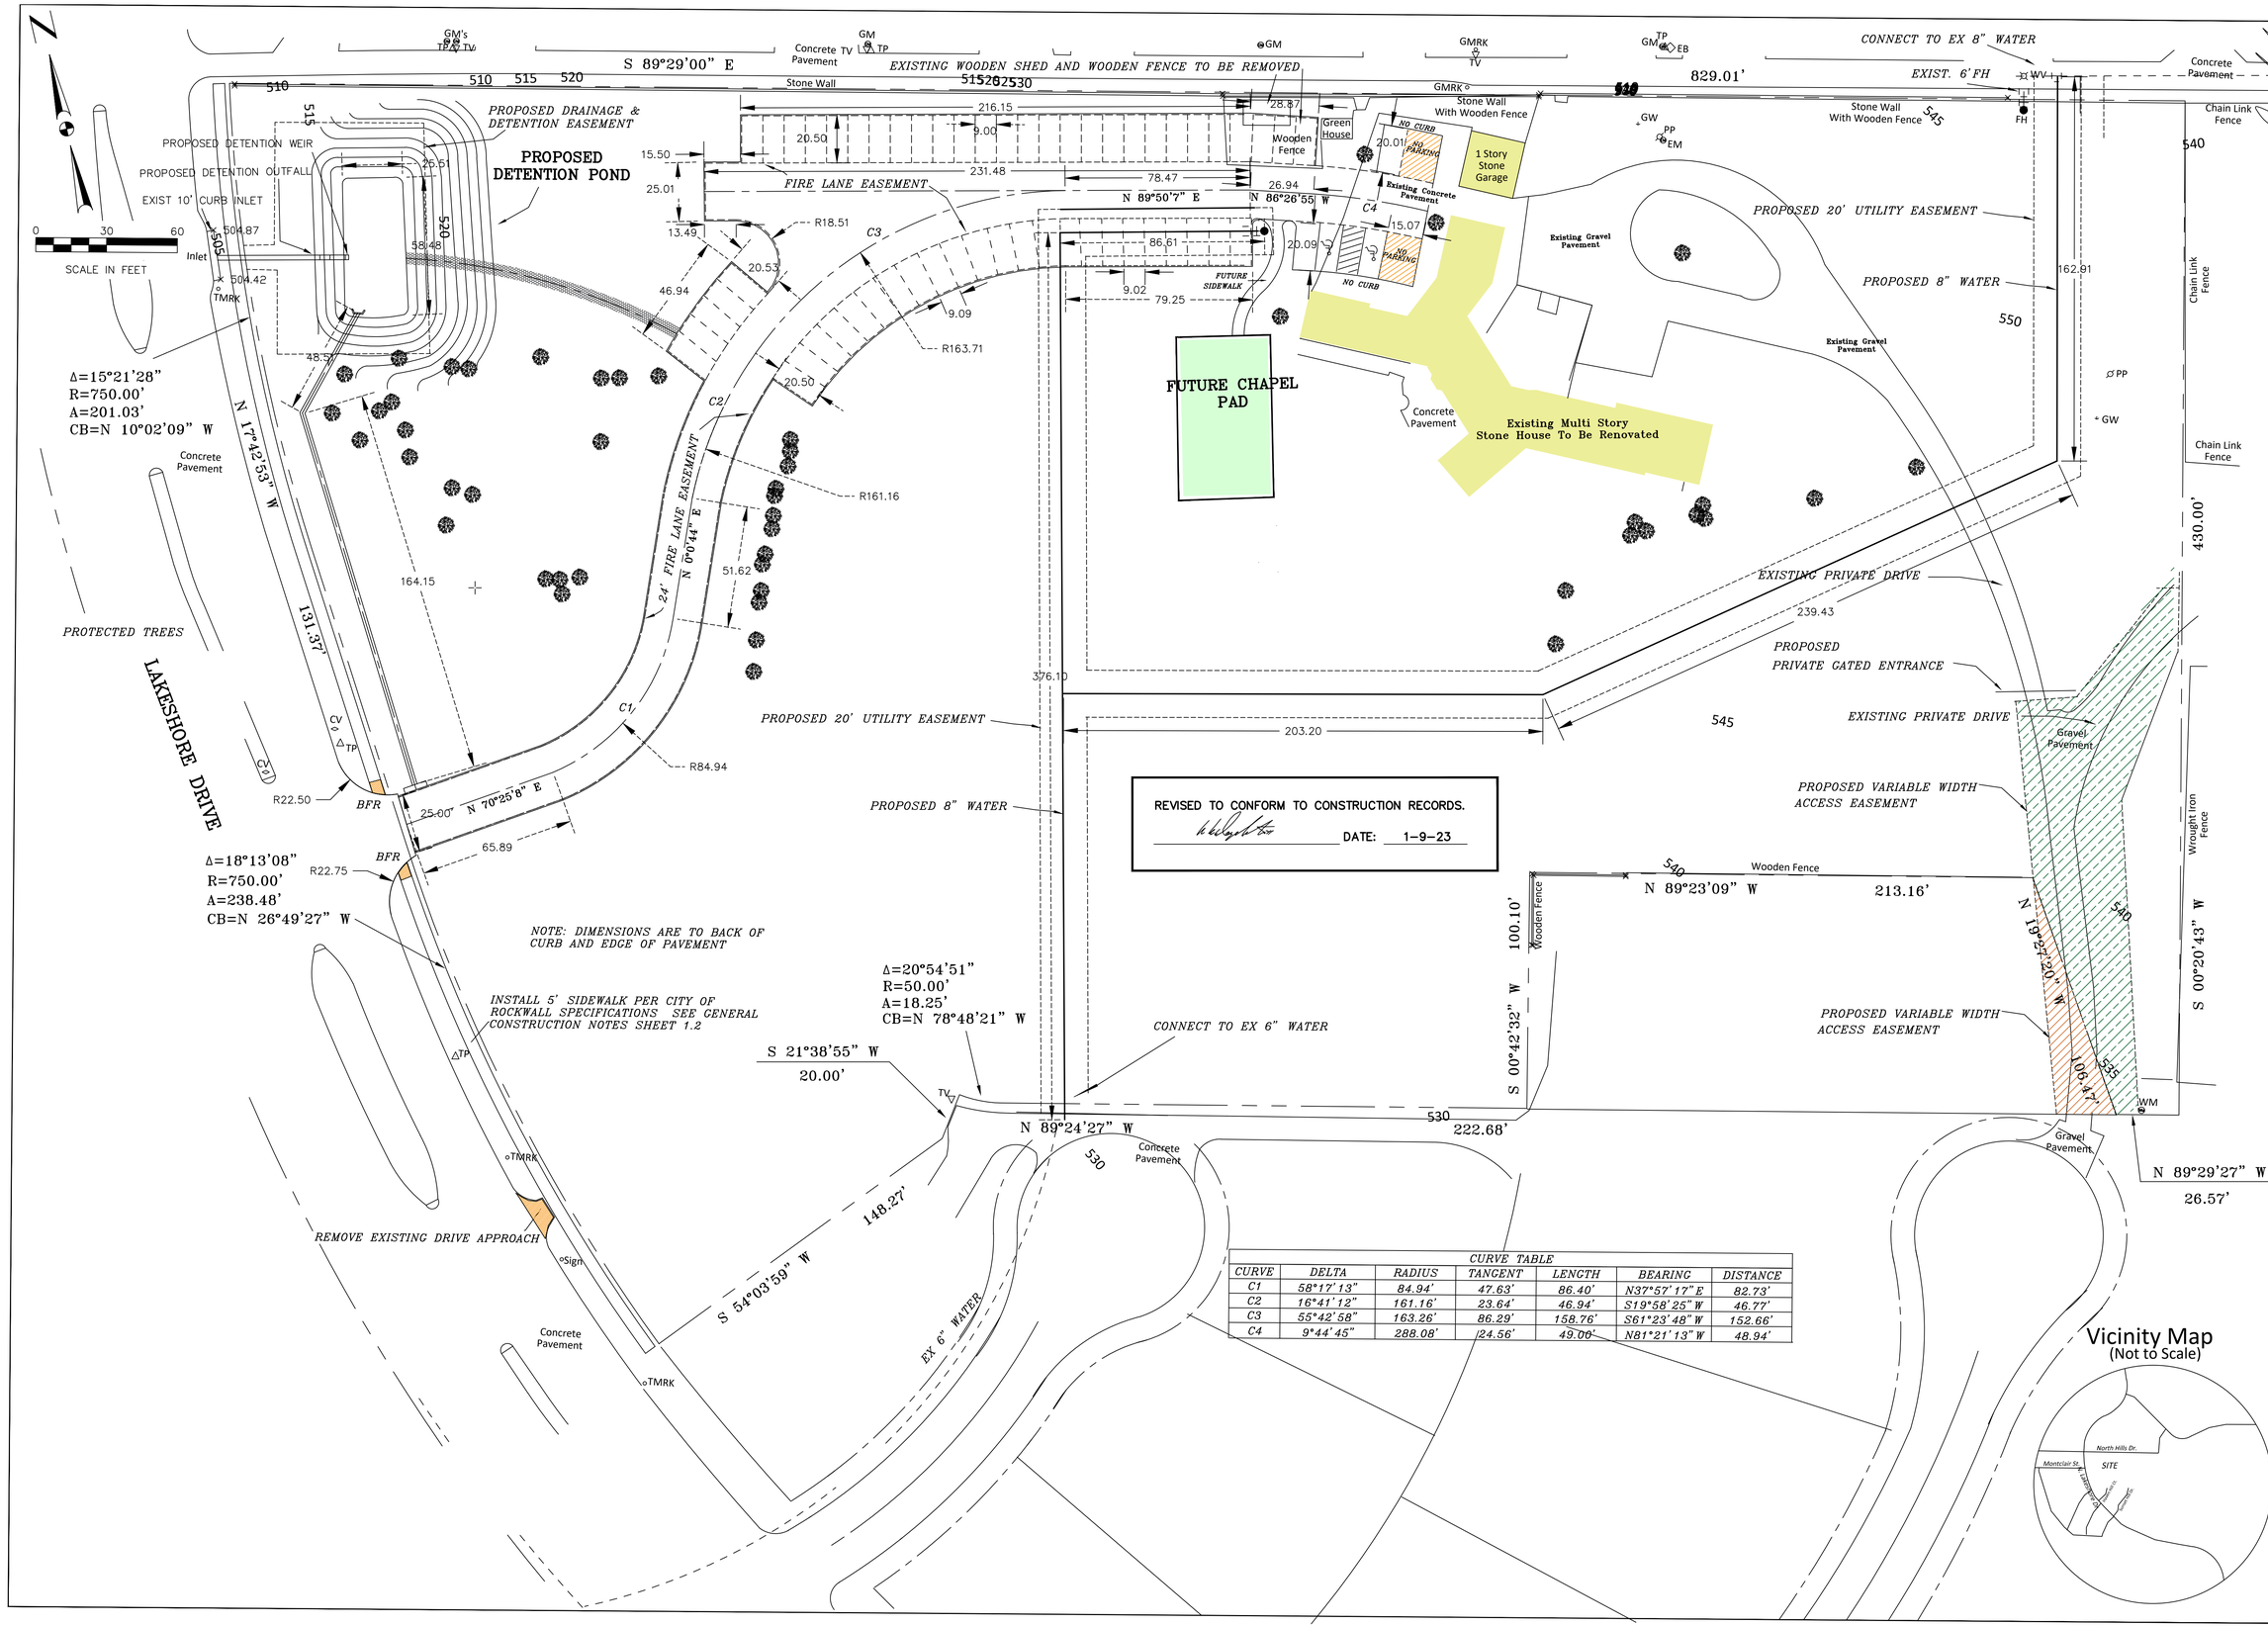

CURVE TABLE						
CURVE	DELTA	RADIUS	TANGENT	LENGTH	BEARING	DISTANCE
C1	58°17'13"	84.94'	47.63'	86.40'	N37°57'17"E	82.73'
C2	16°41'12"	161.16'	23.64'	46.94'	S19°58'25"W	46.77'
C3	55°42'58"	163.26'	86.29'	158.76'	S61°23'48"W	152.66'
C4	9°44'45"	288.08'	24.56'	49.00'	N81°21'13"W	48.94'

THE SEAL APPEARING ON THIS DOCUMENT WAS AUTHORIZED BY W.L. DOUPHRATE II TEXAS P.E. NO. 60102, F-886, ON DATE: DECEMBER 17, 2021.

DOUPHRATE & ASSOCIATES, INC.
ENGINEERING PROJECT MANAGEMENT SURVEYING
2235 RIDGE RD., # 200 ROCKWALL, TEXAS 75087
PHONE: (972)771-9004 FAX: (972)771-9005

DIMENSION CONTROL PLAN
ST. BENEDICT'S ANGLICAN CHURCH PROPERTY
1500 SUNSET HILL DR
CITY OF ROCKWALL
ROCKWALL COUNTY, TEXAS

REVISION
W.L.D.
CHECKED
G.C.W.
DRAWN
SCALE 1"=30' H 1"= V
DATE DEC 23, 2021
21007 DIM PL
PROJECT
3.0