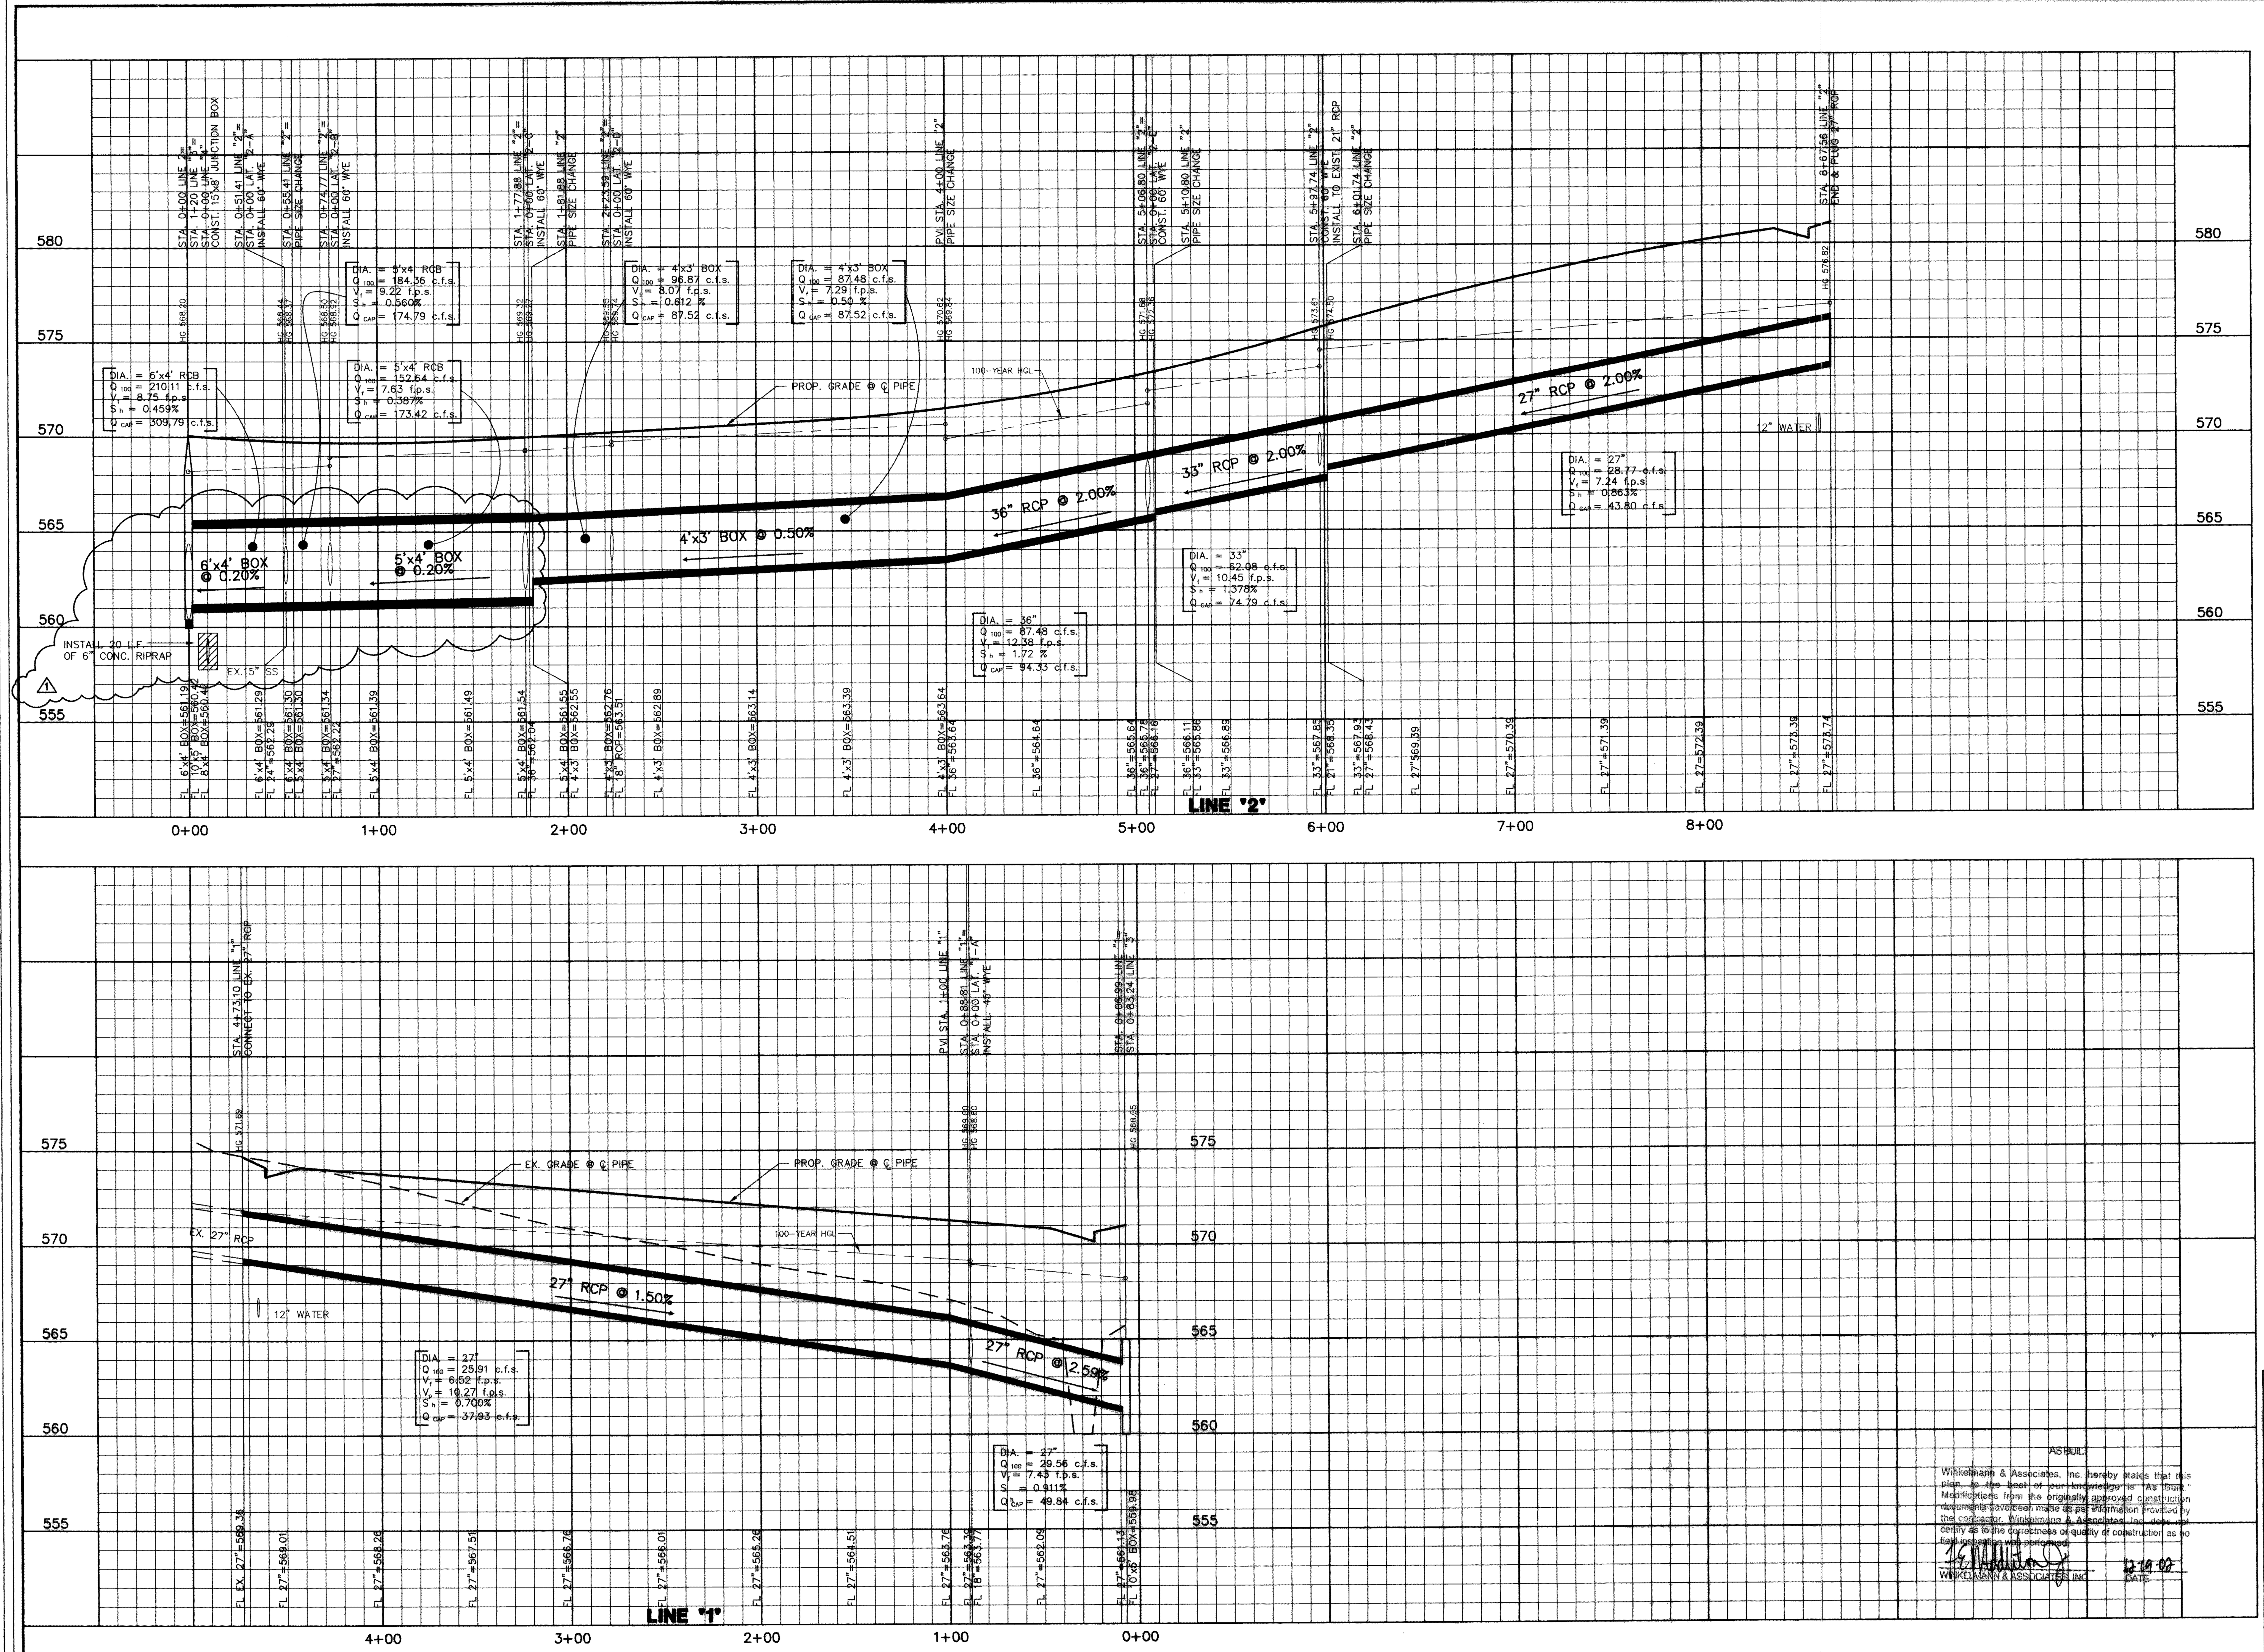


AS BUILT

Winkelmann & Associates, Inc. hereby states that this plan, to the best of our knowledge is "As Built". Modifications from the originally approved construction documents have been made as per information provided by the contractor. Winkelmann & Associates, Inc. does not certify as to the correctness or quality of construction as so field inspection was performed.

WINKELMANN & ASSOCIATES, INC. — DATE 12-19-02

THESE CONSTRUCTION PLANS WERE PREPARED UNDER THE RESPONSIBLE SUPERVISION OF F.E. MIDDLETON, JR., REGISTERED PROFESSIONAL ENGINEER NO. 67449. 7-10-02

THE SEAL APPEARING ON THIS DOCUMENT WAS AUTHORIZED BY F.E. MIDDLETON, JR., P.E. #67449

| NO. | DATE | REVISION | APPROV. |
|---|---|---|---|
| 1 | 7/10/02 | REVISED LINE "2" GRADES AND ADDED 20 L.F. OF 6" CONCRETE ENCASEMENT AROUND EXIST. 15" SAN. SEWER | RB |

**Winkelmann & Associates, Inc.**
CONSULTING CIVIL ENGINEERS ■ SURVEYORS
6750 Hillcrest Plaza Drive, Suite 100, Dallas, Texas 75230
(972) 490-7090 (972) 490-7099 FAX

W.H. BAIRD SURVEY, ABSTRACT NO. 25
CITY OF ROCKWALL
ROCKWALL COUNTY, TEXAS

CONTINENTAL HOMES
621 WEST COLLEGE STREET
GRAPEVINE, TEXAS 76051

# STORM SEWER PROFILES
## LINE '1' & LINE '2'
## STATE HIGHWAY 205 BYPASS

BENCHMARK: ELEV. = 600.69
CITY OF ROCKWALL R-19
BRASS MONUMENT AT THE N/W CORNER OF SILVERVIEW & DIAMOND WAY, 500' ± SOUTH OF S.H. 276.

BENCHMARK: ELEV. = 583.56
R.R. SPIKE SET IN THE CENTERLINE OF S.H. 276 3600± WEST OF F.M. 549

Scale : H: 1"=40' V: 1"=4' — Date : 5-14-02
Designed By : RB
Drawn By : MK
Checked By : FEM
File : 32006STP.DWG — View :
Project No. : 32006.01

SHEET 8 OF 12

C:\RUSSELL\32006STP.dwg Wed Jul 10 15:08:45 2002 RUSSELL