STORM SEWER LINE "A"
STA. 0+00–4+71.84

HORIZ. SCALE: 1" = 30'
VERT. SCALE: 1" = 3'

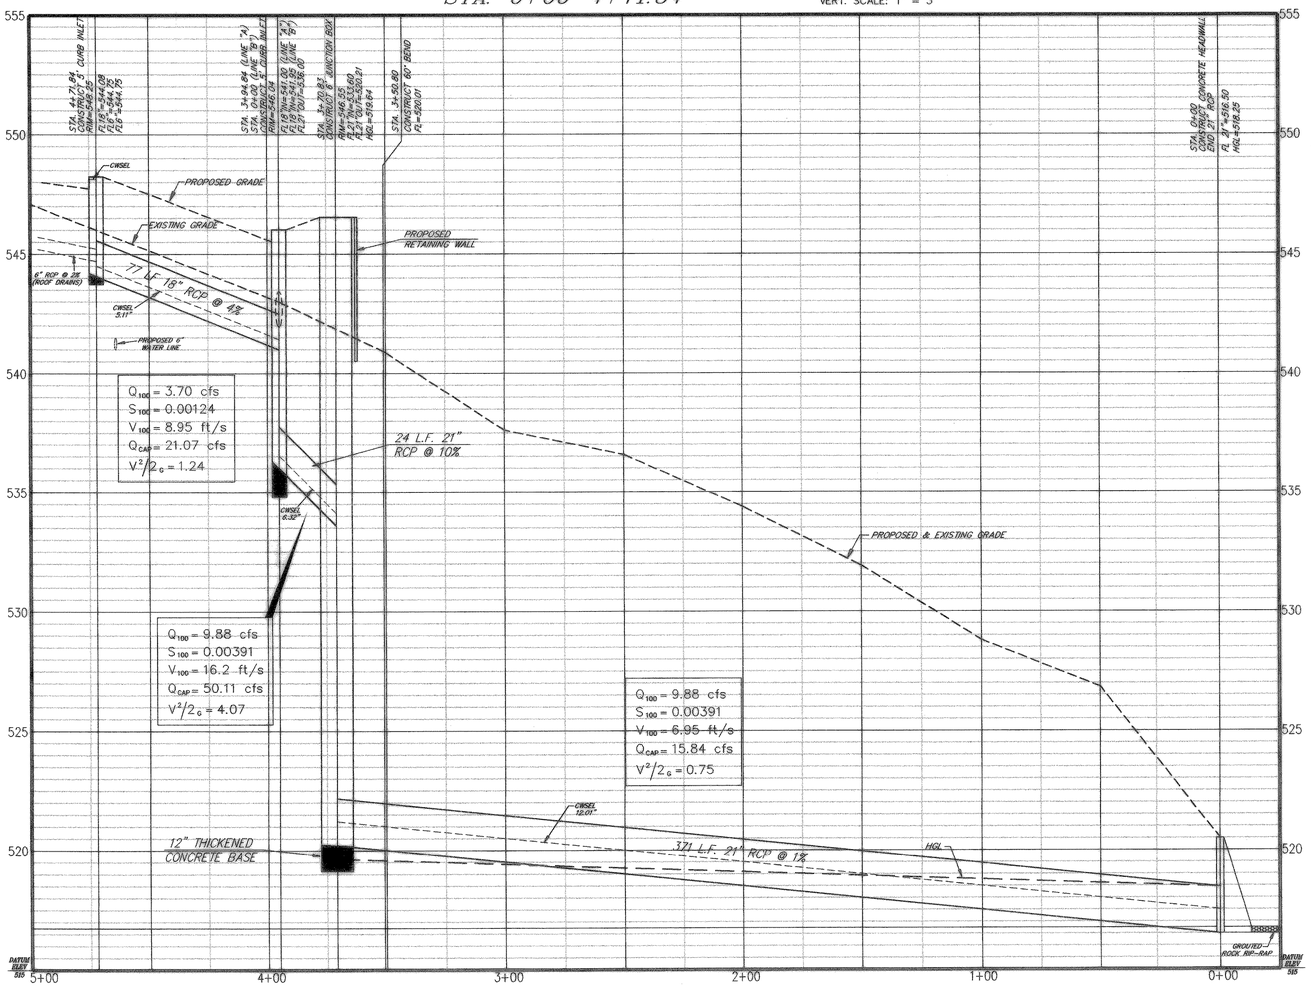

STORM SEWER LINE "B"
STA. 0+00–1+89.83

HORIZ. SCALE: 1" = 30'
VERT. SCALE: 1" = 3'

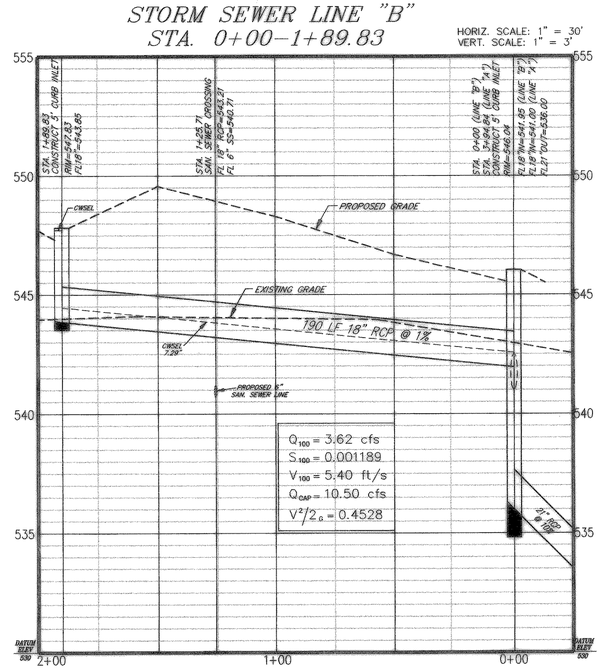

AS BUILT

SHEET NO. C-7 OF 10

FAMOUS FOR STEAKS — Steak n Shake — STEAKBURGERS

ENGINEERING ASSOCIATES, INC.
ENGINEERS · PLANNERS · SURVEYORS
12300 FORD ROAD, SUITE 110
DALLAS, TEXAS 75234
(972) 488-3737
(972) 488-8732
DWG NAME: 9434proj.dwg
JOB NO.: 9434.0
DATE: 08/27/04
PRELIM.

STATE OF TEXAS — M. CHRISTOPHER ROGERS — 89618 — LICENSED PROFESSIONAL ENGINEER

REVISION NO.	DATE	COMMENTS
1	4-5-05	PER INITIAL CITY COMMENTS
2	5-10-05	PER SECOND CITY COMMENTS

08/27/04	TJB	JKG	JKG	JKG
DATE	PRN	PM	DES	DRW

STORM SEWER PROFILE SHEET
STEAK 'n SHAKE
PROPOSED LOT 1, BLOCK A
STEAK 'N SHAKE ADDITION
INTERSTATE HIGHWAY 30, ROCKWALL, TEXAS