


CURVE DATA

CV#	DELTA	RADIUS	LENGTH	CHORD & BEARING
1	40°33'30"	100.00	70.79	N 77°46'41" W 69.32'
2	24°18'55"	300.00	127.31	N 69°39'34" W 126.36'
3	24°18'55"	332.50	140.05	S 69°39'34" E 140.05'
4	24°18'55"	365.00	154.90	N 69°39'34" W 153.74'

B.M.
CITY OF ROCKWALL CONTROL MONUMENT #6
ELEVATION = 556.17

T.B.M.
N.E. CORNER OF FOOD LION TRACT RIM OF
S.S. MANHOLE
ELEVATION = 571.75

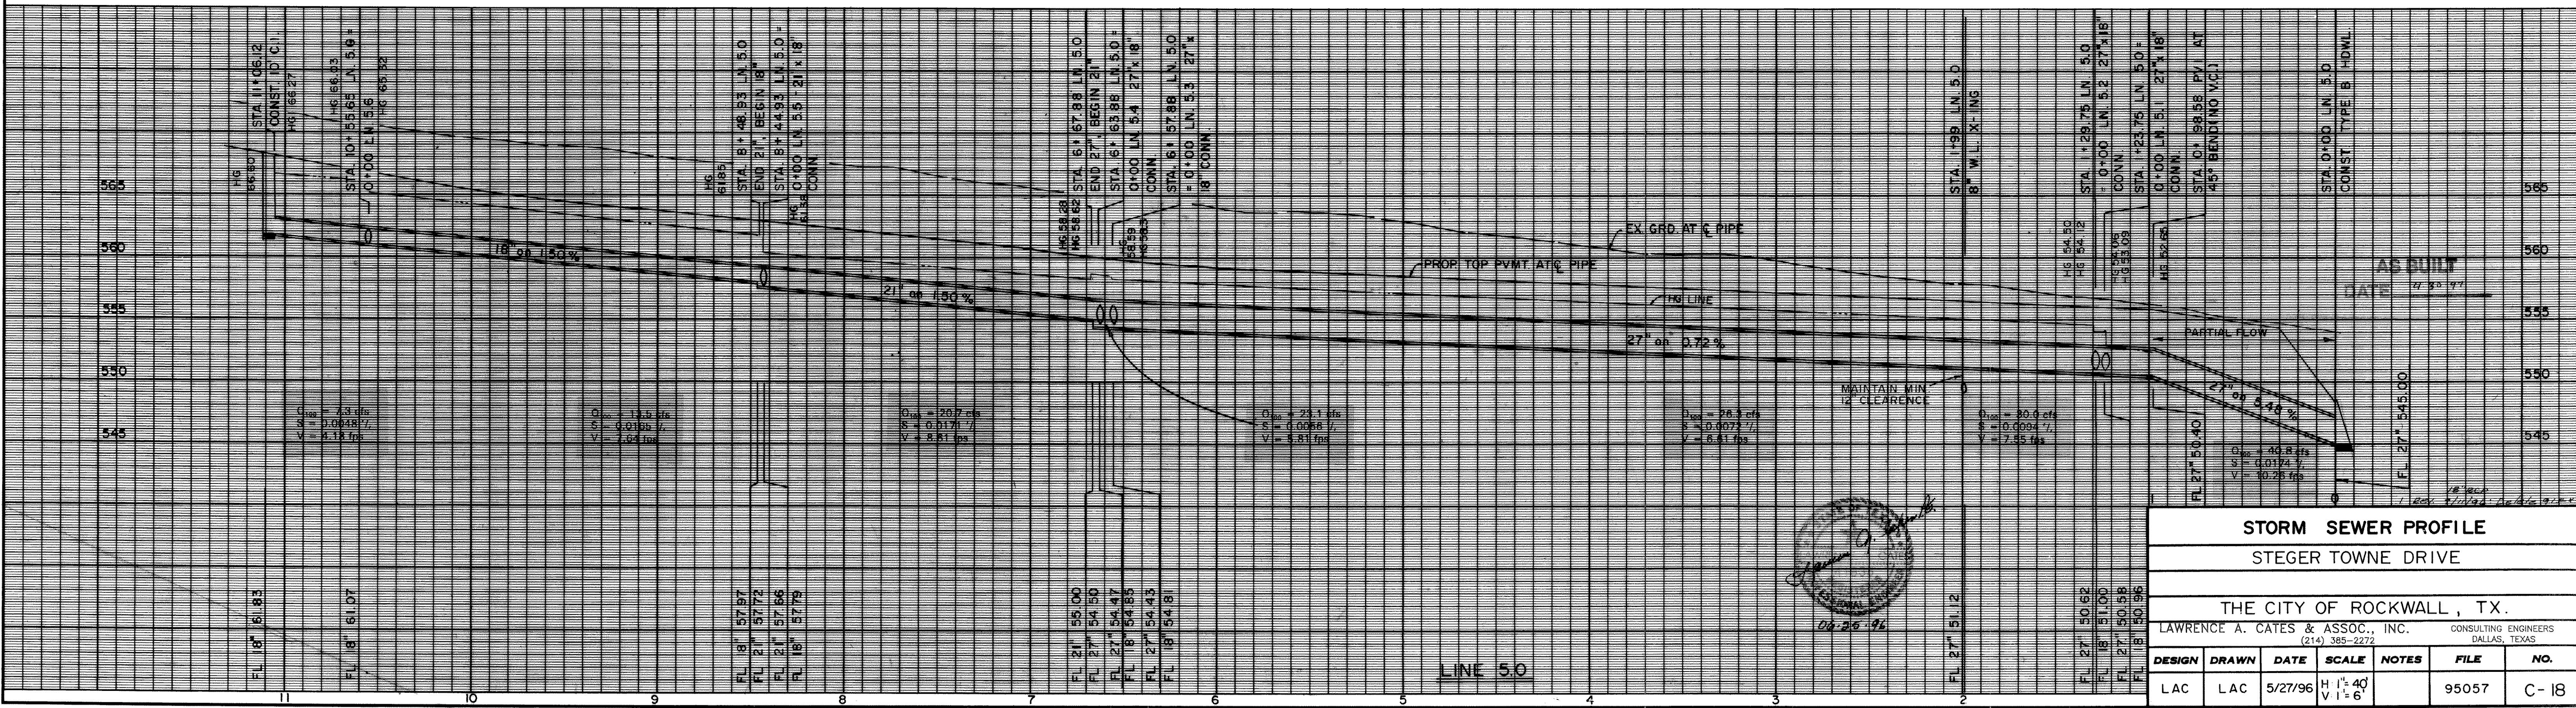

STORM SEWER PROFILE
STEGER TOWNE DRIVE

THE CITY OF ROCKWALL, TX.
LAWRENCE A. CATES & ASSOC., INC. CONSULTING ENGINEERS
DALLAS, TEXAS

DESIGN	DRAWN	DATE	SCALE	NOTES	FILE	NO.
LAC	LAC	5/27/96	H 1" = 40' V 1" = 6'		95057	C-18