


BACK OF CURVE DATA

CV#	DELTA	RADIUS	LENGTH	CHORD & BEARING
4	24°18'55"	310.00'	131.56'	S 69°39'34" E 130.57'
5	24°18'55"	332.50'	140.05'	S 69°39'34" E 140.05'
6	24°18'55"	355.00'	150.66'	S 69°39'34" E 149.53'

B.M.
CITY OF ROCKWALL CONTROL MONUMENT #6
ELEVATION = 556.17

T.B.M.
N.E. CORNER OF FOOD LION TRACT RIM OF
S.S. MANHOLE
ELEVATION = 571.75

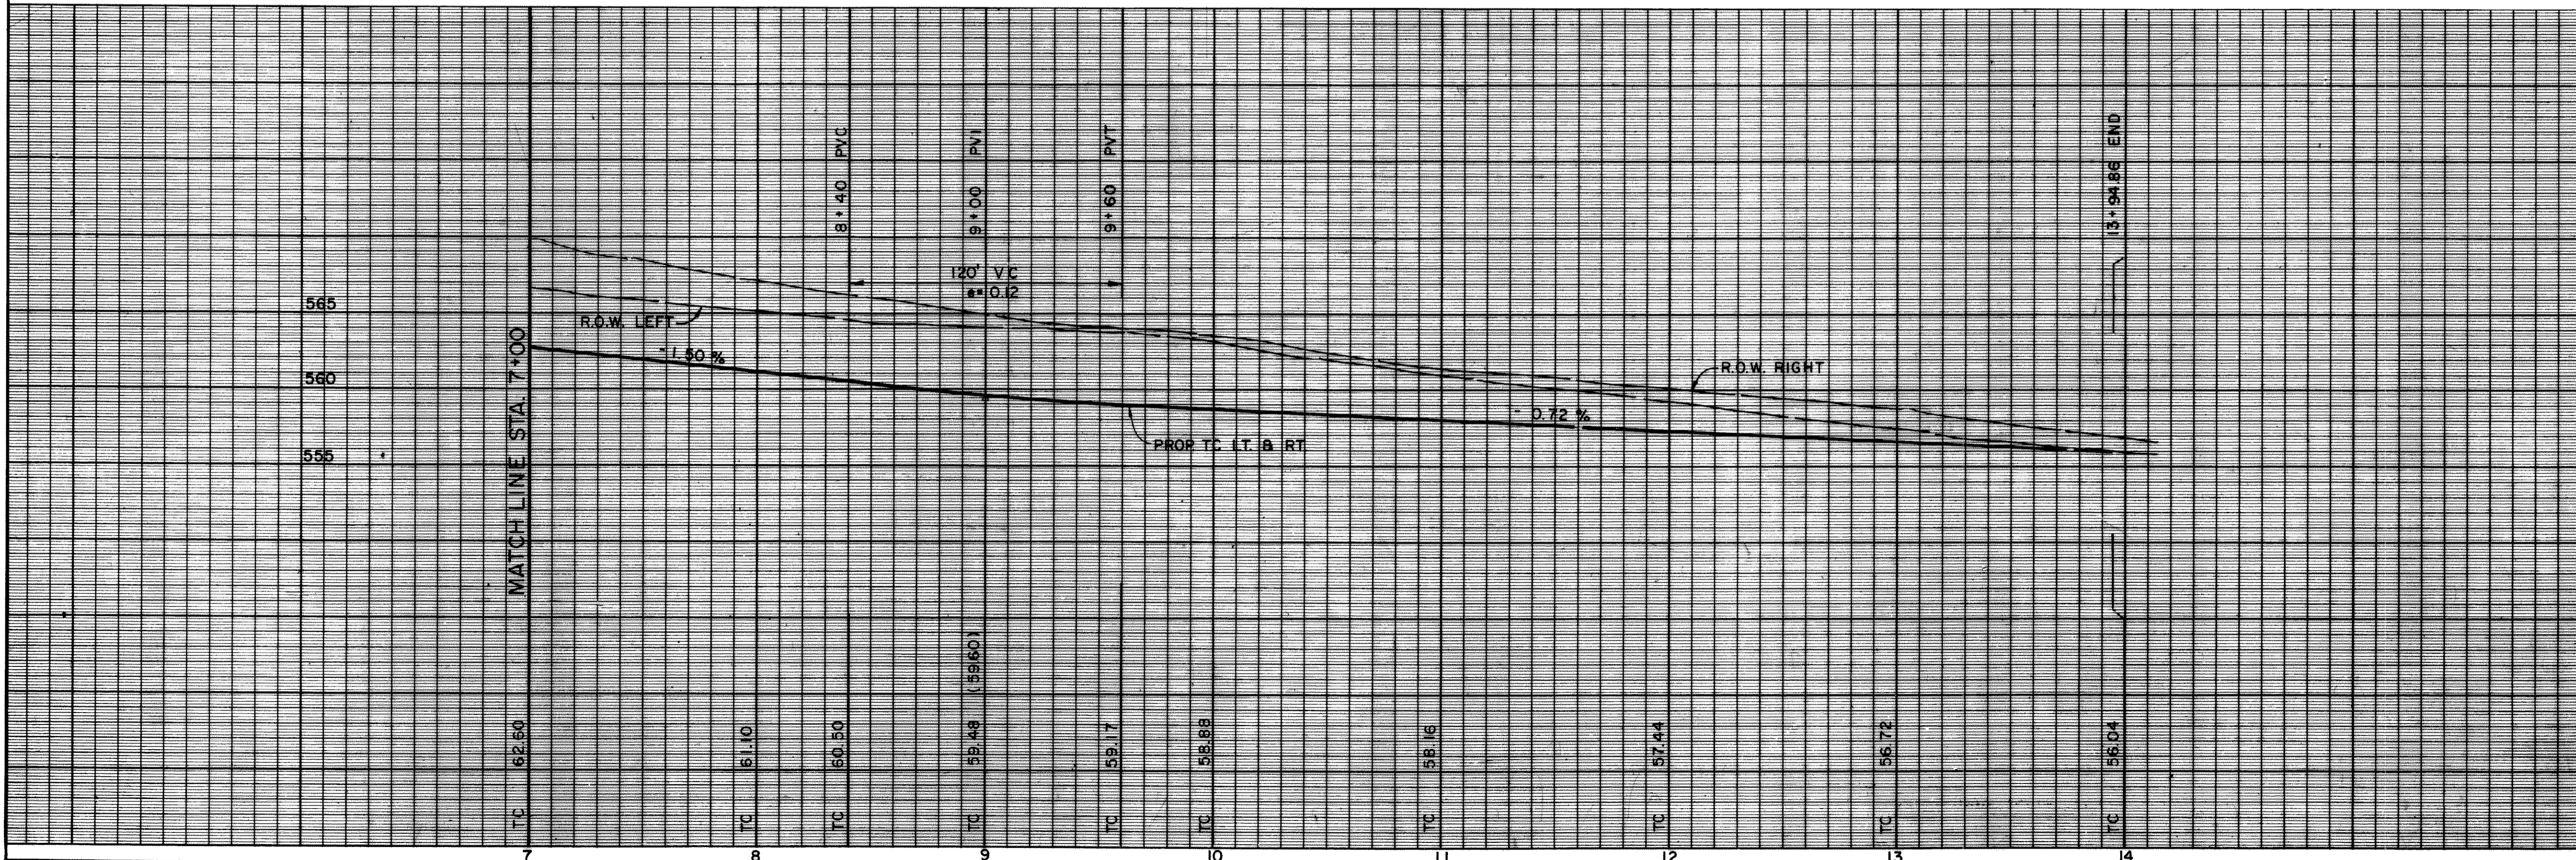

Lawrence A. Cates
4/30/96
842596

PAVING PLAN AND PROFILE						
STEGER TOWNE DRIVE						
F.M. 740 (RIDGE ROAD) & I.H. 30						
THE CITY OF ROCKWALL, TEXAS						
LAWRENCE A. CATES & ASSOC.						CONSULTING ENGINEERS DALLAS, TEXAS
DESIGN	DRAWN	DATE	SCALE	NOTES	FILE	NO.
LAC	LAC	4/8/96	H: 1"=40' V: 1"=6'		95057	C-8