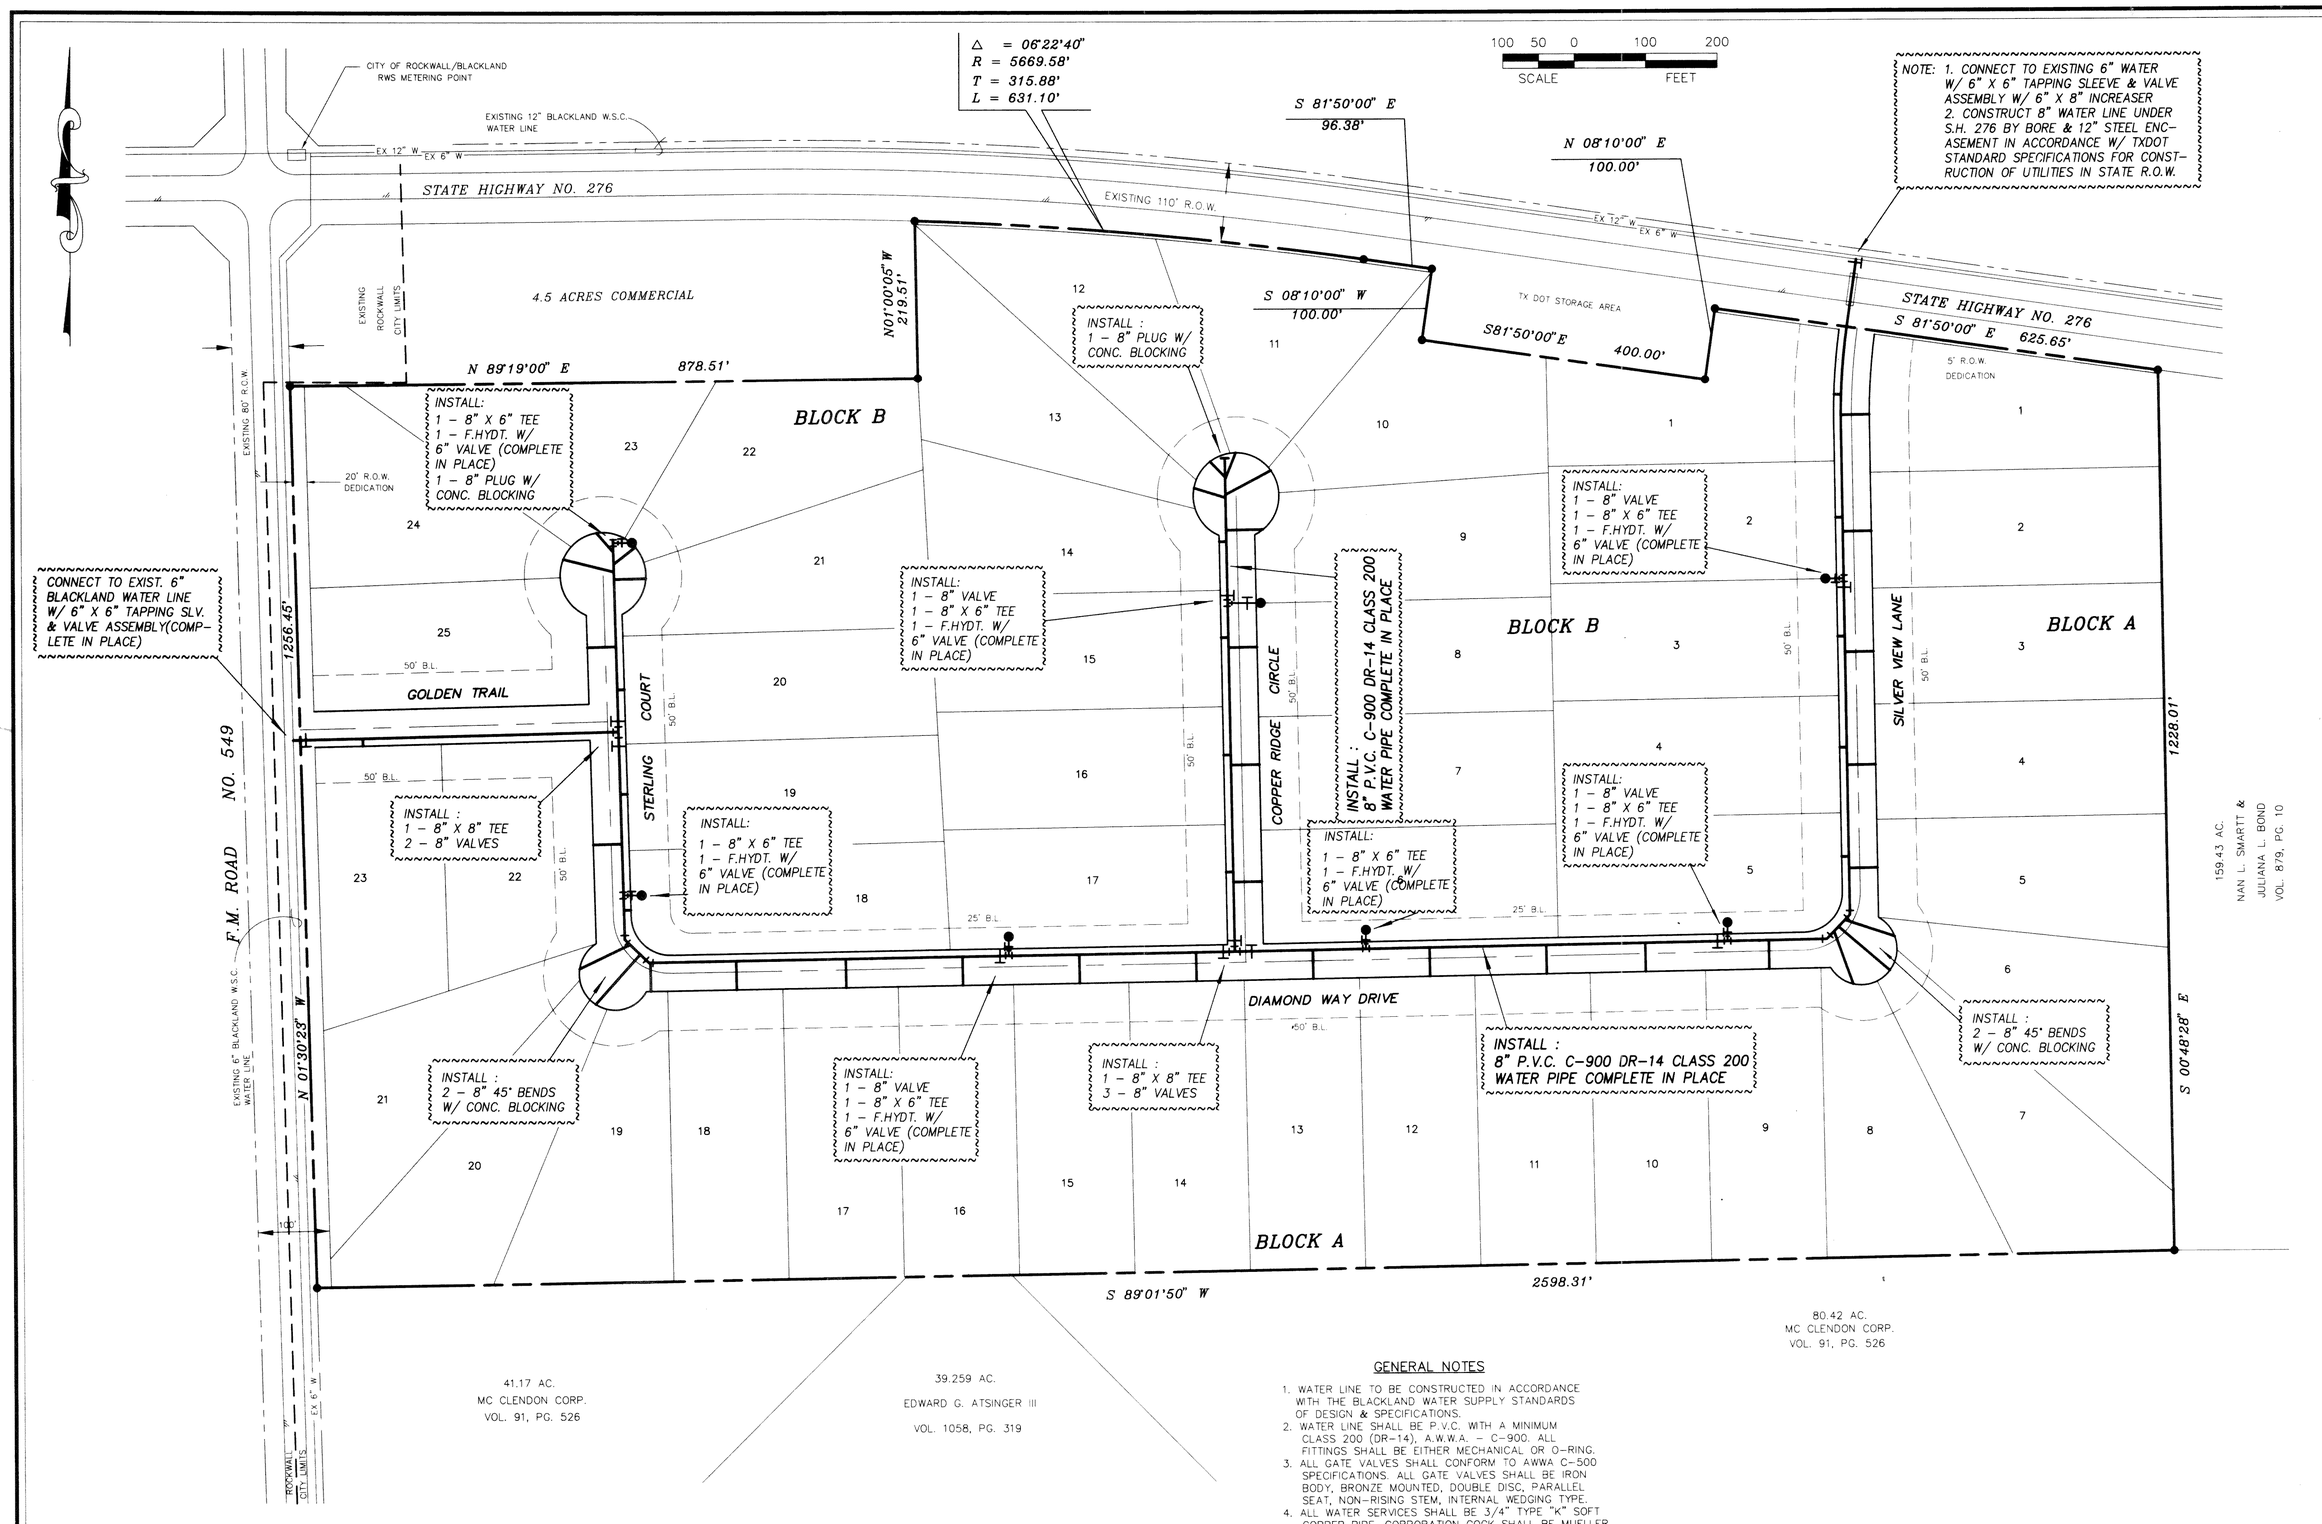

GENERAL NOTES

1. WATER LINE TO BE CONSTRUCTED IN ACCORDANCE WITH THE BLACKLAND WATER SUPPLY STANDARDS OF DESIGN & SPECIFICATIONS.
2. WATER LINE SHALL BE P.V.C. WITH A MINIMUM CLASS 200 (DR-14), A.W.W.A. – C-900. ALL FITTINGS SHALL BE EITHER MECHANICAL OR O-RING.
3. ALL GATE VALVES SHALL CONFORM TO AWWA C-500 SPECIFICATIONS. ALL GATE VALVES SHALL BE IRON BODY, BRONZE MOUNTED, DOUBLE DISC, PARALLEL SEAT, NON-RISING STEM, INTERNAL WEDGING TYPE.
4. ALL WATER SERVICES SHALL BE 3/4" TYPE "K" SOFT COPPER PIPE. CORPORATION COCK SHALL BE MUELLER NO. H-15000 W/ STRAIGHT COUPLING NUT OR APPROVED EQUAL. CURB STOP SHALL BE MUELLER NO. H-15174 M.K. ORISEAL OR APPROVED EQUAL.
5. ALL WATER LINES ARE TO BE CONSTRUCTED 5.5 FEET FROM R.O.W. LINES.

THE SEAL APPEARING ON THIS DOCUMENT WAS AUTHORIZED BY W.L. DOUPHRATE, P.E. TEXAS P.E. NO. 60102 ON 11/25/96

DOUPHRATE & ASSOCIATES
ENGINEERING - SURVEYING - CONSTRUCTION MANAGEMENT
P.O. BOX 1336 ROCKWALL, TEXAS 75087
PHONE: (972)771-8688

WATER LINE PLAN
STERLING FARMS ADDITION
ROCKWALL COUNTY, TEXAS

REVISION	
CHECKED	WLD
DRAWN	ACAD
DATE	11-25-96
PROJECT	96002WP1