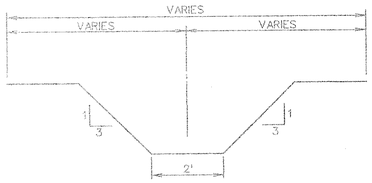

TYPICAL GRADE TO DRAIN SECTION

N.T.S.

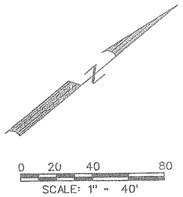

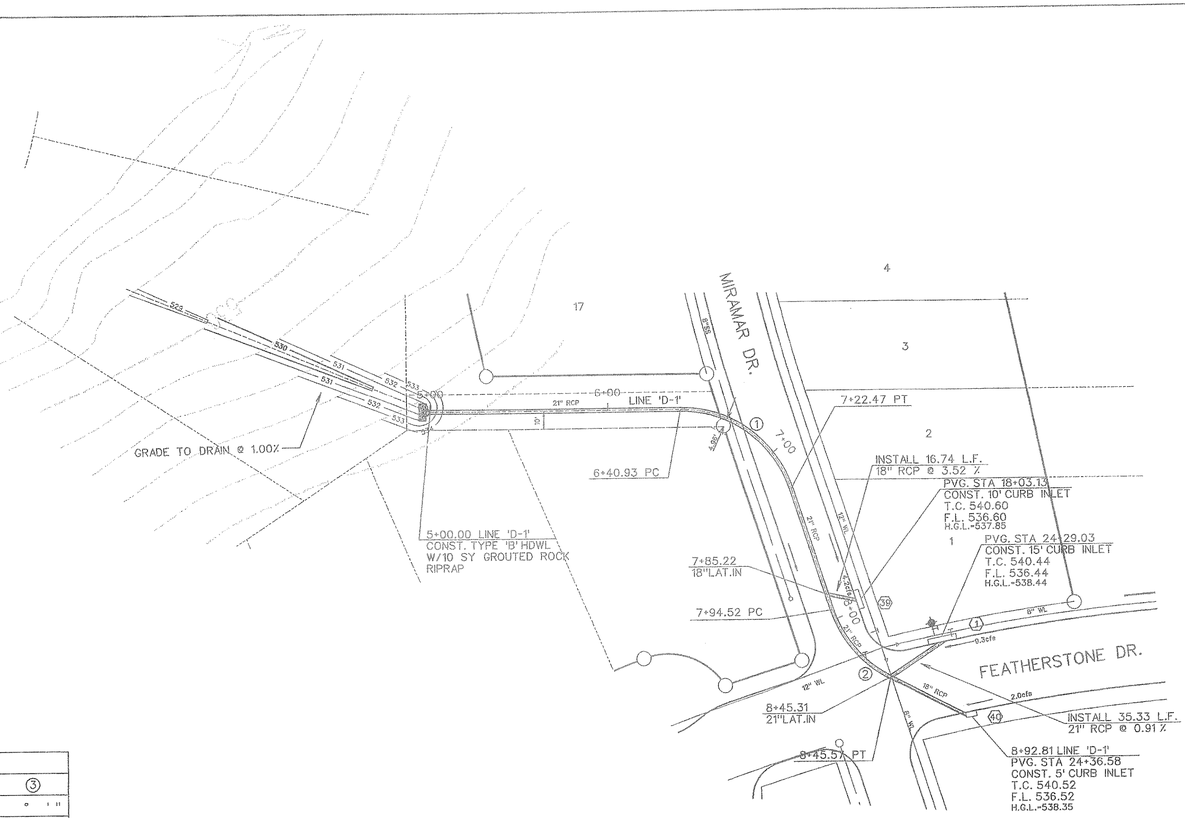

	CURVE DATA		
CURVE NO.	①	②	③
Δ	71° 52'06"	45° 00'00"	° ' "
R	65.00'	65.00'	'
T	47.11'	26.92'	'
L	81.53'	51.05'	'

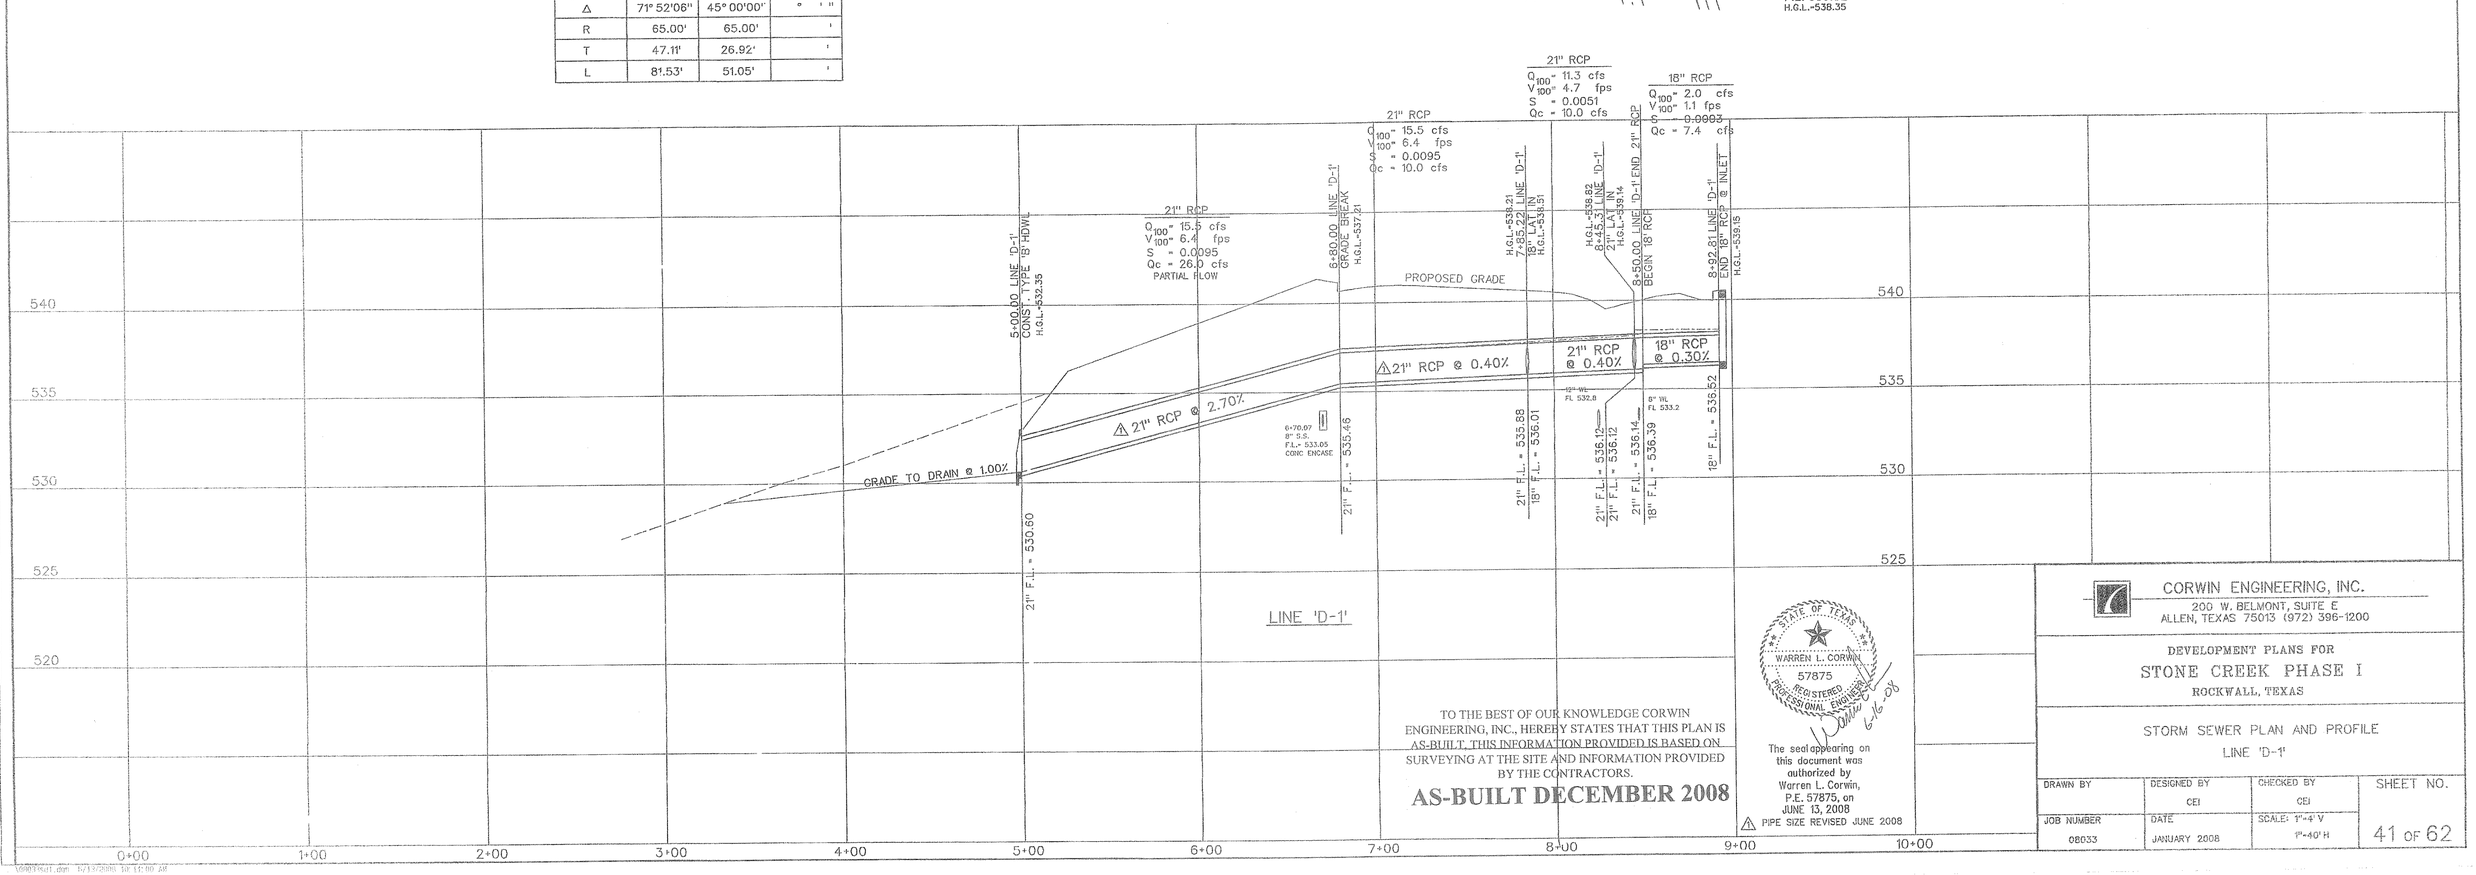

LINE 'D-1'

TO THE BEST OF OUR KNOWLEDGE CORWIN ENGINEERING, INC., HEREBY STATES THAT THIS PLAN IS AS-BUILT. THIS INFORMATION PROVIDED IS BASED ON SURVEYING AT THE SITE AND INFORMATION PROVIDED BY THE CONTRACTORS.

AS-BUILT DECEMBER 2008

STATE OF TEXAS
WARREN L. CORWIN
57875
REGISTERED PROFESSIONAL ENGINEER
6-16-08

The seal appearing on this document was authorized by Warren L. Corwin, P.E. 57875, on JUNE 13, 2008

⚠ PIPE SIZE REVISED JUNE 2008

CORWIN ENGINEERING, INC.
200 W. BELMONT, SUITE E
ALLEN, TEXAS 75013 (972) 396-1200

DEVELOPMENT PLANS FOR
STONE CREEK PHASE I
ROCKWALL, TEXAS

STORM SEWER PLAN AND PROFILE
LINE 'D-1'

DRAWN BY	DESIGNED BY	CHECKED BY	SHEET NO.
	CEI	CEI	41 OF 62
JOB NUMBER	DATE	SCALE: 1"=40' H, 1"=4' V	
08033	JANUARY 2008		

08033st1.dgn 6/13/2008 10:15:00 AM