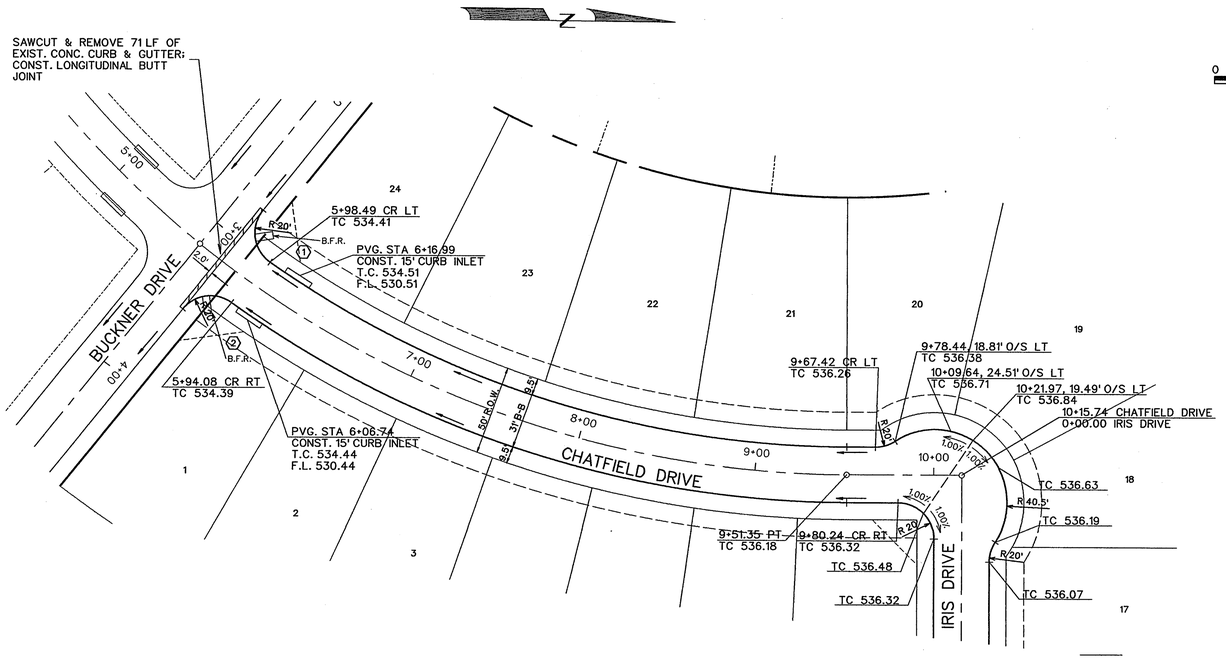

CHATFIELD DRIVE

0 20 40 80
SCALE: 1" = 40'

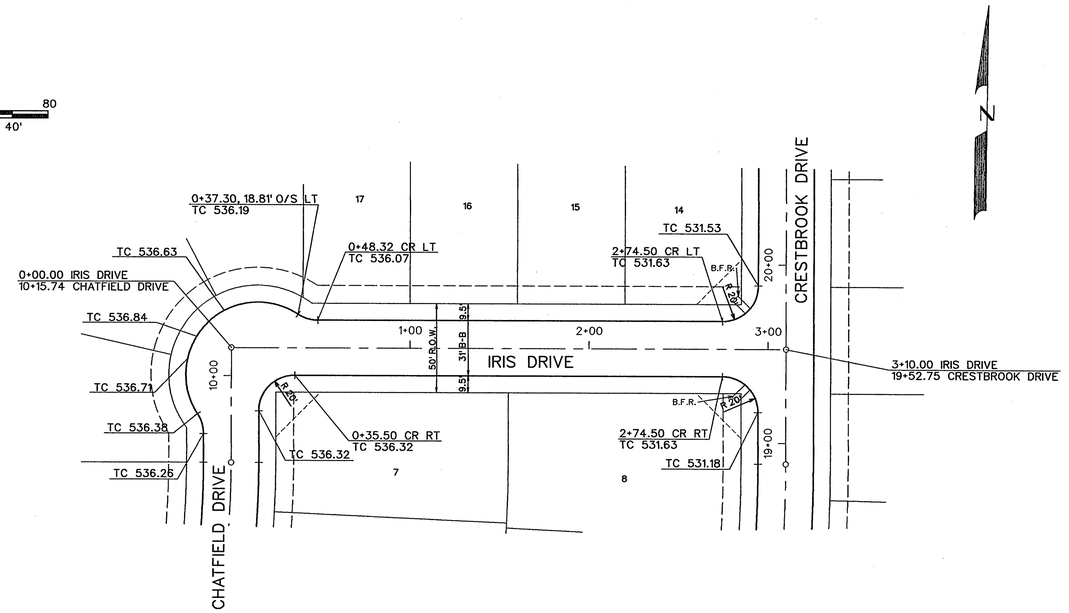

IRIS DRIVE

B.F.R. - BARRIER FREE RAMPS ARE ALL TRUNCATED DOME PLATES PER CITY SPECIFICATIONS

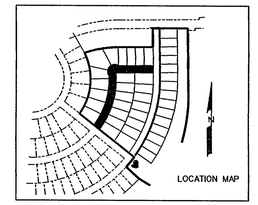

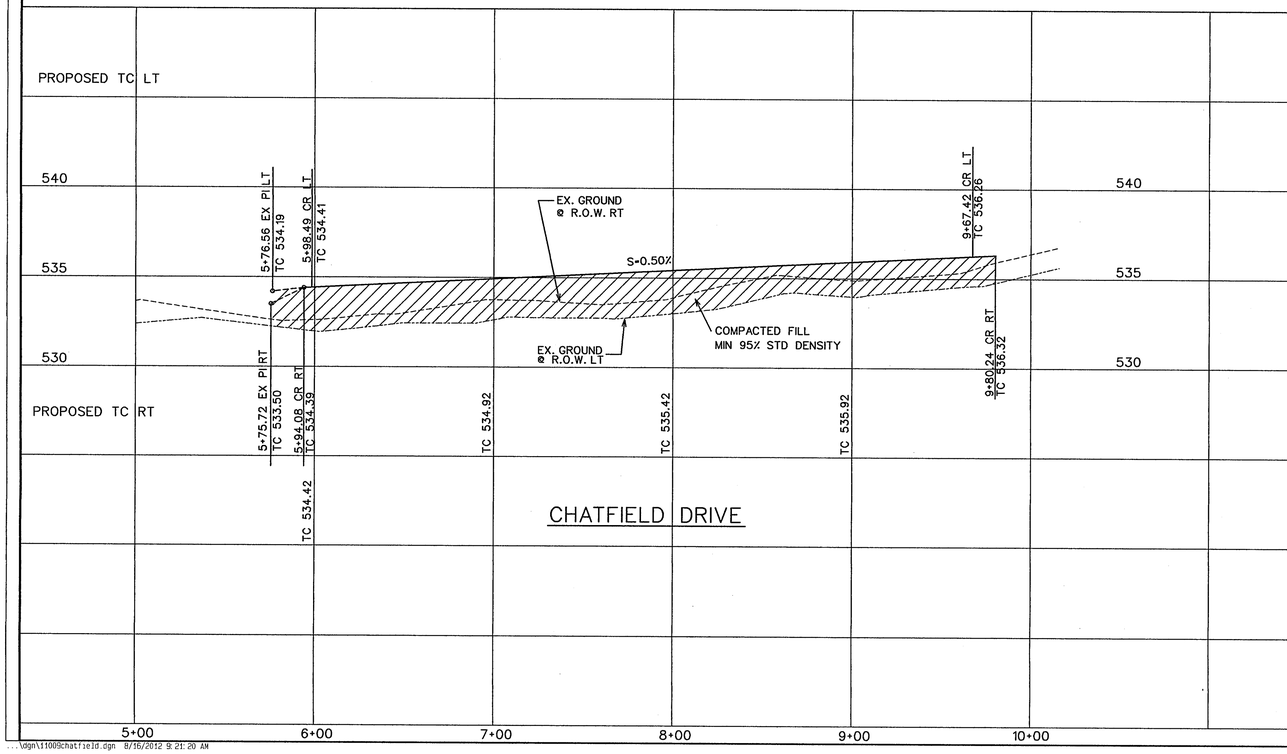

CHATFIELD DRIVE

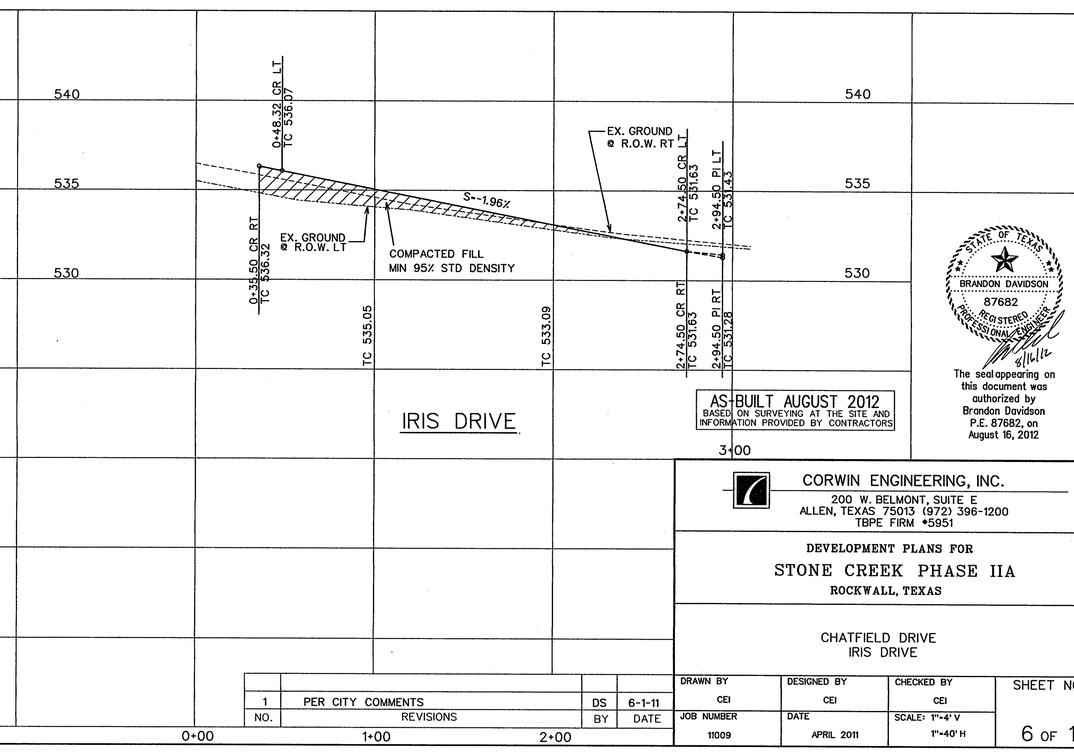

IRIS DRIVE

AS-BUILT AUGUST 2012
BASED ON SURVEYING AT THE SITE AND INFORMATION PROVIDED BY CONTRACTORS

STATE OF TEXAS
BRANDON DAVIDSON
87682
REGISTERED
PROFESSIONAL ENGINEER

The seal appearing on this document was authorized by Brandon Davidson P.E. 87682, on August 16, 2012

NO.	REVISIONS	BY	DATE
1	PER CITY COMMENTS	DS	6-1-11

CORWIN ENGINEERING, INC.
200 W. BELMONT, SUITE E
ALLEN, TEXAS 75013 (972) 396-1200
TBPE FIRM #5951

DEVELOPMENT PLANS FOR
STONE CREEK PHASE IIA
ROCKWALL, TEXAS

CHATFIELD DRIVE
IRIS DRIVE

DRAWN BY	DESIGNED BY	CHECKED BY	SHEET NO.
CEI	CEI	CEI	6 OF 11
JOB NUMBER	DATE	SCALE: 1"=4' V 1"=40' H	
11009	APRIL 2011		

...\dgn\11009chatfield.dgn 8/16/2012 9:21:20 AM