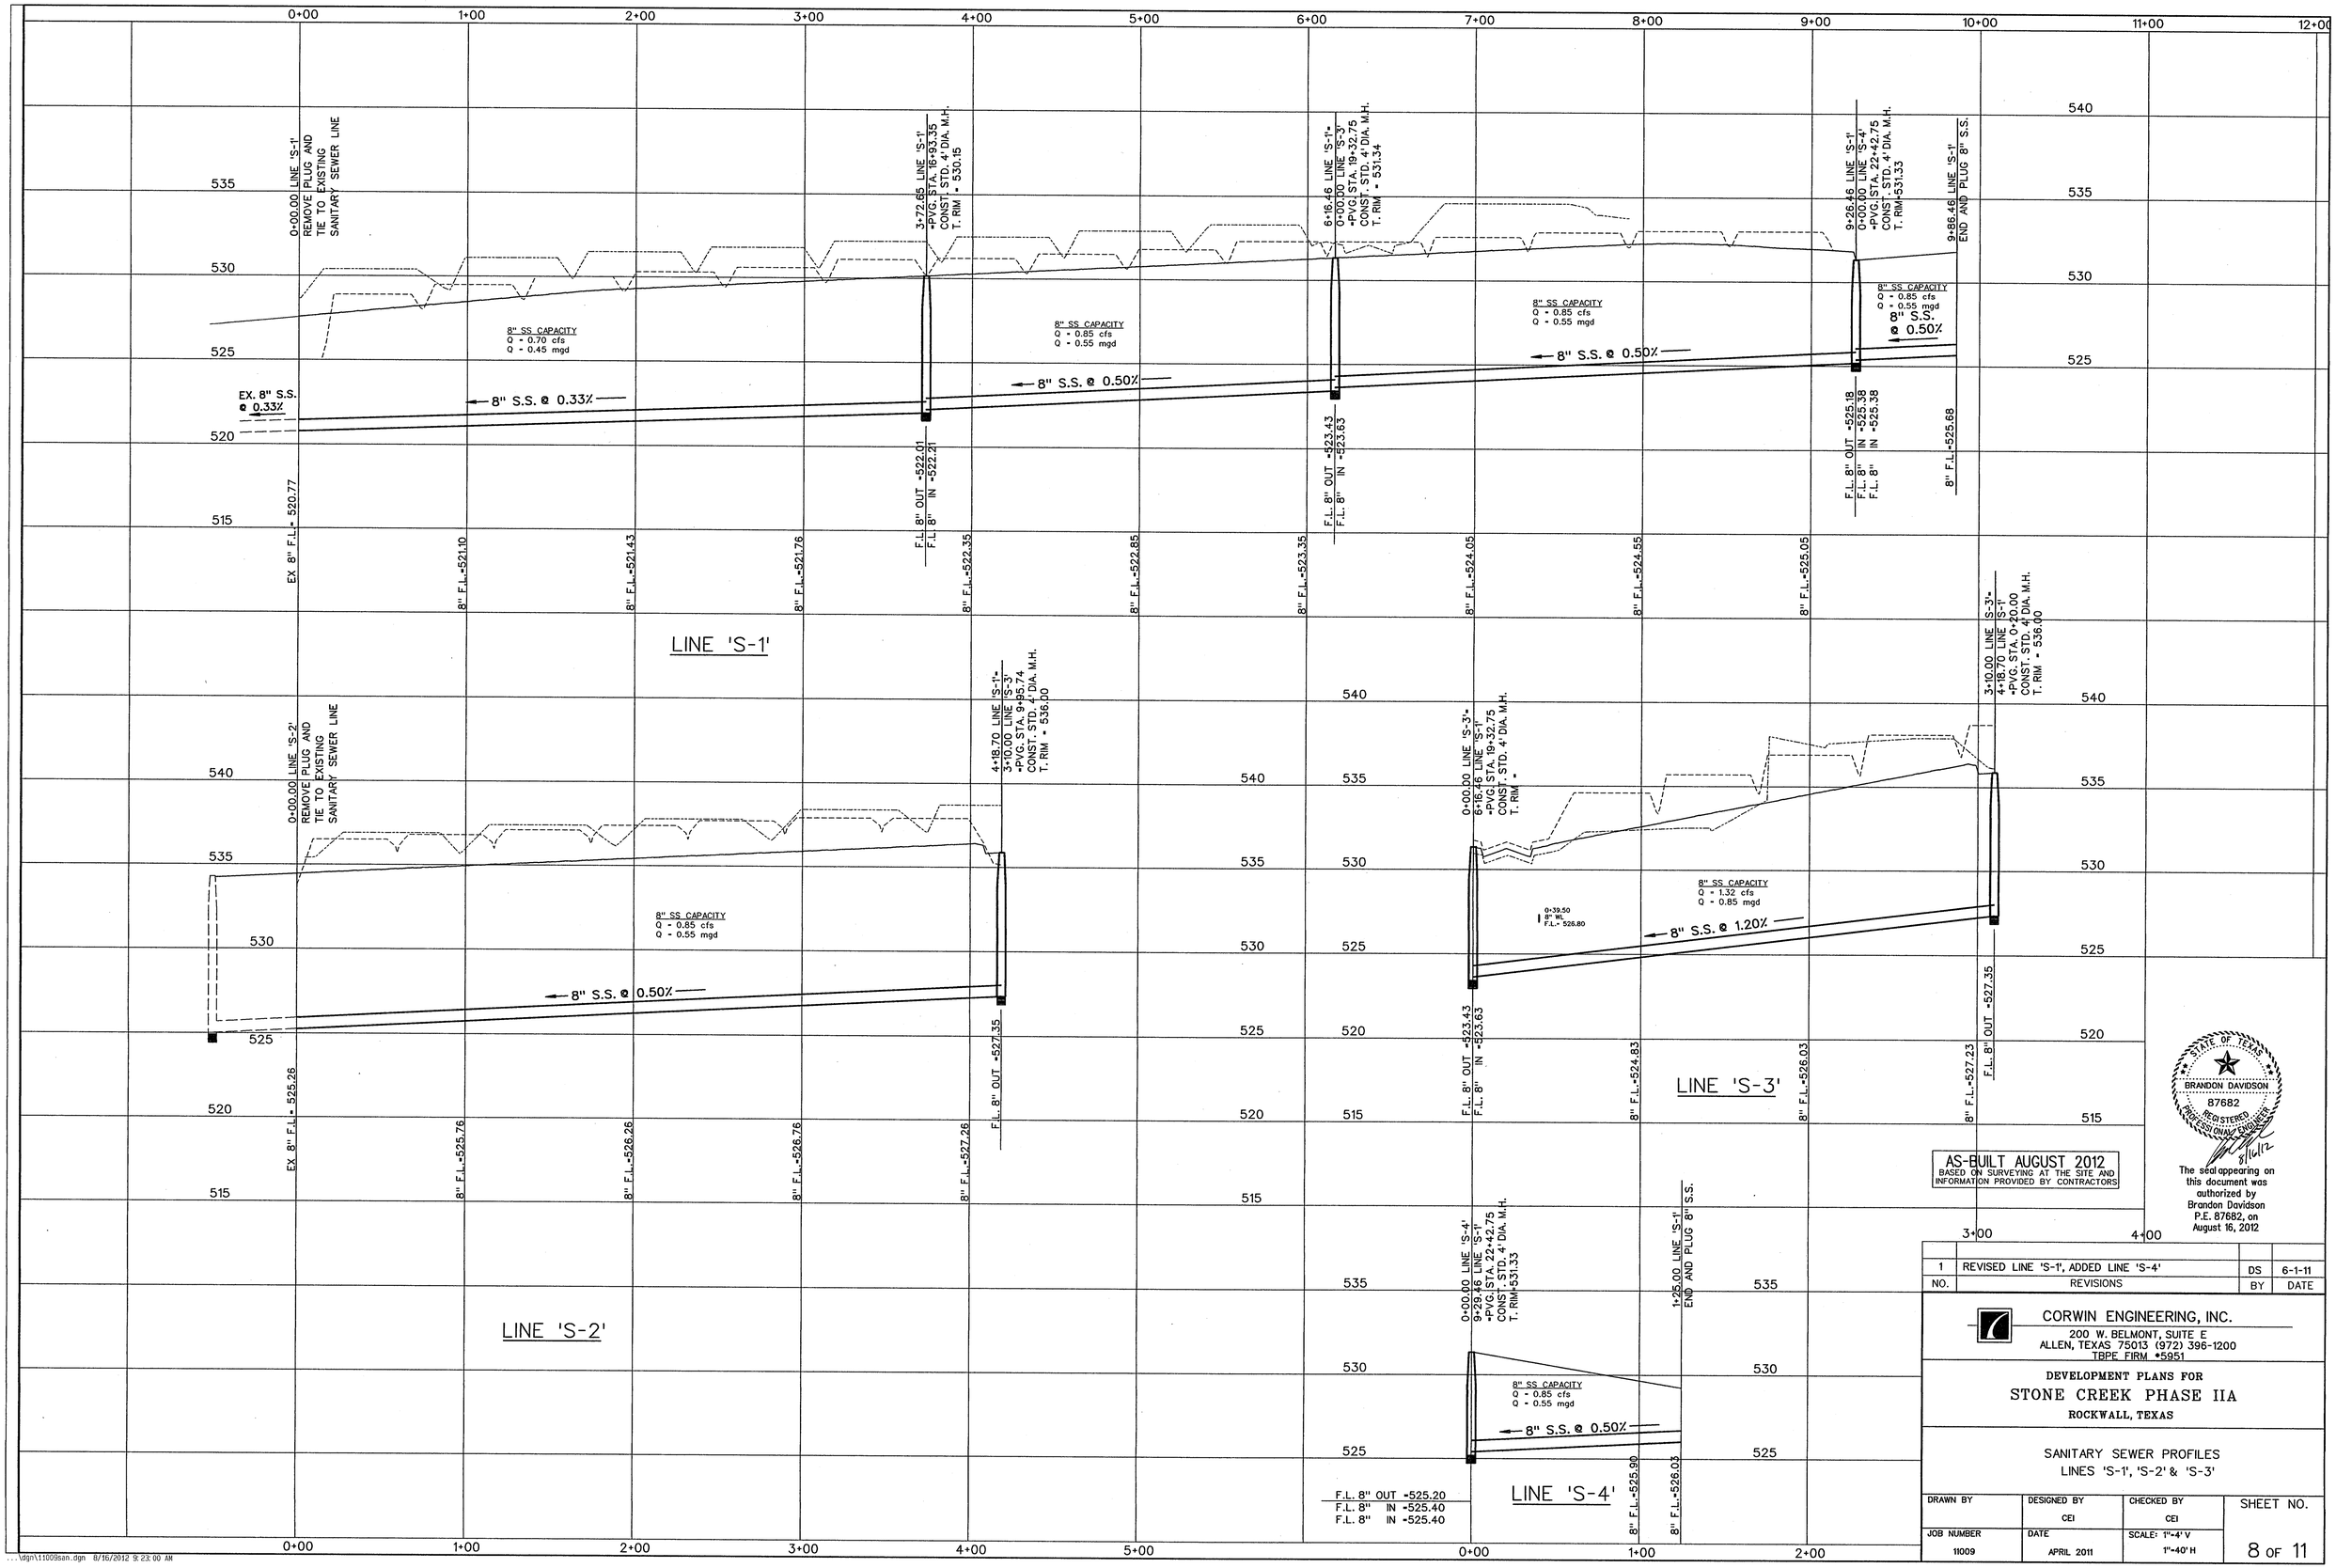

AS-BUILT AUGUST 2012
BASED ON SURVEYING AT THE SITE AND INFORMATION PROVIDED BY CONTRACTORS

STATE OF TEXAS
BRANDON DAVIDSON
87682
REGISTERED PROFESSIONAL ENGINEER
8/16/12

The seal appearing on this document was authorized by Brandon Davidson P.E. 87682, on August 16, 2012

NO.	REVISIONS	BY	DATE
1	REVISED LINE 'S-1', ADDED LINE 'S-4'	DS	6-1-11

CORWIN ENGINEERING, INC.
200 W. BELMONT, SUITE E
ALLEN, TEXAS 75013 (972) 396-1200
TBPE FIRM #5951

DEVELOPMENT PLANS FOR
STONE CREEK PHASE IIA
ROCKWALL, TEXAS

SANITARY SEWER PROFILES
LINES 'S-1', 'S-2' & 'S-3'

DRAWN BY	DESIGNED BY	CHECKED BY	SHEET NO.
	CEI	CEI	8 OF 11
JOB NUMBER	DATE	SCALE: 1"=4' V	
11009	APRIL 2011	1"=40' H	