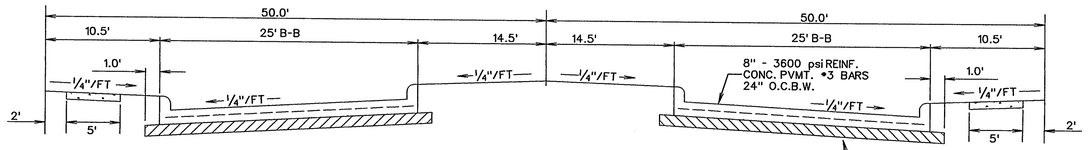

100' ROW TYPCAL PVMT.

N.T.S.

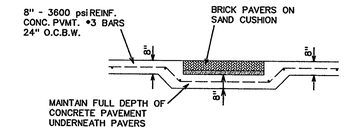

CROSS SECTION 'A-A'

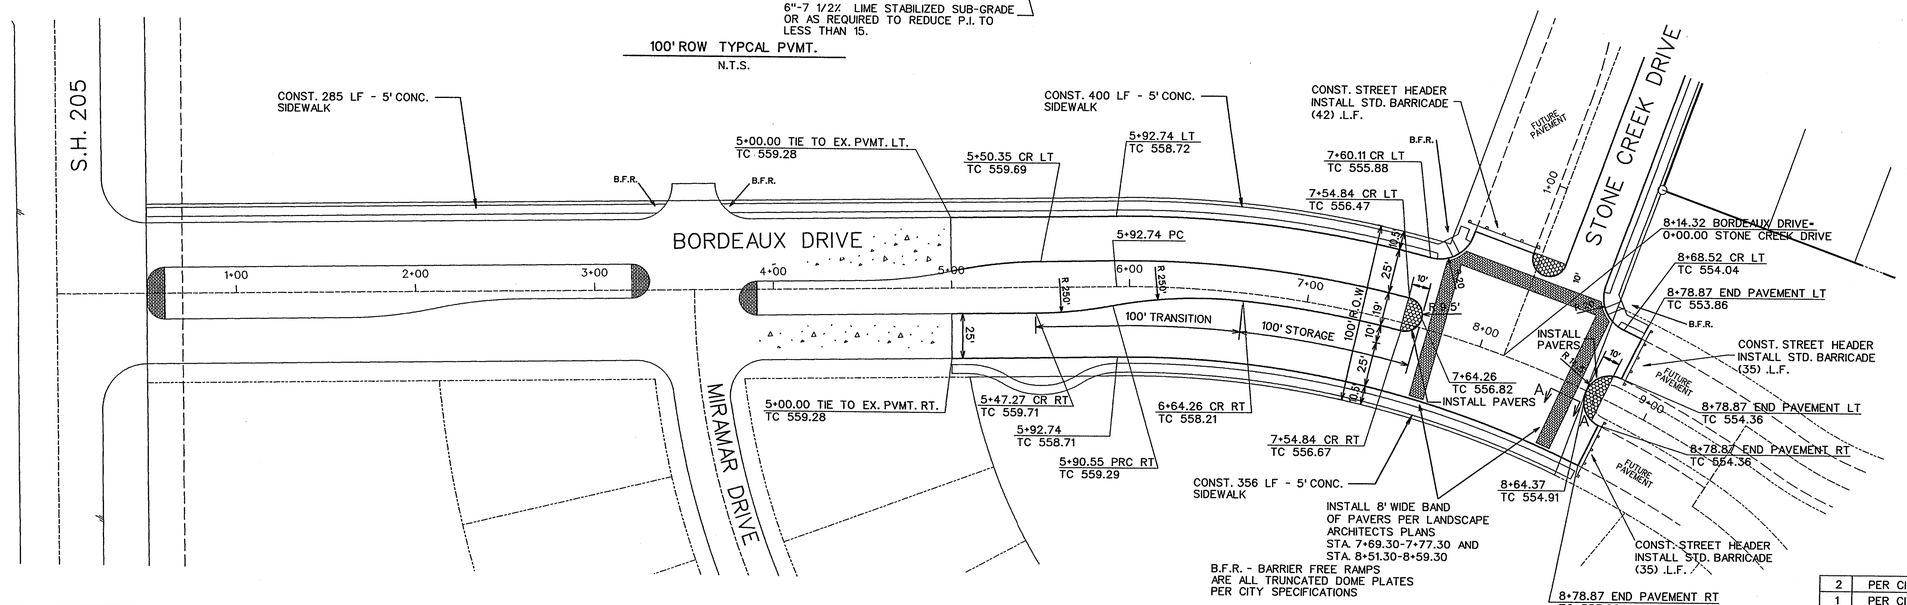

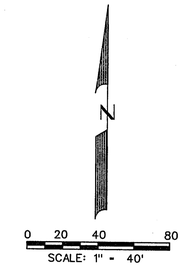

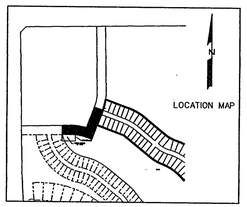

NO.	REVISIONS	BY	DATE
2	PER CITY COMMENTS	BD	6-24-11
1	PER CITY COMMENTS	DS	6-1-11

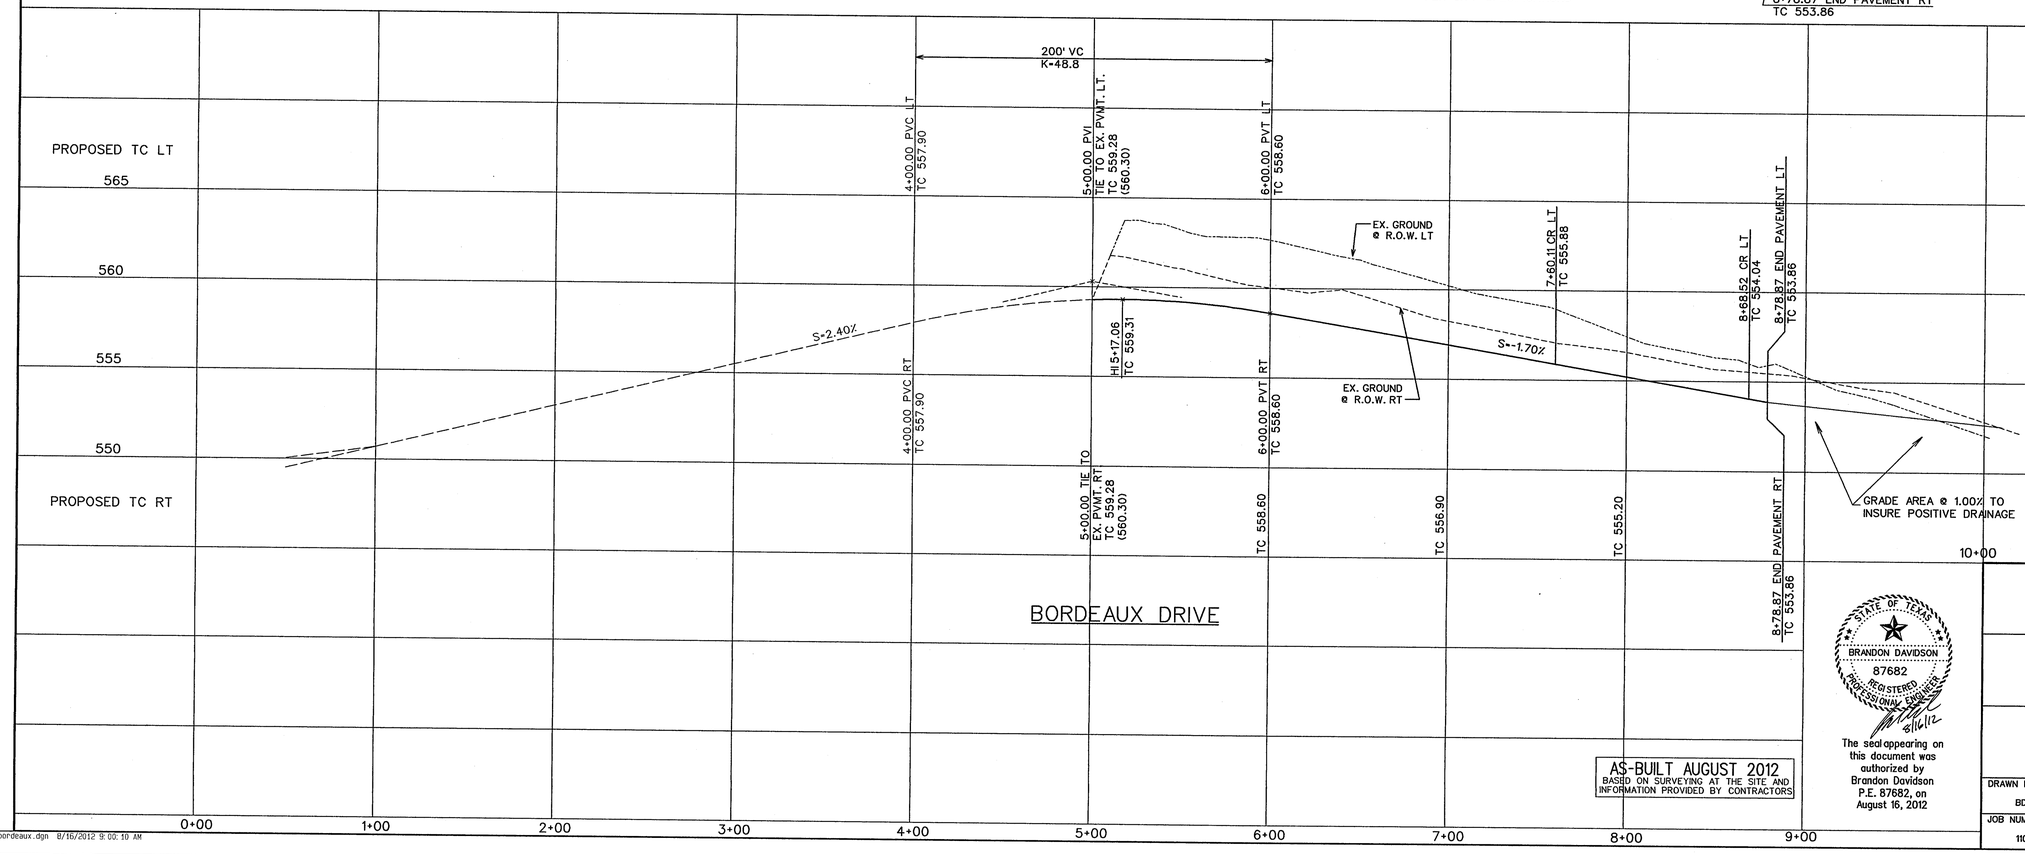

AS-BUILT AUGUST 2012
BASED ON SURVEYING AT THE SITE AND INFORMATION PROVIDED BY CONTRACTORS

STATE OF TEXAS
BRANDON DAVIDSON
87682
REGISTERED PROFESSIONAL ENGINEER
8/16/12

The seal appearing on this document was authorized by Brandon Davidson P.E. 87682, on August 16, 2012

CORWIN ENGINEERING, INC.
200 W. BELMONT, SUITE E
ALLEN, TEXAS 75013 (972)396-1200
TBPE FIRM #5951

DEVELOPMENT PLANS FOR

STONE CREEK PHASE IIB

ROCKWALL, TEXAS

BORDEAUX DRIVE

DRAWN BY	DESIGNED BY	CHECKED BY	SHEET NO.
BDD	BDD	BDD	4 OF 13
JOB NUMBER 11010	DATE APRIL 2011	SCALE: HOR: 1"=40' VER: 1"=4'	

...\dgn\11010bordeaux.dgn 8/16/2012 9:00:10 AM