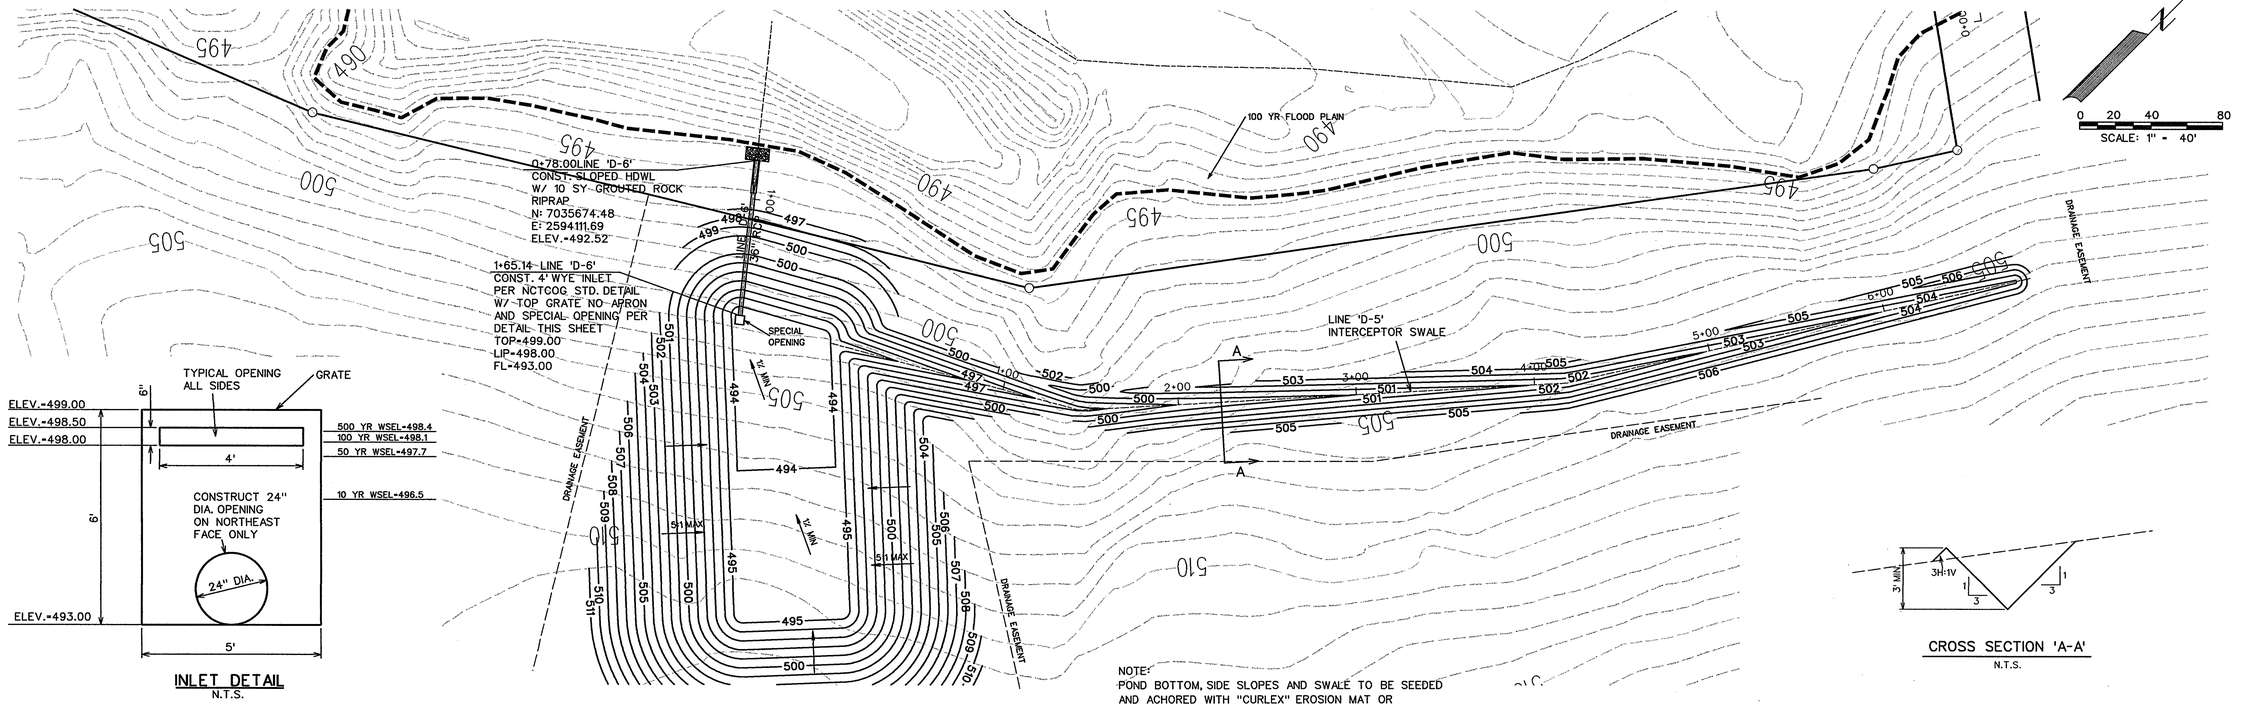

INLET DETAIL
N.T.S.

CROSS SECTION 'A-A'
N.T.S.

NOTE:
POND BOTTOM, SIDE SLOPES AND SWALE TO BE SEEDED AND ACHORED WITH "CURLEX" EROSION MAT OR APPROVED EQUAL, PRIOR TO ANY PAVING.

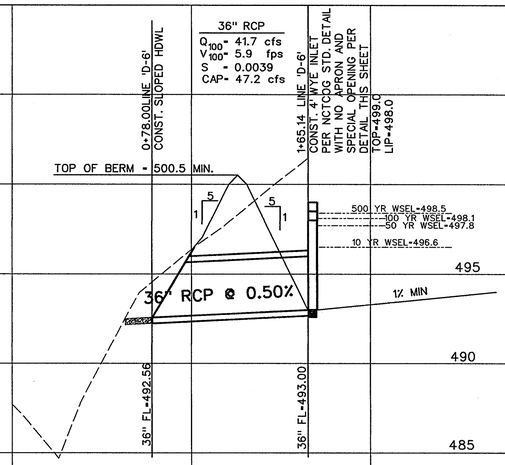

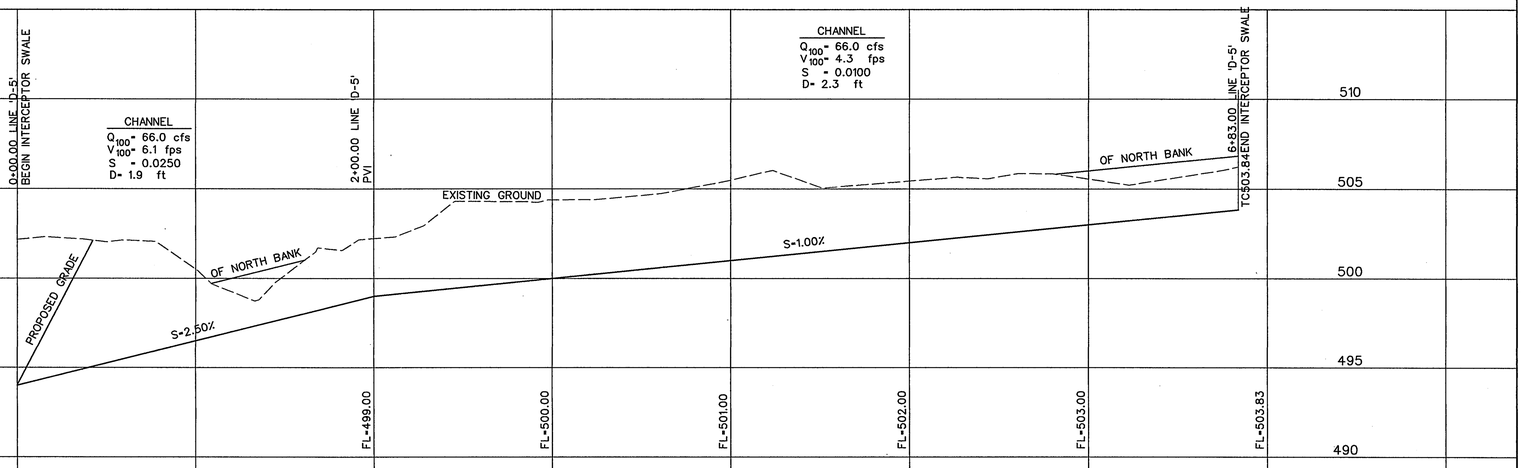

AS-BUILT JANUARY 2014
INFORMATION PROVIDED BY CONTRACTORS (NOT FIELD VERIFIED)

STATE OF TEXAS
BRANDON DAVIDSON
87682
REGISTERED PROFESSIONAL ENGINEER
1/23/14

The seal appearing on this document was authorized by Brandon Davidson P.E. 87682, on January 23, 2014

CORWIN ENGINEERING, INC.
200 W. BELMONT, SUITE E
ALLEN, TEXAS 75013 (972)396-1200
TBPE FIRM #5951

DEVELOPMENT PLANS FOR
STONE CREEK PHASE IV
ROCKWALL, TEXAS

STORM SEWER PLAN AND PROFILE
LINE 'D-5' & 'D-6'

DRAWN BY	DESIGNED BY	CHECKED BY	SHEET NO.
	BDD	BDD	15 OF 18
JOB NUMBER	DATE	SCALE: HOR: 1"=40' VER: 1"=4'	
12033	SEPTEMBER 2012		

...\dgn\12033_sd4.dgn 1/23/2014 2:01:23 PM