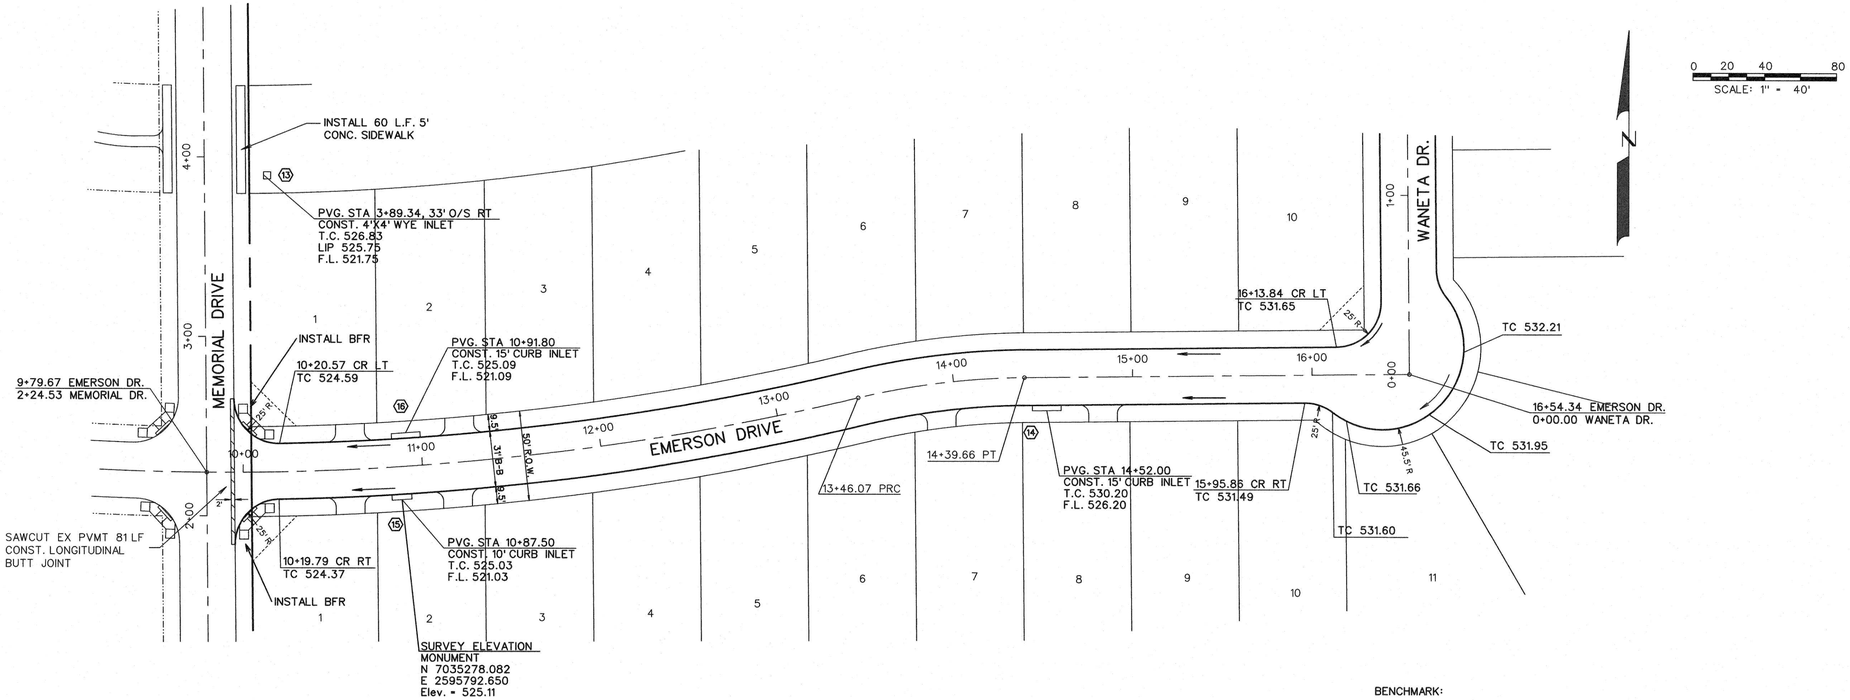

BENCHMARK:

CITY OF ROCKWALL SURVEY MONUMENT ON AN INLET AT THE NORTHWEST CORNER OF FEATHERSTONE DR. AND HARVARD DR.

ELEV.= 525.31

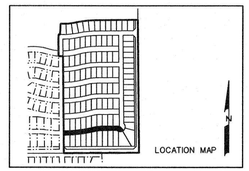

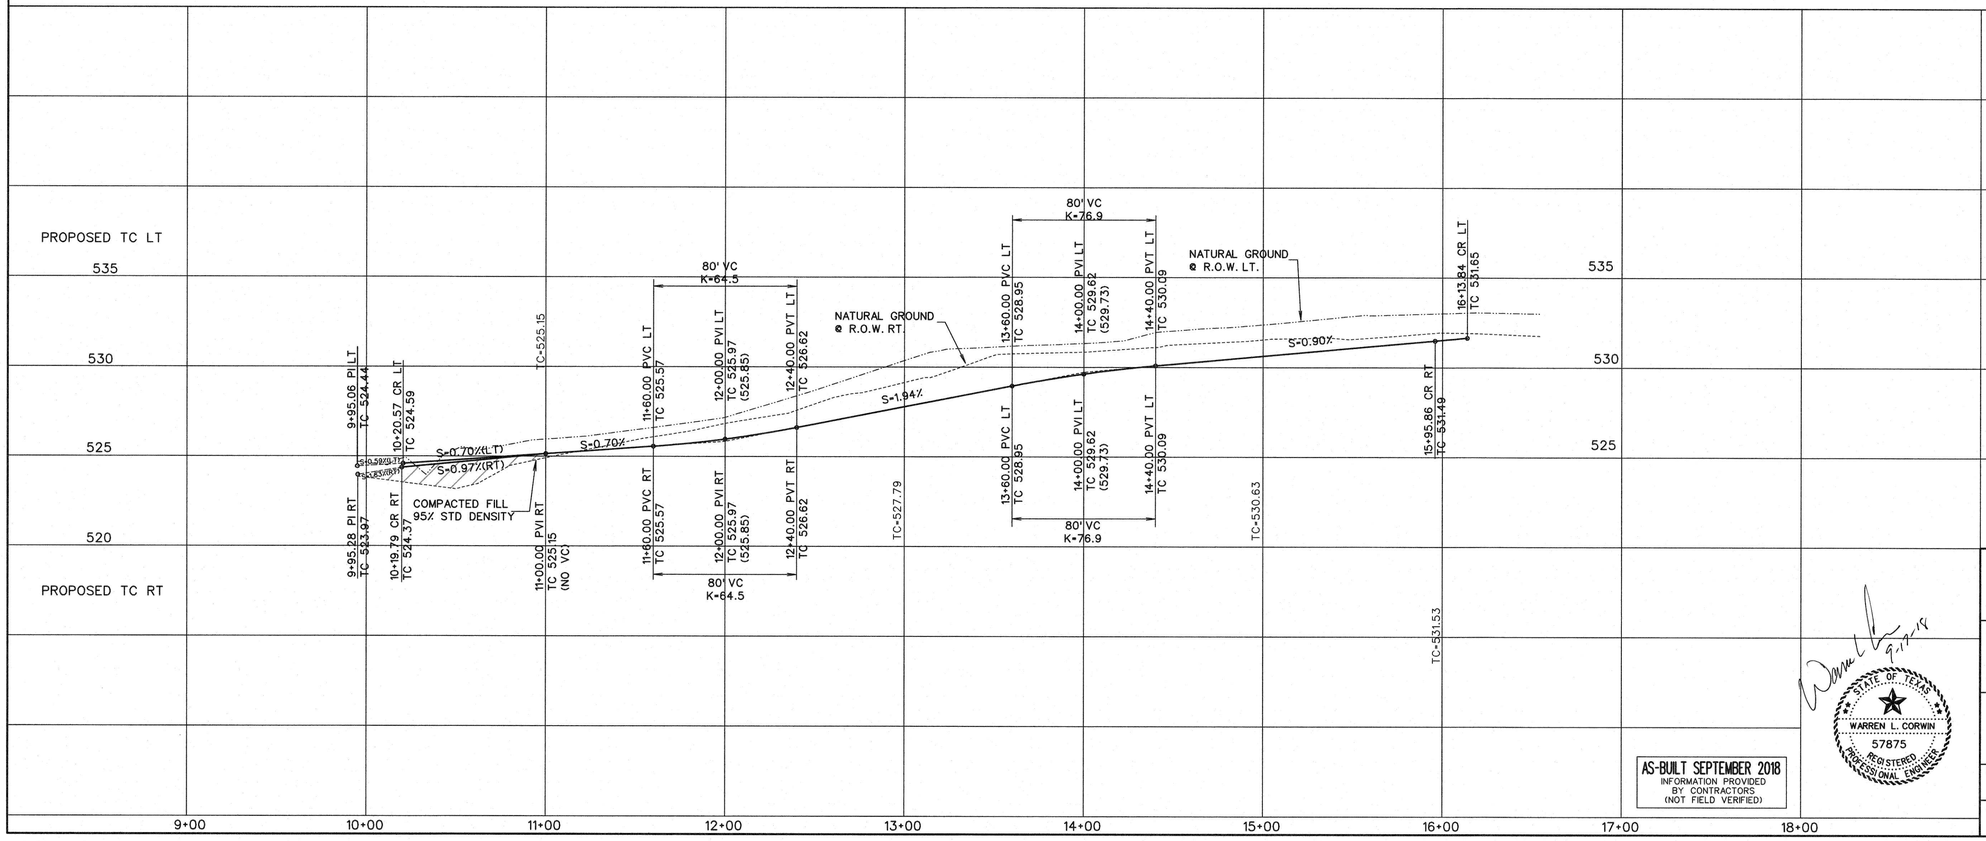

AS-BUILT SEPTEMBER 2018
INFORMATION PROVIDED BY CONTRACTORS (NOT FIELD VERIFIED)

STATE OF TEXAS
WARREN L. CORWIN
57875
REGISTERED PROFESSIONAL ENGINEER
9-7-18

CORWIN ENGINEERING, INC.
200 W. BELMONT, SUITE E
ALLEN, TEXAS 75013 (972)396-1200
TBPE FIRM #5951

DEVELOPMENT PLANS FOR
STONE CREEK
PHASE VIII
ROCKWALL, TEXAS

EMERSON DRIVE

DRAWN BY	DESIGNED BY	CHECKED BY	SHEET NO.
JOB NUMBER 16044	DATE OCTOBER 2016	SCALE: HOR: 1"=40' VER: 1"=4'	3 OF 32