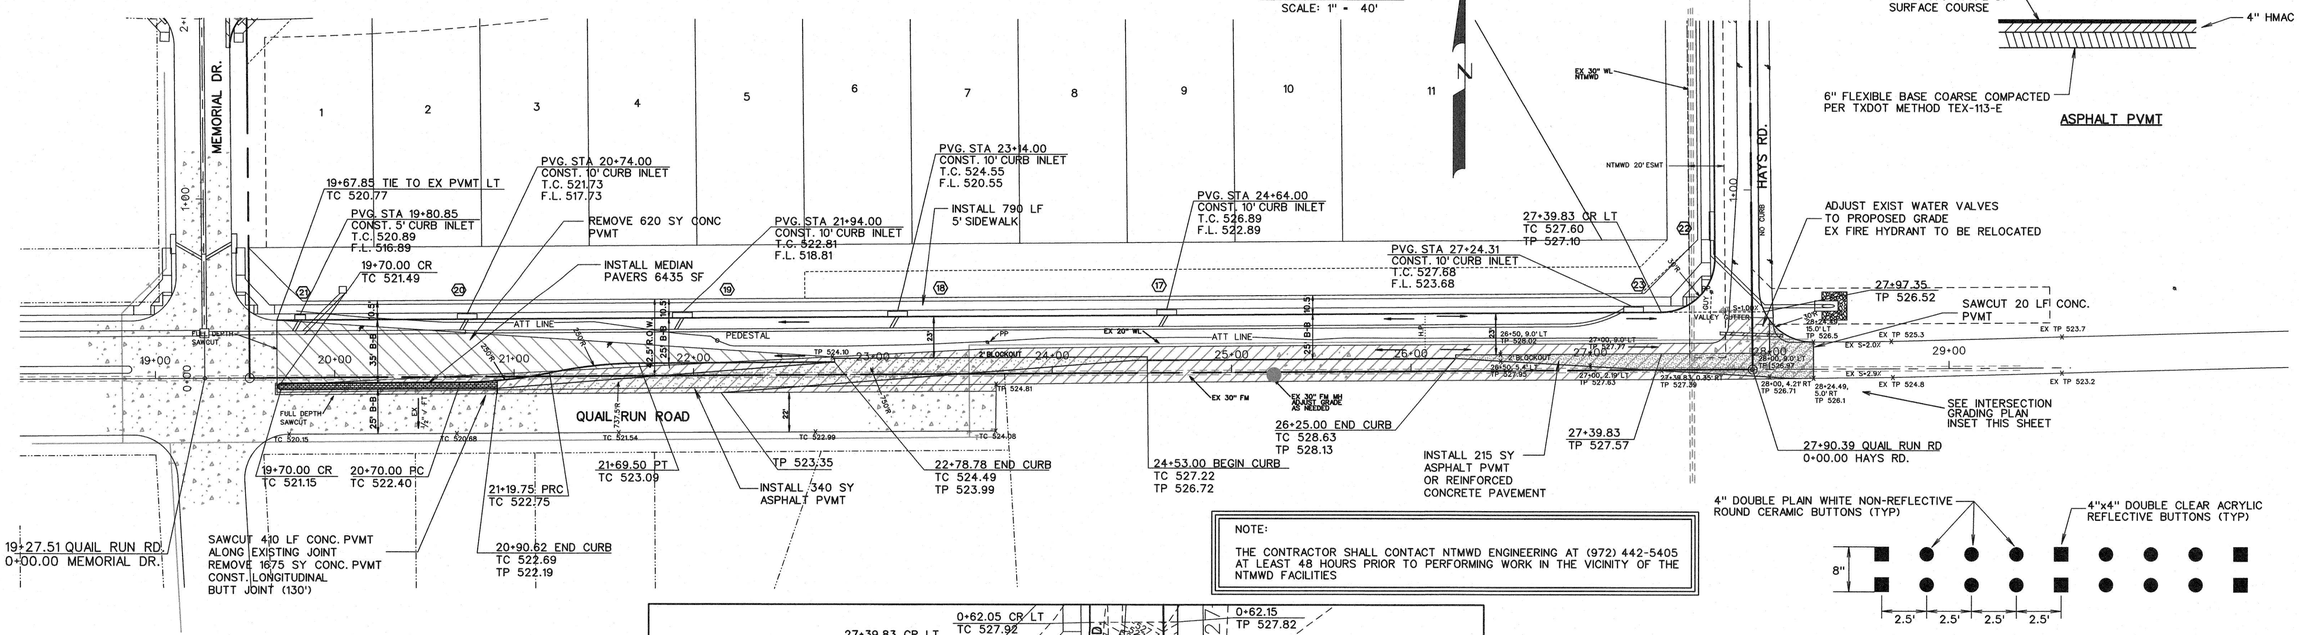

NOTE:

THE CONTRACTOR SHALL CONTACT NTMWD ENGINEERING AT (972) 442-5405 AT LEAST 48 HOURS PRIOR TO PERFORMING WORK IN THE VICINITY OF THE NTMWD FACILITIES

BUTTON TURN BAY LINE MARKING DETAIL
N.T.S

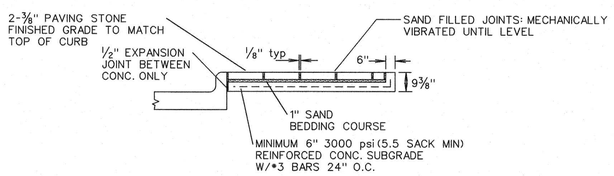

MEDIAN PAVING STONE DETAIL
N.T.S.

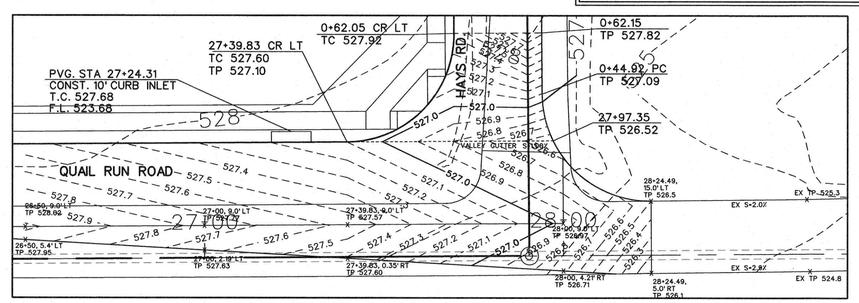

INTERSECTION GRADING PLAN
SCALE:1"=20'

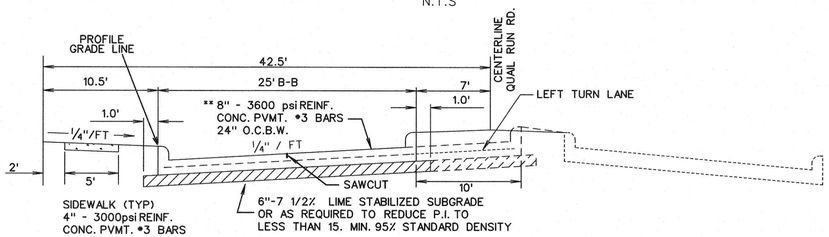

N.T.S.

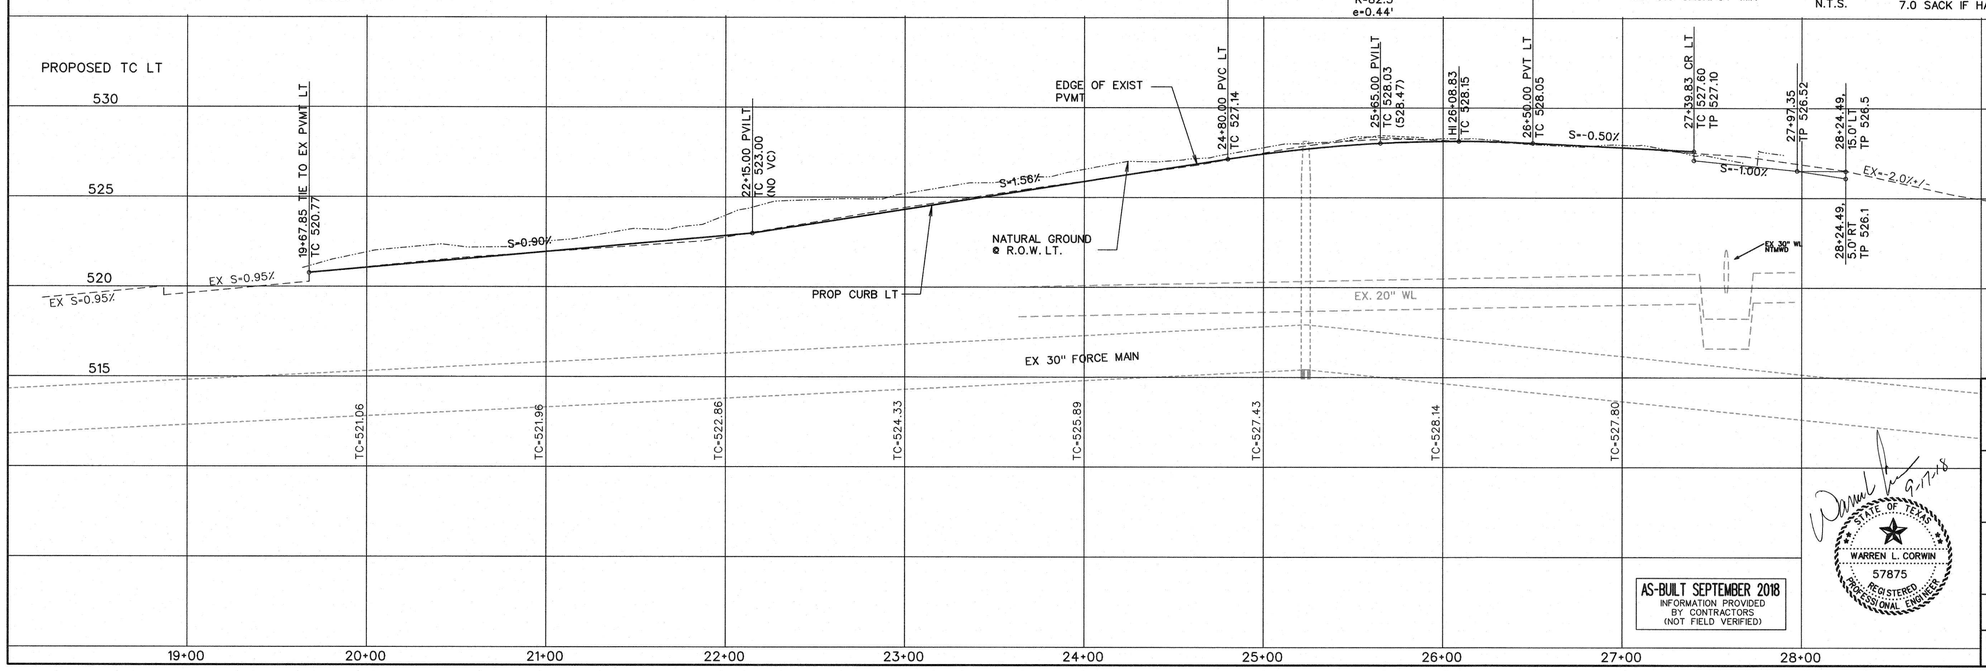

AS-BUILT SEPTEMBER 2018
INFORMATION PROVIDED BY CONTRACTORS (NOT FIELD VERIFIED)

STATE OF TEXAS
WARREN L. CORWIN
57875
REGISTERED PROFESSIONAL ENGINEER
9.7.18

CORWIN ENGINEERING, INC.
200 W. BELMONT, SUITE E
ALLEN, TEXAS 75013 (972)396-1200
TBPE FIRM #5951

DEVELOPMENT PLANS FOR
STONE CREEK
PHASE VIII
ROCKWALL, TEXAS

QUAIL RUN ROAD

DRAWN BY	DESIGNED BY	CHECKED BY	SHEET NO.
JOB NUMBER 16044	DATE OCTOBER 2016	SCALE: HOR: 1"=40' VER: 1"=4'	8 OF 32