A.F. 7324

ESTIMATES		
Material	Quantity	Unit
Concrete Paving	590	S.Y.
Saw Cut & Remove Curb	11	S.Y.

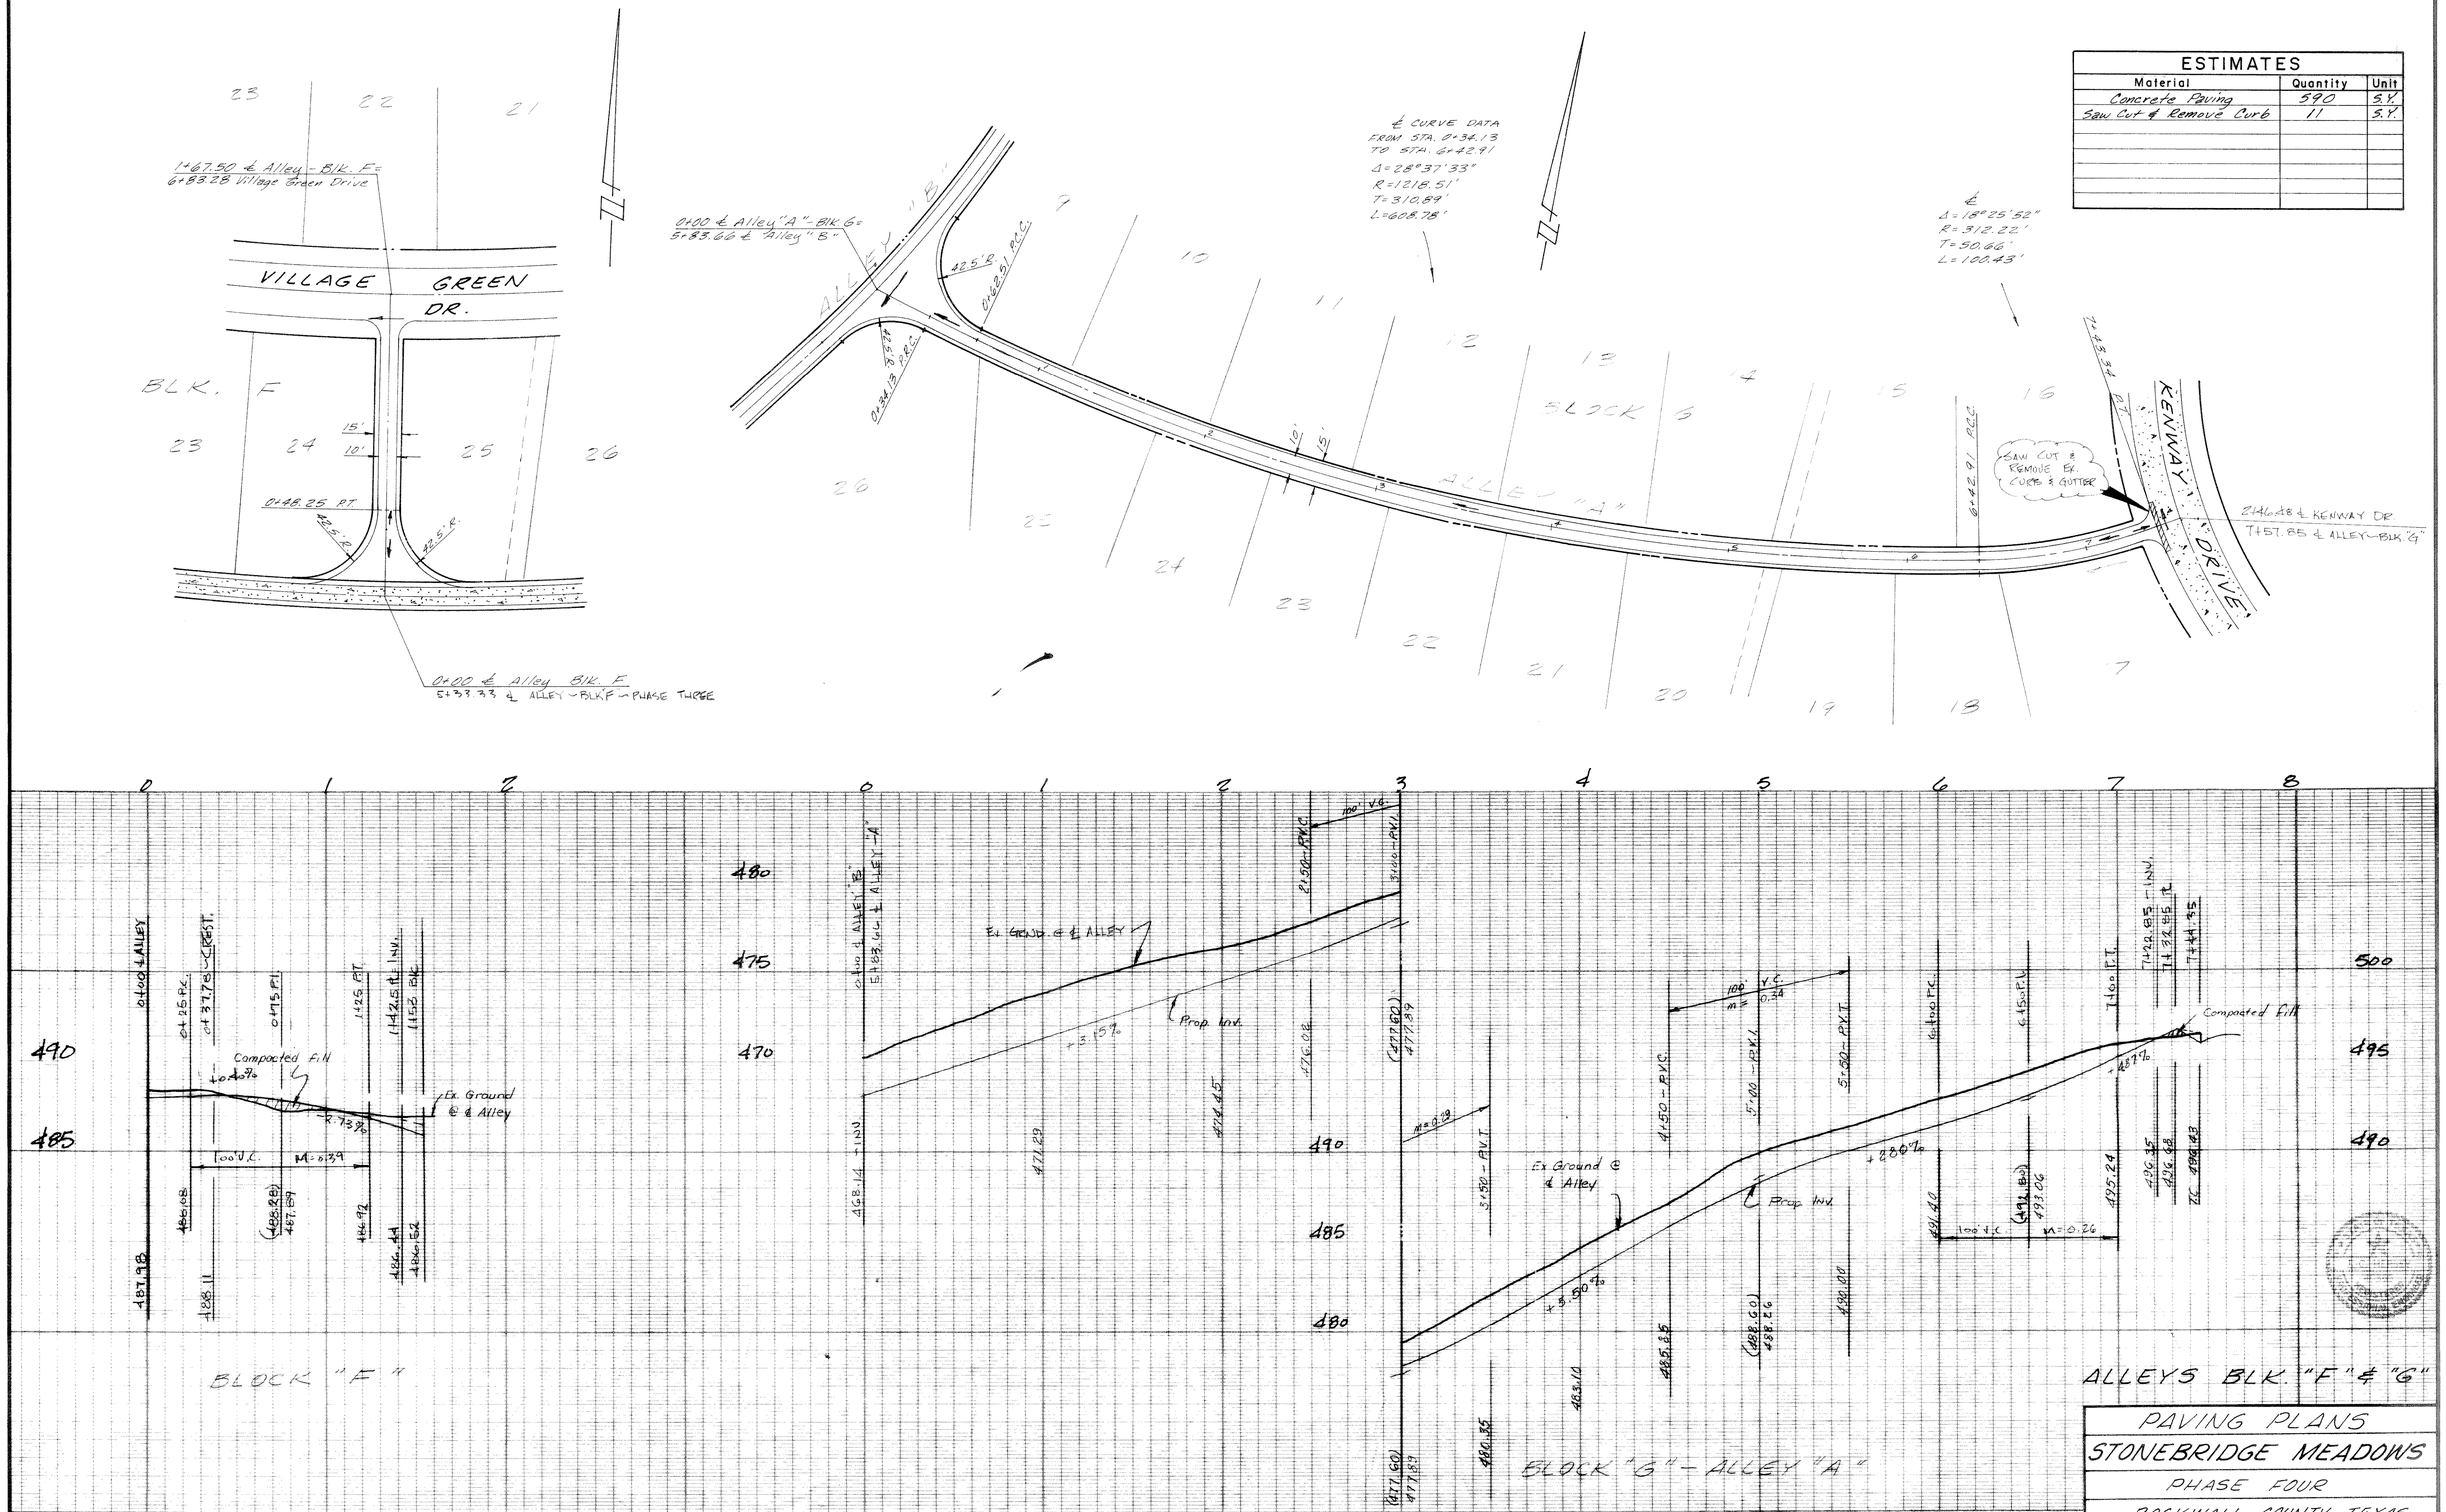

NO.	DATE	BY	REVISION
1	12/18/78	JLS	Lowered grades in Alley "A"

BENCH MARK: Top South Flange Bolt F.H.-East Side of Lake Shore Dr. (200+- North of North Property Line of Stonebridge #1) Elev. 454.36

PAVING PLANS
STONEBRIDGE MEADOWS
PHASE FOUR
ROCKWALL COUNTY, TEXAS

THREADGILL - DOWDEY and ASSOCIATES
CONSULTING ENGINEERS DALLAS, TEXAS

DESIGN	DRAWN	CHECKED	DATE	SCALE	JOB	SHEET
J.G.B.	R.E.	J.C.H.	9-78	1"=40'H 1"=4'V	506-E	3/5

PLATE No. 4