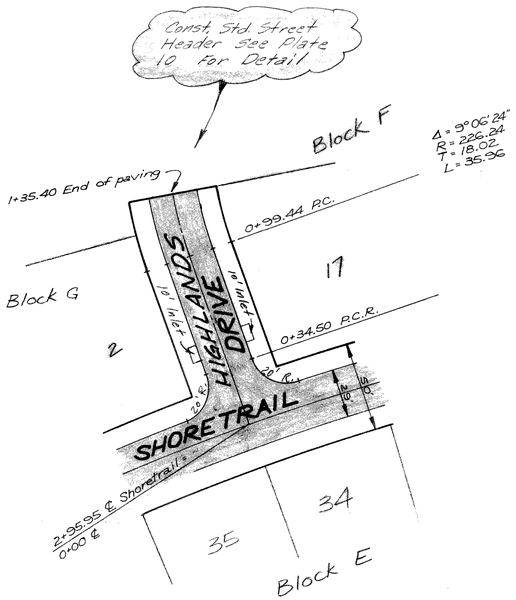

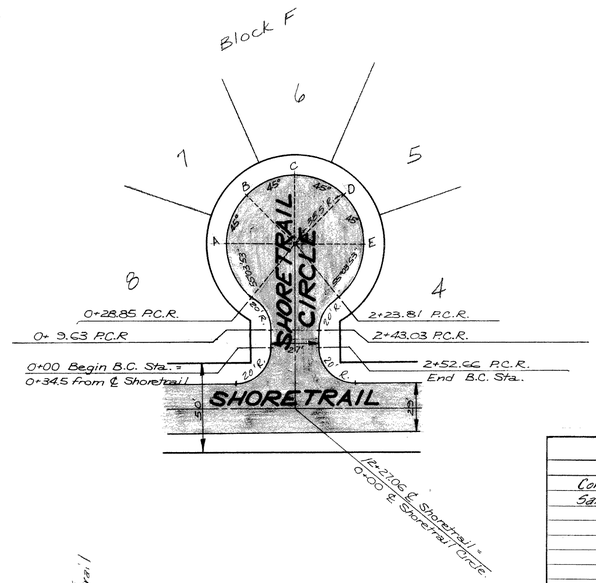

ESTIMATES		
Material	Quantity	Unit
Concrete Paving	1070	Sq. Yd.
Sand Bedding	60	Cu. Yd.

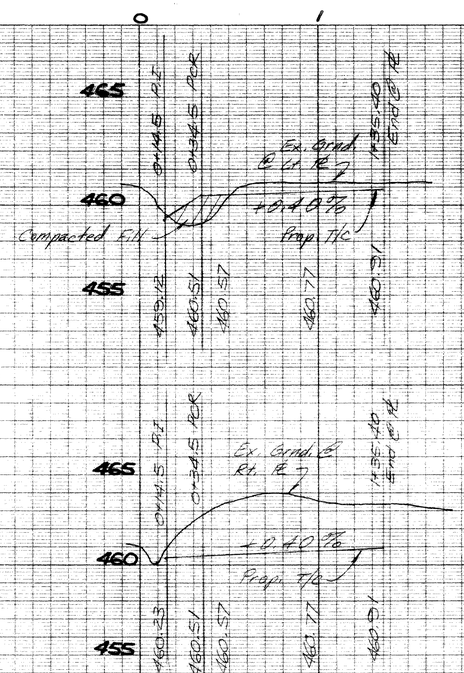

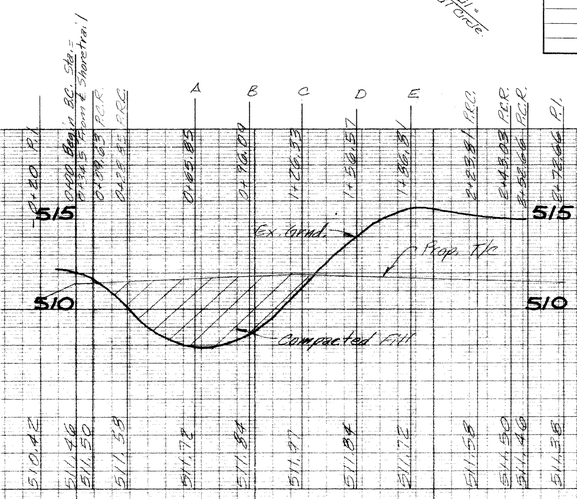

BENCH MARK: Nail in power pole, inside of exist. Shoretrail, 40' E. of ℄ of Stonebridge #3 @ Alley

PAVING PLANS

STONEBRIDGE MEADOWS

PHASE THREE

ROCKWALL COUNTY, TEXAS

THREADGILL - DOWDEY and ASSOCIATES
CONSULTING ENGINEERS DALLAS, TEXAS

DESIGN	DRAWN	CHECKED	DATE	SCALE	JOB	SHEET
ARW	HTM	JCH	6-77	1"=40'	472-E	3/3

PLATE No. 4