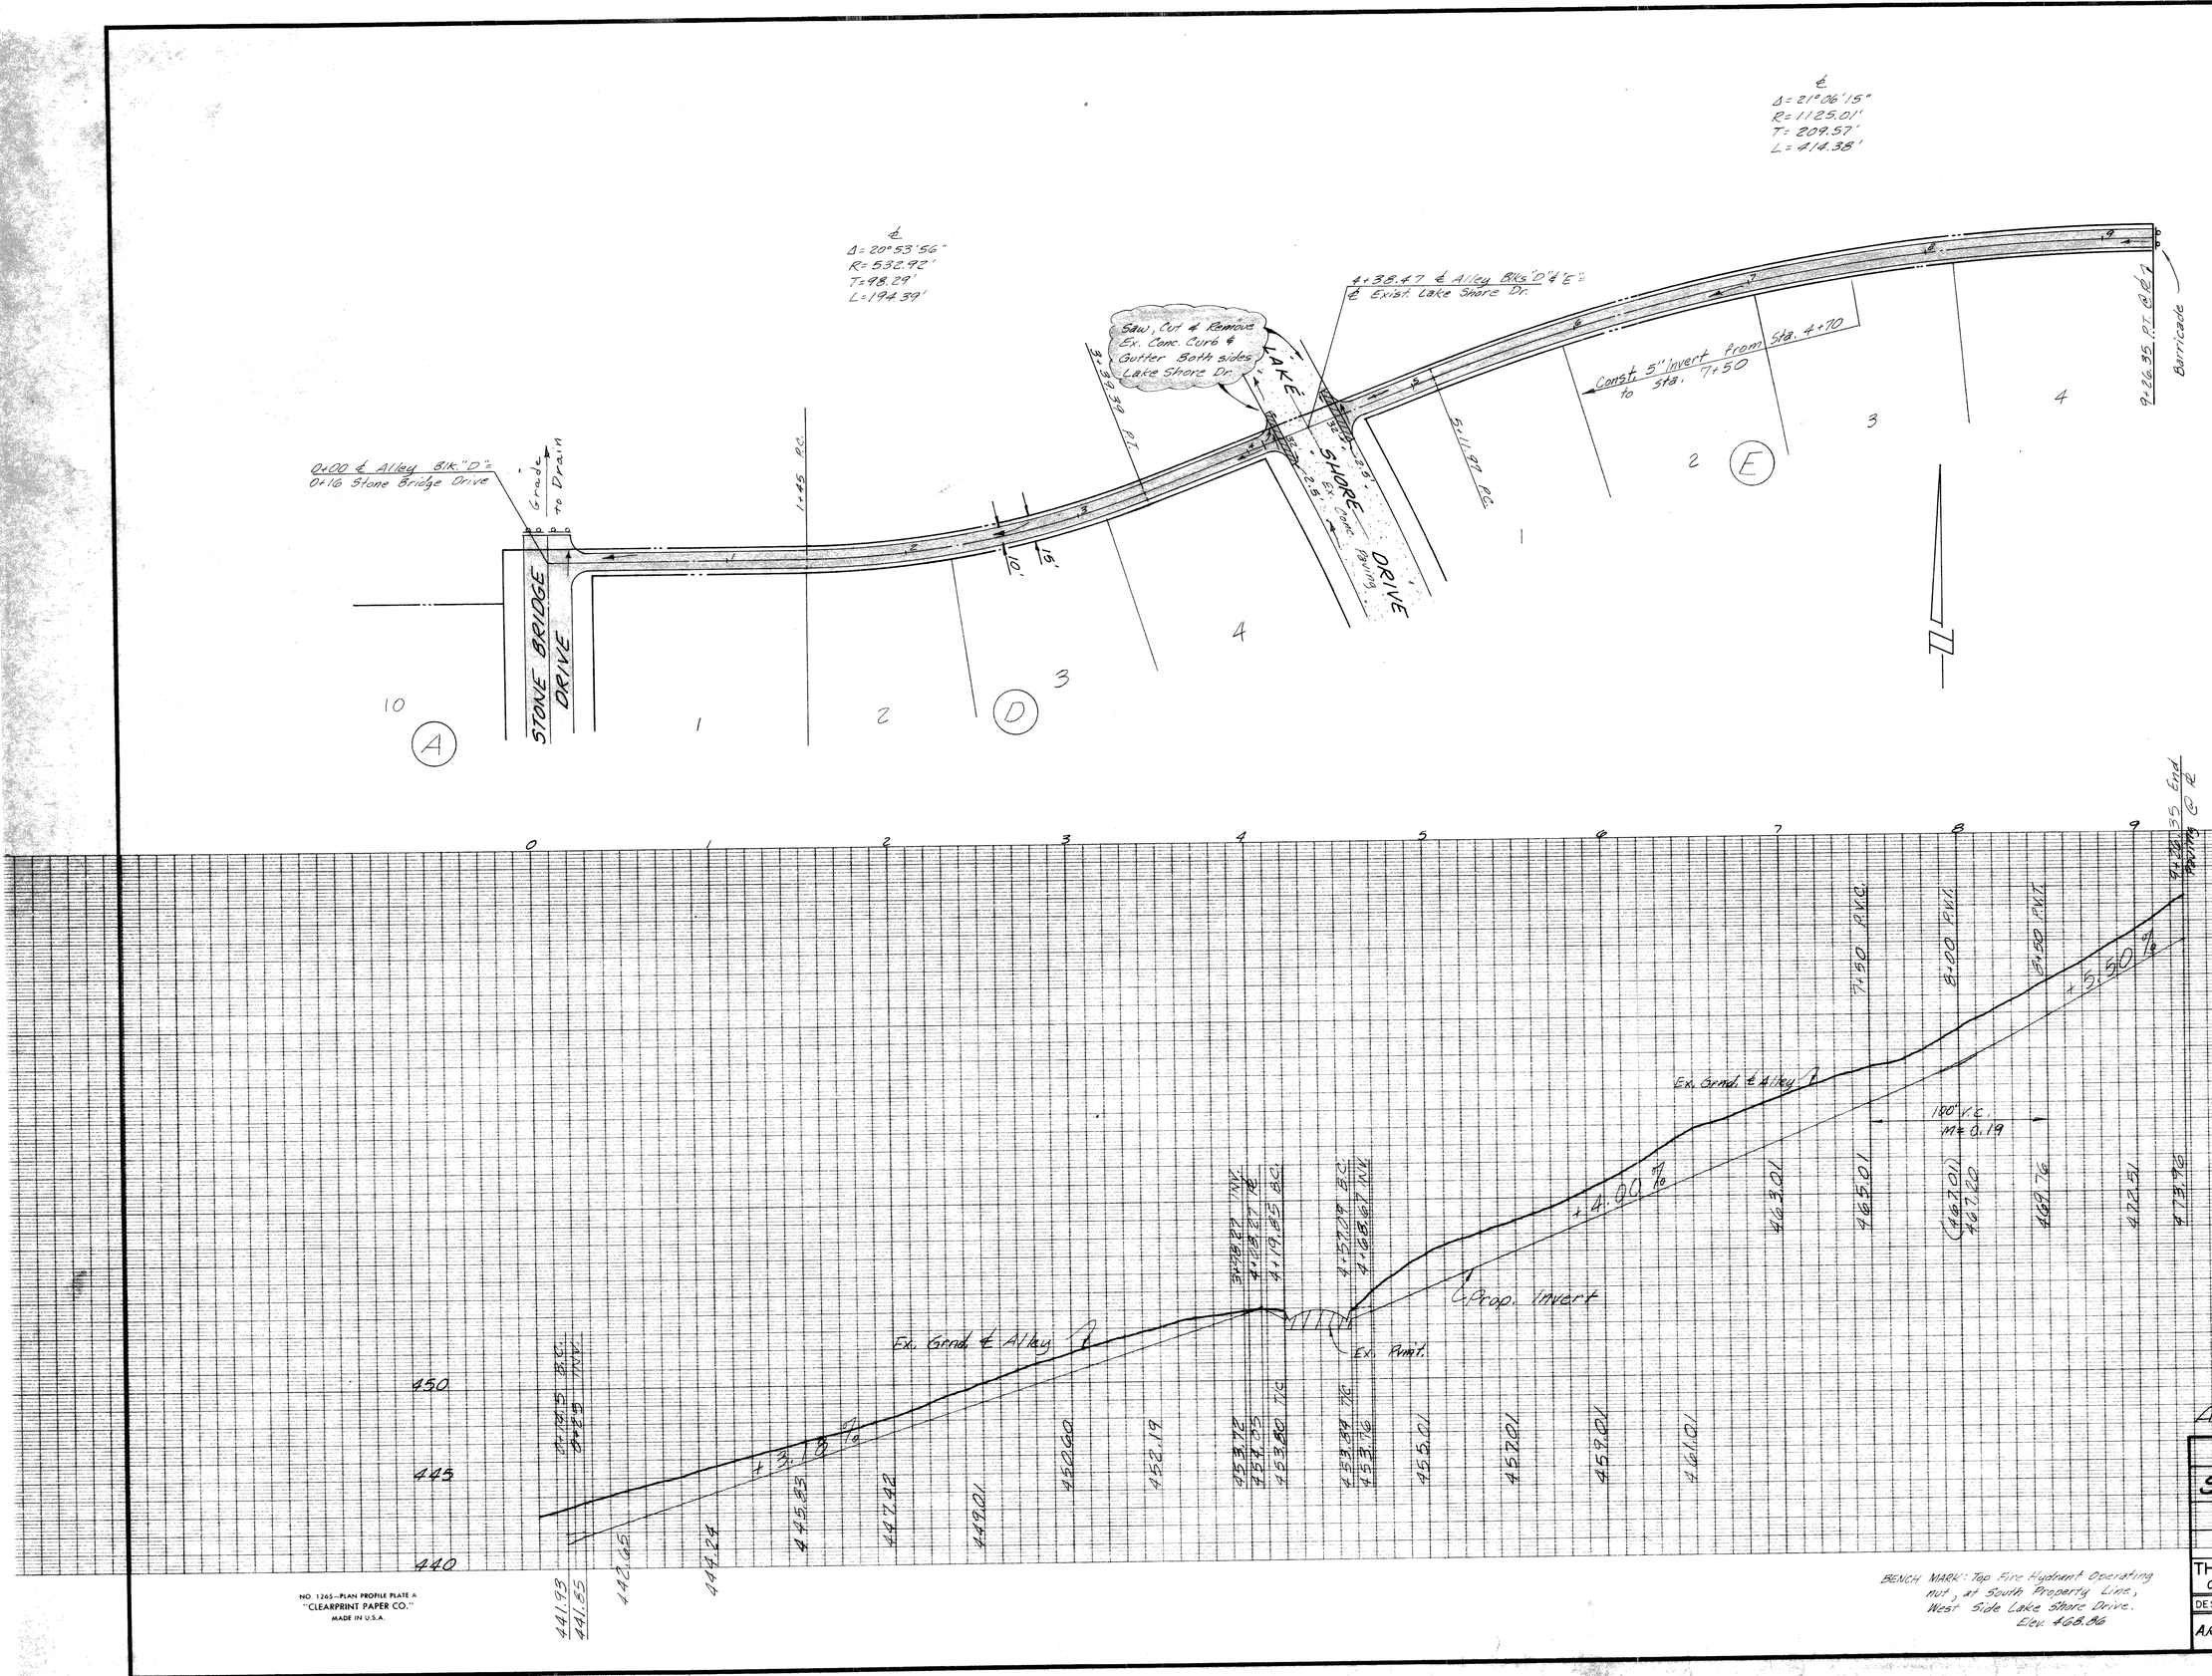
℄
Δ = 21°06'15"
R = 1125.01'
T = 209.57'
L = 414.38'
℄
Δ = 20°53'56"
R = 532.92'
T = 98.29'
L = 194.39'
0+00 ℄ Alley Blk. "D" =
0+16 Stone Bridge Drive
Grade to Drain
STONE BRIDGE DRIVE
1+45 P.C.
Saw, Cut & Remove Ex. Conc. Curb & Gutter Both sides Lake Shore Dr.
LAKE SHORE DRIVE
Ex. Conc. paving
4+38.47 ℄ Alley Blks "D" & "E" = ℄ Exist. Lake Shore Dr.
5+11.97 P.C.
Const. 5" Invert from Sta. 4+70 to Sta. 7+50
9+26.35 P.T. ℄ "E"
Barricade
10
A
1
2
D
3
4
2
E
3
4
Ex. Grnd. ℄ Alley "D"
Ex. Grnd. ℄ Alley "E"
Prop. Invert
Ex. Pvmt.
+3.18%
+5.50%
M = 0.19
7+50 P.V.C.
8+00 P.V.T.
8+50 P.V.T.
9+26.35 End ℄ "E"
450
445
440
475
470
465
441.93
441.55
442.65
442.74
445.85
447.42
449.01
450.00
452.19
453.72
453.25
453.00 T.C.
453.29 T.C.
453.16
455.01
457.01
459.01
461.01
463.01
465.01
467.01
467.00
469.76
472.51
473.95
BENCH MARK: Top Fire Hydrant Operating nut, at South Property Line, West Side Lake Shore Drive. Elev. 468.86
NOTES:
1. All construction performed shall be in accordance with City of Rockwall ordinances and specifications.
2. Locations of all existing facilities, i.e. pipelines, cables, electricity, telephone, etc., shall be verified in the field by the contractor. It shall be the responsibility of the contractor to notify the proper agencies prior to construction.
ALLEYS BLOCKS "D" & "E"
PAVING PLANS
STONE BRIDGE MEADOWS
PHASE ONE
ROCKWALL, TEXAS
THREADGILL - DOWDEY and ASSOCIATES
CONSULTING ENGINEERS
DALLAS, TEXAS
DESIGN: A.R.W.
DRAWN: R.E.
CHECKED: J.C.H.
DATE: 10-76
SCALE: 1"=40'H 1"=4'V
JOB: 456-E
SHEET: 4/4
PLATE No. 5
NO. 1265—PLAN PROFILE PLATE A
"CLEARPRINT PAPER CO."
MADE IN U.S.A.