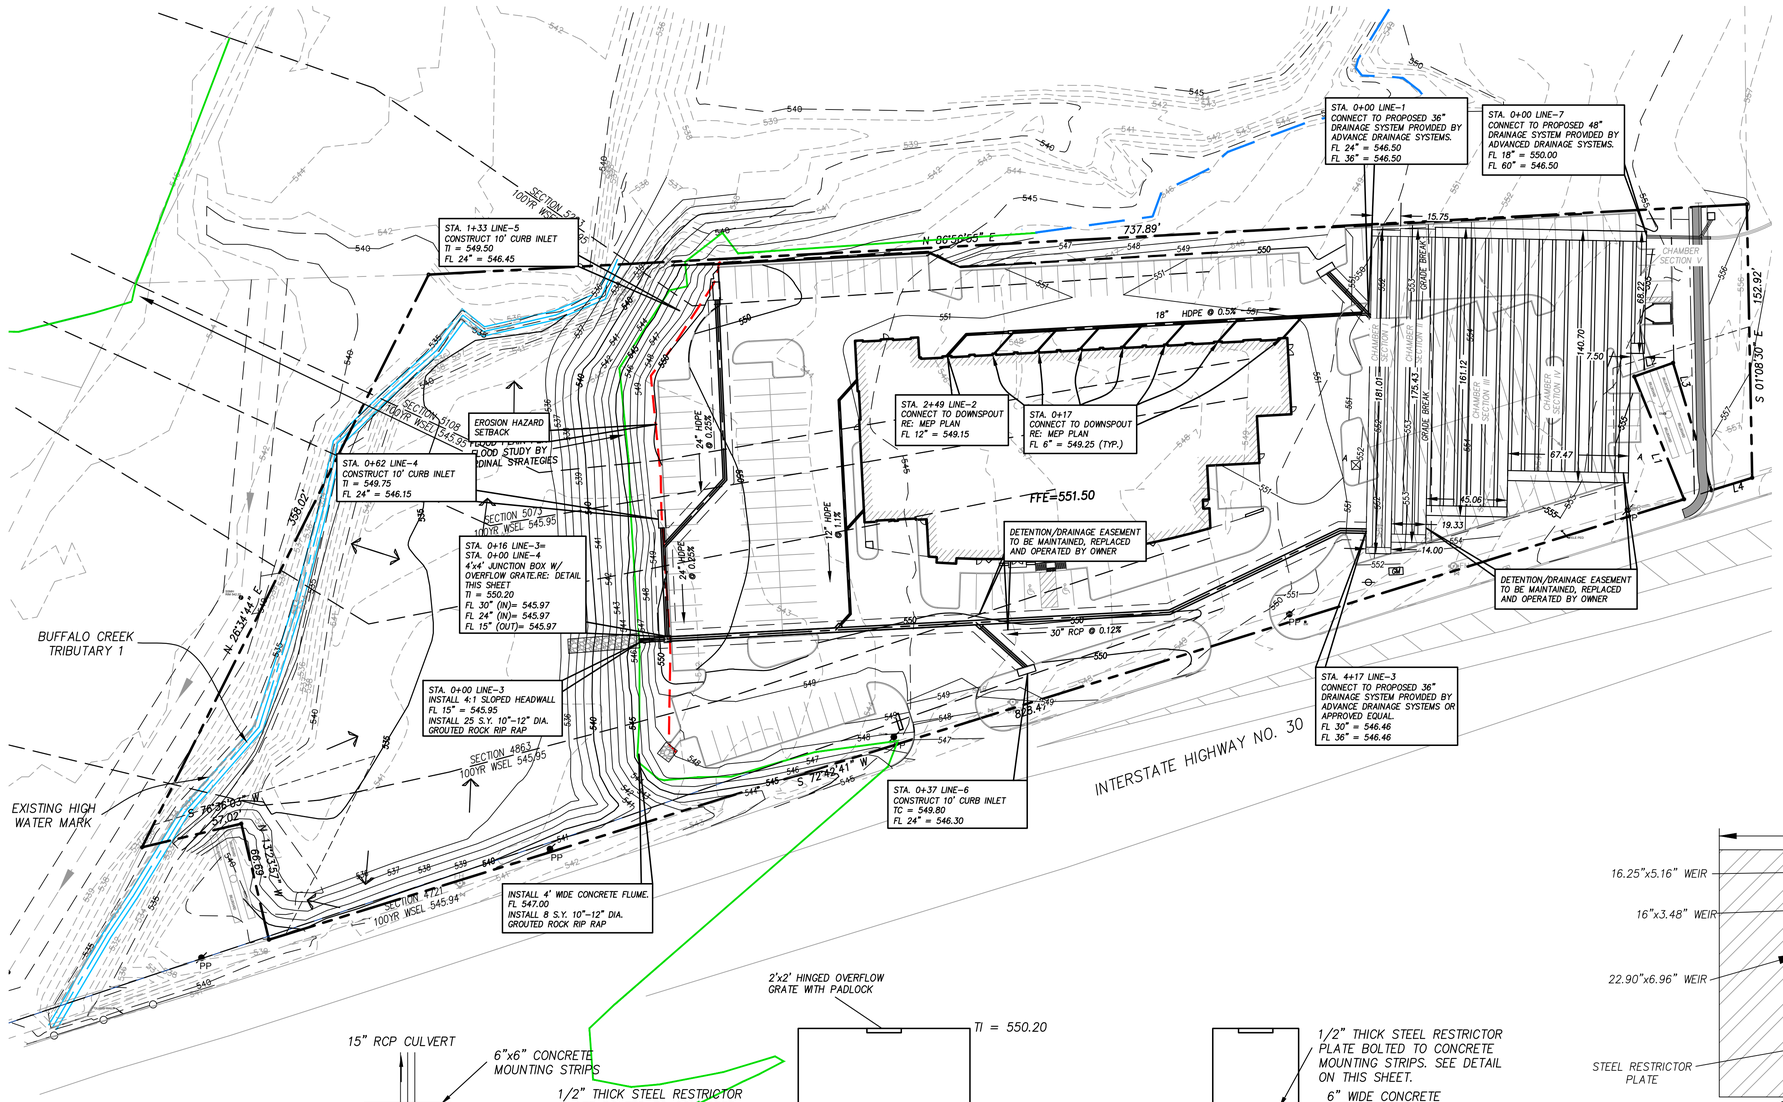

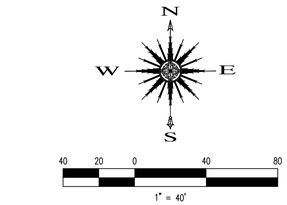

LEGEND

- Property Line
- 554 Ex. Contour
- 554 Ex. Contour
- Flow Direction

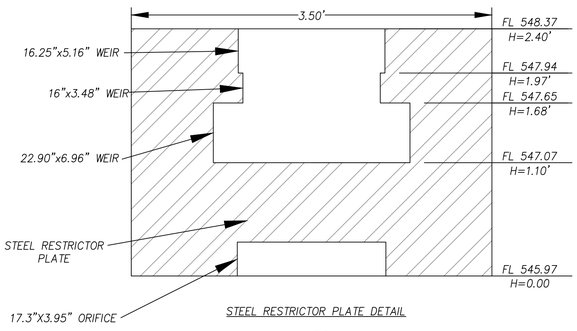

STEEL RESTRICTOR PLATE DETAIL

N.T.S.

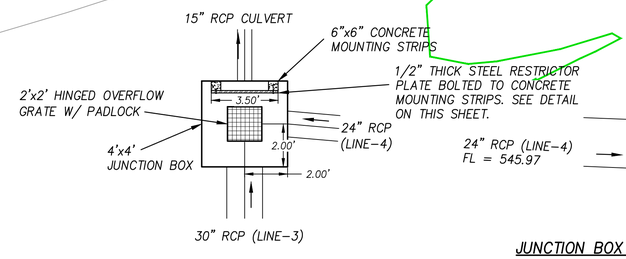

PLAN VIEW

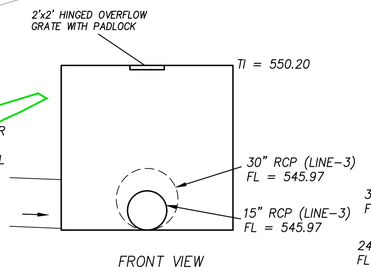

FRONT VIEW

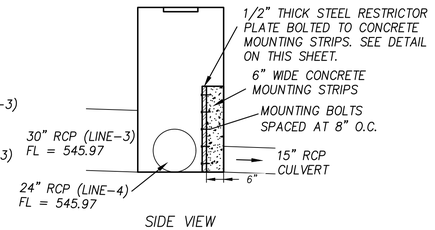

SIDE VIEW

JUNCTION BOX DETAIL

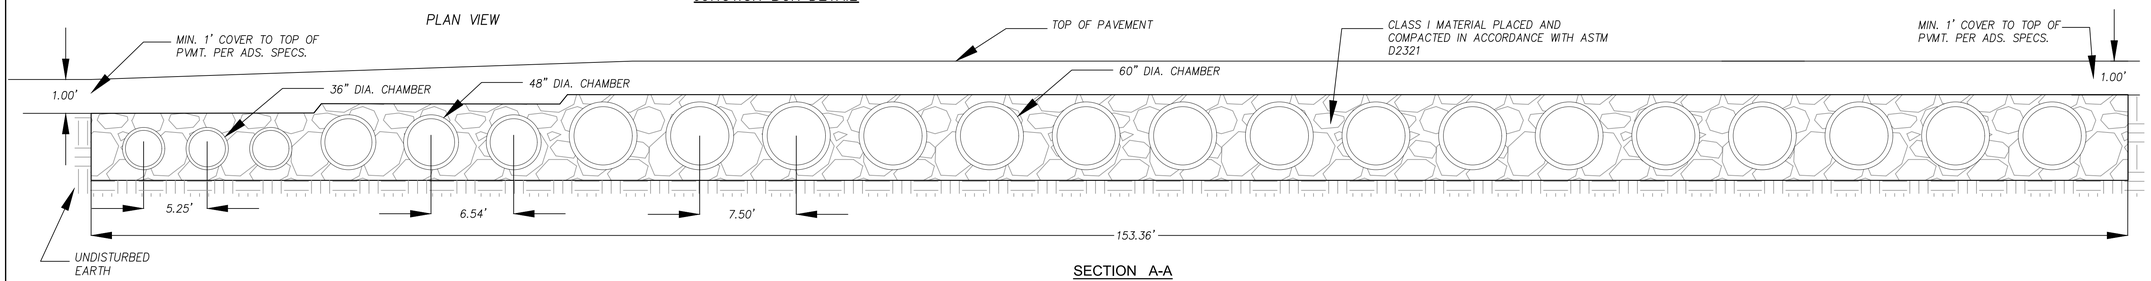

SECTION A-A

N.T.S.

RECORD DRAWING

Revision	Date	Description

Owner:
Rockwall Rental Properties
PO Box 818 • Terrell, Texas 75060

RANDALL NOE
SUBARU
I-30 ROCKWALL, TX

~ Civil Engineer ~
F.C. CUNY CORPORATION
#2 Horizon Court • Ste. 500 • Heath, Texas 75032
Phone: 469-402-7700
Fax: 469-402-0700
Texas Registered Engineering Firm F-7449

12/5/2019

STATE OF TEXAS
CAMERON A. SLOWN
106317
LICENSED PROFESSIONAL ENGINEER

Drawn By:	Checked By:
F.C. CUNY	F.C. CUNY
Date: 09/18	Project No.: --

Sheet Title:
Detention Pond Plan

Scale:	Sheet No.:
1"=40'	10A of 11