Revision	Date	Description

60" SINGLE MANIFOLD TEE W/ WELDED ENDPLATE & 48" STUB

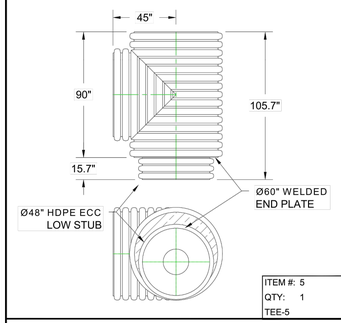

ITEM #: 5
QTY: 1
TEE-5

48" SINGLE MANIFOLD TEE W/ WELDED ENDPLATE & 36" STUB

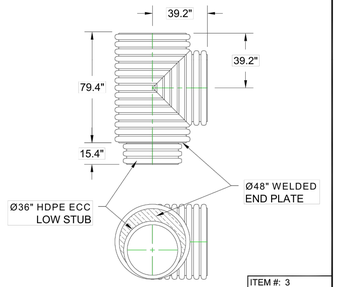

ITEM #: 3
QTY: 1
TEE-3

36" SINGLE MANIFOLD TEE

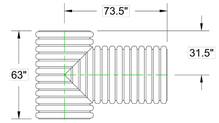

ITEM #: 1
QTY: 1
TEE-1

48" X 90° MANIFOLD BEND

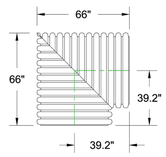

ITEM #: 11
QTY: 1
4898AN

48" SINGLE MANIFOLD TEE

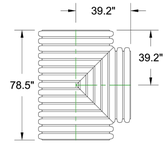

ITEM #: 9
QTY: 2
4851AN

36" DOUBLE MANIFOLD TEE

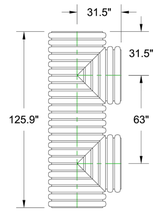

ITEM #: 7
QTY: 1
3652AN

REV	DWN	CKD	DESCRIPTION
04-27-18	ASC	CMF	PER ITEMIZED CALLOUTS
06-01-18	LAH	AJD	REV TO 36 & 48 BOLDER ENG
6-21-18	MJK	AJD	ADD 60" PIPE, REVISE SYSTEM
—			

RANDALL NOE SUBARU
ROCKWALL, TX
DATE: 04/18/18 DRAWN: BEW
PROJECT #: 5080200 CHECKED: AD
THIS DRAWING HAS BEEN PREPARED BASED ON INFORMATION PROVIDED TO AND UNDER THE DIRECTION OF THE SITE DESIGN ENGINEER OR OTHER PROJECT REPRESENTATIVE. THE SITE DESIGN ENGINEER SHALL REVIEW THIS DRAWING PRIOR TO CONSTRUCTION. IT IS THE ULTIMATE RESPONSIBILITY OF THE SITE DESIGN ENGINEER TO ENSURE THAT THE PRODUCTS DEPICTED AND ALL ASSOCIATED DETAILS MEET ALL APPLICABLE LOCAL REGULATIONS, AND PROJECT REQUIREMENTS.

4640 TRUEMAN BLVD
HILLIARD, OH 43026
ADS
Advanced Drainage Systems, Inc.

36", 48", & 60" STIB SOLID
DETENTION SYSTEM
HDPE N-12

SHEET 5 OF 9

48" DOUBLE MANIFOLD TEE

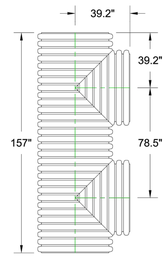

ITEM #: 6
QTY: 1
4852AN

60" SINGLE MANIFOLD TEE W/ WELDED ENDPLATE & 48" STUB

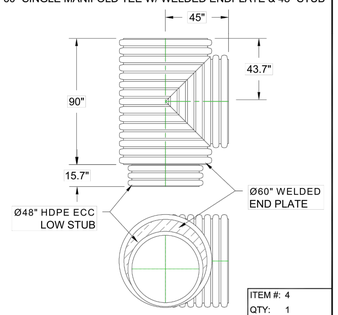

ITEM #: 4
QTY: 1
TEE-4

48" SINGLE MANIFOLD TEE W/ WELDED ENDPLATE & 36" STUB

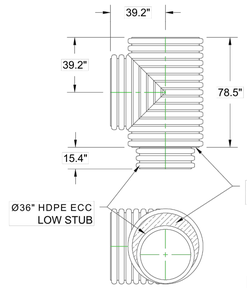

ITEM #: 2
QTY: 1
TEE-2

36" X 90° MANIFOLD BEND

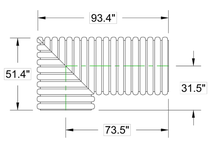

ITEM #: 12
QTY: 1
BEND-1

36" X 90° MANIFOLD BEND

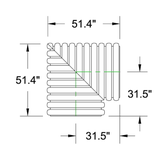

ITEM #: 10
QTY: 1
3698AN

36" SINGLE MANIFOLD TEE

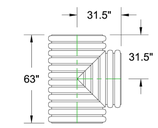

ITEM #: 8
QTY: 1
3651AN

REV	DWN	CKD	DESCRIPTION
04-27-18	ASC	CMF	PER ITEMIZED CALLOUTS
06-01-18	LAH	AJD	REV TO 36 & 48 BOLDER ENG
6-21-18	MJK	AJD	ADD 60" PIPE, REVISE SYSTEM
—			

RANDALL NOE SUBARU
ROCKWALL, TX
DATE: 04/18/18 DRAWN: BEW
PROJECT #: 5080200 CHECKED: AD
THIS DRAWING HAS BEEN PREPARED BASED ON INFORMATION PROVIDED TO AND UNDER THE DIRECTION OF THE SITE DESIGN ENGINEER OR OTHER PROJECT REPRESENTATIVE. THE SITE DESIGN ENGINEER SHALL REVIEW THIS DRAWING PRIOR TO CONSTRUCTION. IT IS THE ULTIMATE RESPONSIBILITY OF THE SITE DESIGN ENGINEER TO ENSURE THAT THE PRODUCTS DEPICTED AND ALL ASSOCIATED DETAILS MEET ALL APPLICABLE LOCAL REGULATIONS, AND PROJECT REQUIREMENTS.

4640 TRUEMAN BLVD
HILLIARD, OH 43026
ADS
Advanced Drainage Systems, Inc.

36", 48", & 60" STIB SOLID
DETENTION SYSTEM
HDPE N-12

SHEET 6 OF 9

60" DOUBLE MANIFOLD TEE

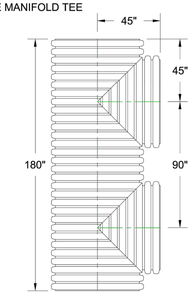

ITEM #: 17
QTY: 13
6052AN

60" SINGLE MANIFOLD TEE

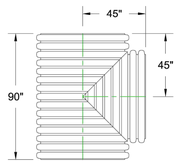

ITEM #: 15
QTY: 2
6051AN

36" X 90° MANIFOLD BEND

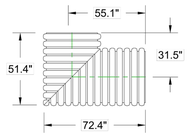

ITEM #: 13
QTY: 1
BEND-2

60" X 90° MANIFOLD BEND

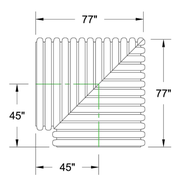

ITEM #: 16
QTY: 3
6098AN

60" X 90° MANIFOLD BEND W/ 18" ECC HIGH STUB

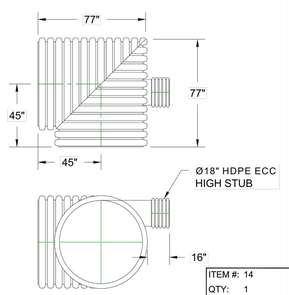

ITEM #: 14
QTY: 1
6098ANC-1

REV	DWN	CKD	DESCRIPTION
04-27-18	ASC	CMF	PER ITEMIZED CALLOUTS
06-01-18	LAH	AJD	REV TO 36 & 48 BOLDER ENG
6-21-18	MJK	AJD	ADD 60" PIPE, REVISE SYSTEM
—			

RANDALL NOE SUBARU
ROCKWALL, TX
DATE: 04/18/18 DRAWN: BEW
PROJECT #: 5080200 CHECKED: AD
THIS DRAWING HAS BEEN PREPARED BASED ON INFORMATION PROVIDED TO AND UNDER THE DIRECTION OF THE SITE DESIGN ENGINEER OR OTHER PROJECT REPRESENTATIVE. THE SITE DESIGN ENGINEER SHALL REVIEW THIS DRAWING PRIOR TO CONSTRUCTION. IT IS THE ULTIMATE RESPONSIBILITY OF THE SITE DESIGN ENGINEER TO ENSURE THAT THE PRODUCTS DEPICTED AND ALL ASSOCIATED DETAILS MEET ALL APPLICABLE LOCAL REGULATIONS, AND PROJECT REQUIREMENTS.

4640 TRUEMAN BLVD
HILLIARD, OH 43026
ADS
Advanced Drainage Systems, Inc.

36", 48", & 60" STIB SOLID
DETENTION SYSTEM
HDPE N-12

SHEET 7 OF 9

36" PIPE STICK : SOLID W/ 24" STUB

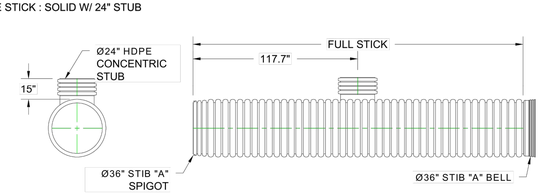

ITEM #: 22
QTY: 1
STICK-1

36" PIPE STICK : SOLID W/ 30" STUB

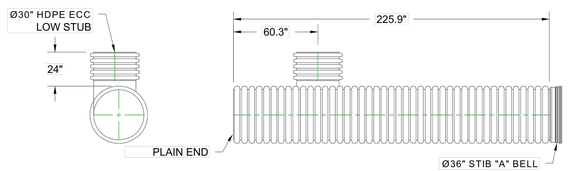

ITEM #: 24
QTY: 1
STICK-3

REV	DWN	CKD	DESCRIPTION
04-27-18	ASC	CMF	PER ITEMIZED CALLOUTS
06-01-18	LAH	AJD	REV TO 36 & 48 BOLDER ENG
6-21-18	MJK	AJD	ADD 60" PIPE, REVISE SYSTEM
—			

RANDALL NOE SUBARU
ROCKWALL, TX
DATE: 04/18/18 DRAWN: BEW
PROJECT #: 5080200 CHECKED: AD
THIS DRAWING HAS BEEN PREPARED BASED ON INFORMATION PROVIDED TO AND UNDER THE DIRECTION OF THE SITE DESIGN ENGINEER OR OTHER PROJECT REPRESENTATIVE. THE SITE DESIGN ENGINEER SHALL REVIEW THIS DRAWING PRIOR TO CONSTRUCTION. IT IS THE ULTIMATE RESPONSIBILITY OF THE SITE DESIGN ENGINEER TO ENSURE THAT THE PRODUCTS DEPICTED AND ALL ASSOCIATED DETAILS MEET ALL APPLICABLE LOCAL REGULATIONS, AND PROJECT REQUIREMENTS.

4640 TRUEMAN BLVD
HILLIARD, OH 43026
ADS
Advanced Drainage Systems, Inc.

36", 48", & 60" STIB SOLID
DETENTION SYSTEM
HDPE N-12

SHEET 8 OF 9

RECORD DRAWING

Owner:
Rockwall Rental Properties
PO Box 818 • Terrell, Texas 75060

RANDALL NOE
SUBARU
1-30 ROCKWALL, TX

~ Civil Engineer ~
F.C. CUNY CORPORATION
#2 Horizon Court • Ste. 500 • Heath, Texas 75032
Phone: 469-402-7700
Fax: 469-402-0700
Texas Registered Engineering Firm F-7449

12/5/2019

STATE OF TEXAS
CAMERON A. SLOWN
106317
LICENSED
PROFESSIONAL ENGINEER

Drawn By:	Checked By:
F.C. CUNY	F.C. CUNY
Date: 09/18	Project No.: --

Sheet Title:
Detention Pond Details

Scale:	Sheet No.:
	10E of 11