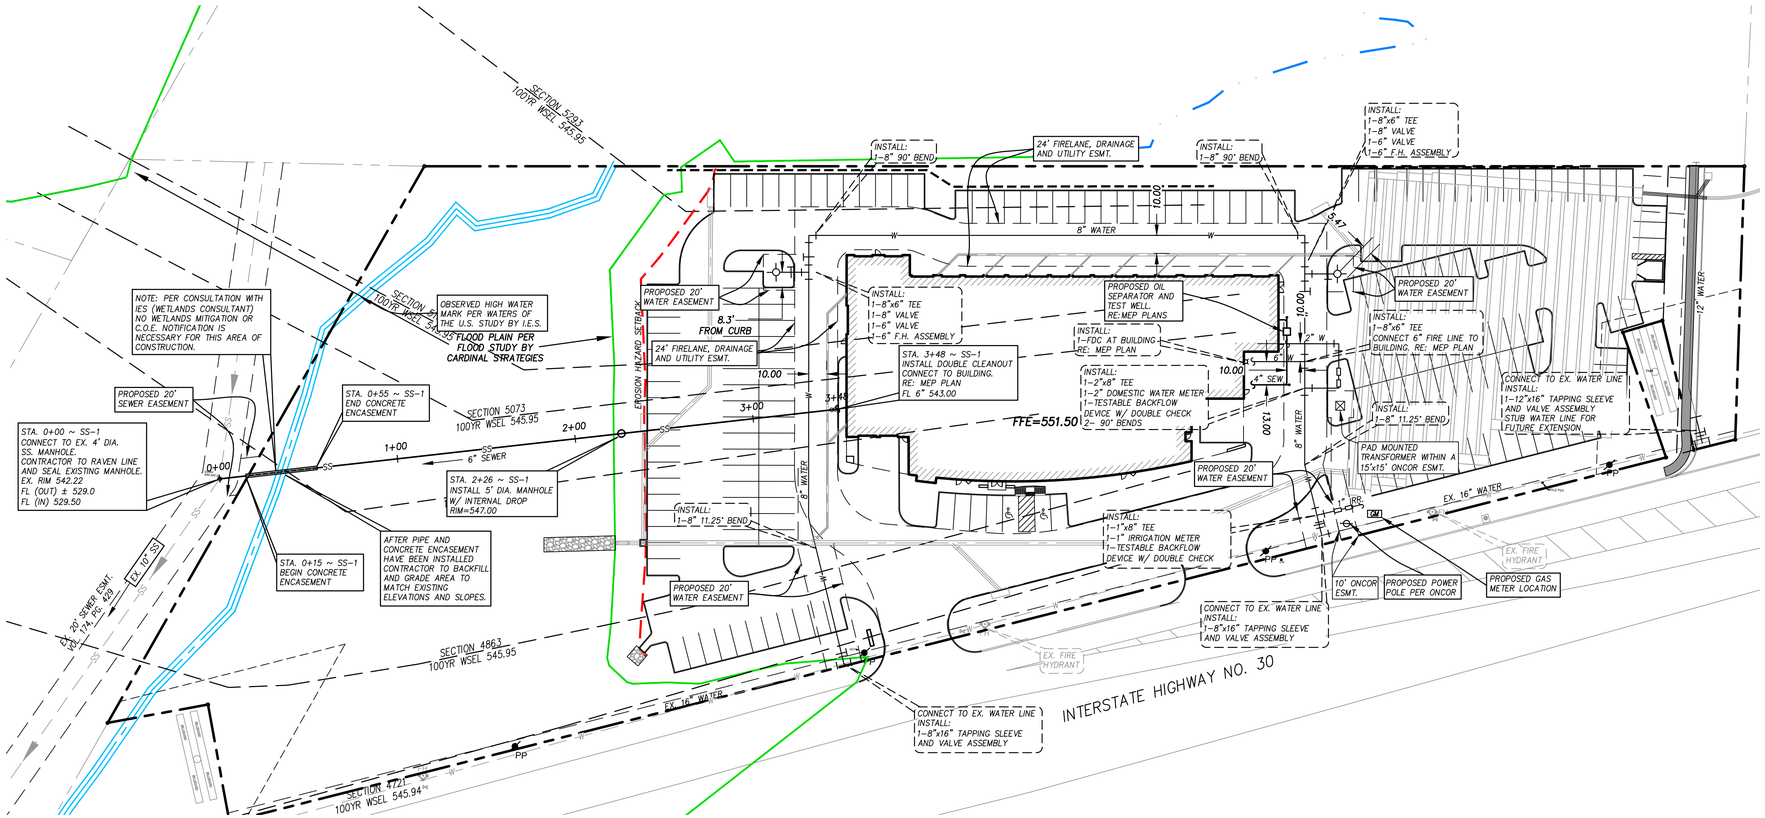

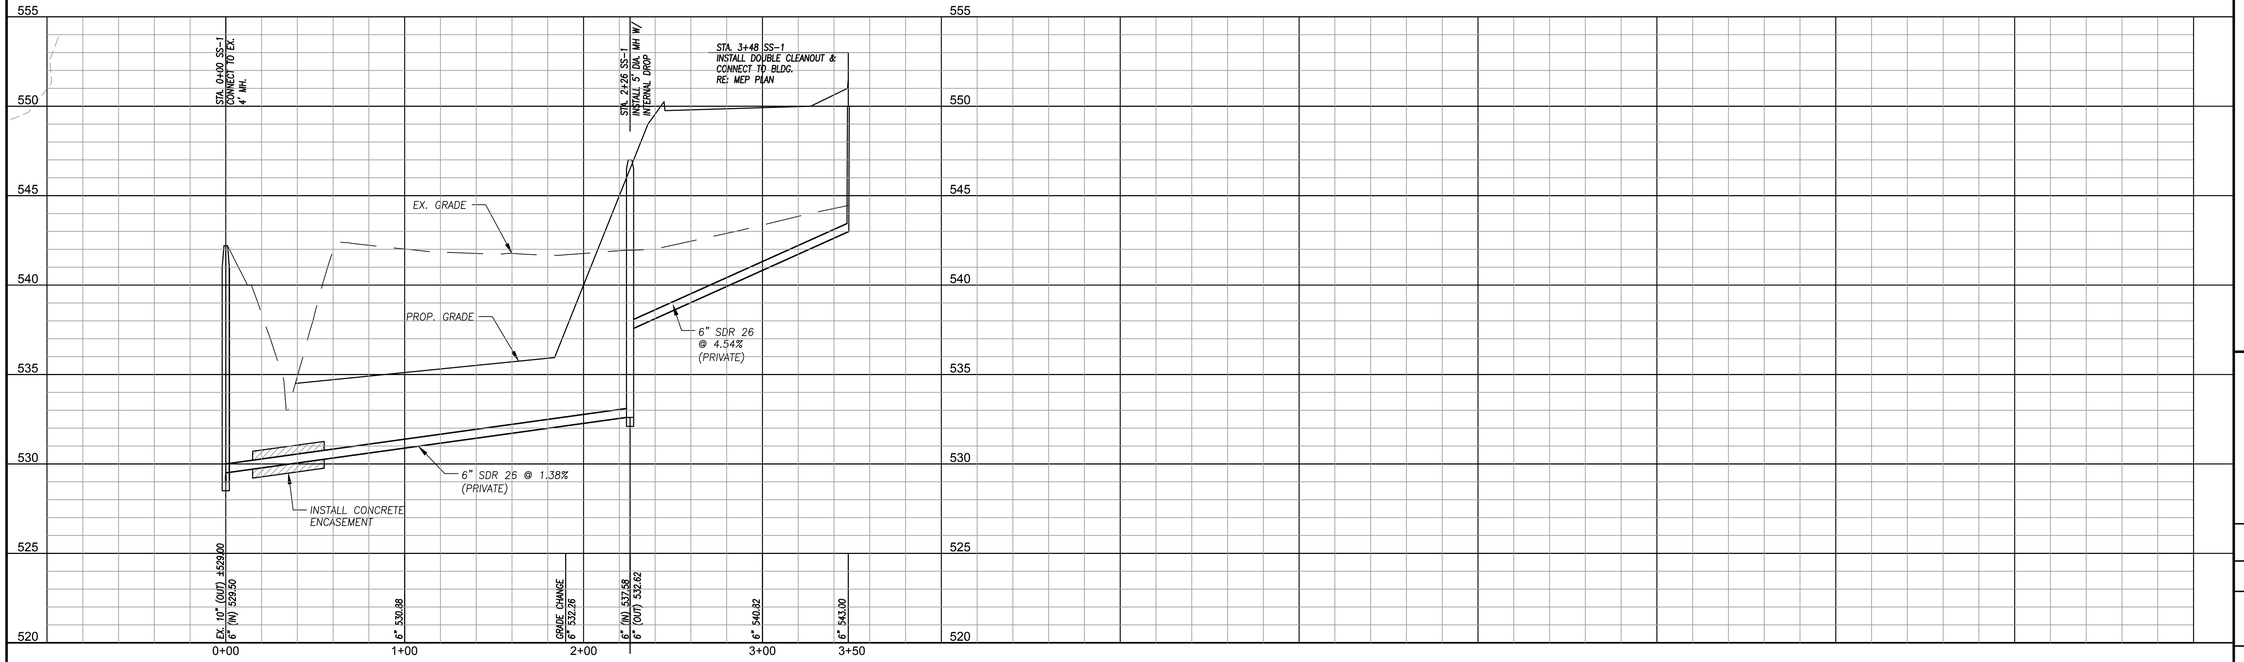

RECORD DRAWING

N
W
E
S

40 20 0 40 80

1" = 40'

LEGEND

- PROPERTY LINE
- W W — EXISTING WATER LINE
- SS SS — EXISTING SANITARY SEWER LINE
- W W — PROPOSED WATER LINE
- SS SS — PROPOSED SANITARY SEWER LINE

FRANCHISE UTILTIY CONTACTS

ELECTRIC:	ONCOR ELECTRIC
CONTACT:	PHILLIP DICKERSON
PHONE:	(972) 551-6712
GAS:	ATMOS ENERGY
CONTACT:	DINAH WOOD
PHONE:	(972) 485-6277
TELEPHONE:	AT&T
CONTACT:	CHRIS HOLMES
PHONE:	(903) 457-2303

Revision	Date	Description

Owner:
Rockwall Rental Properties
PO Box 818 • Terrell, Texas 75060

RANDALL NOE SUBARU

I-30 ROCKWALL, TX

~ Civil Engineer ~
F.C. CUNY CORPORATION
#2 Horizon Court • Ste. 500 • Heath, Texas 75032
Phone: 469-402-7700
Fax: 469-402-0700
Texas Registered Engineering Firm F-7449

12/5/2019

STATE OF TEXAS
CAMERON A. SLOWN
106317
LICENSED PROFESSIONAL ENGINEER

Drawn By:	Checked By:
F.C. CUNY	F.C. CUNY
Date: 09/18	Project No.: -

Sheet Title:
Utility Plan and Sewer Profile

Scale:	Sheet No.:
1"=40'	11 of 11