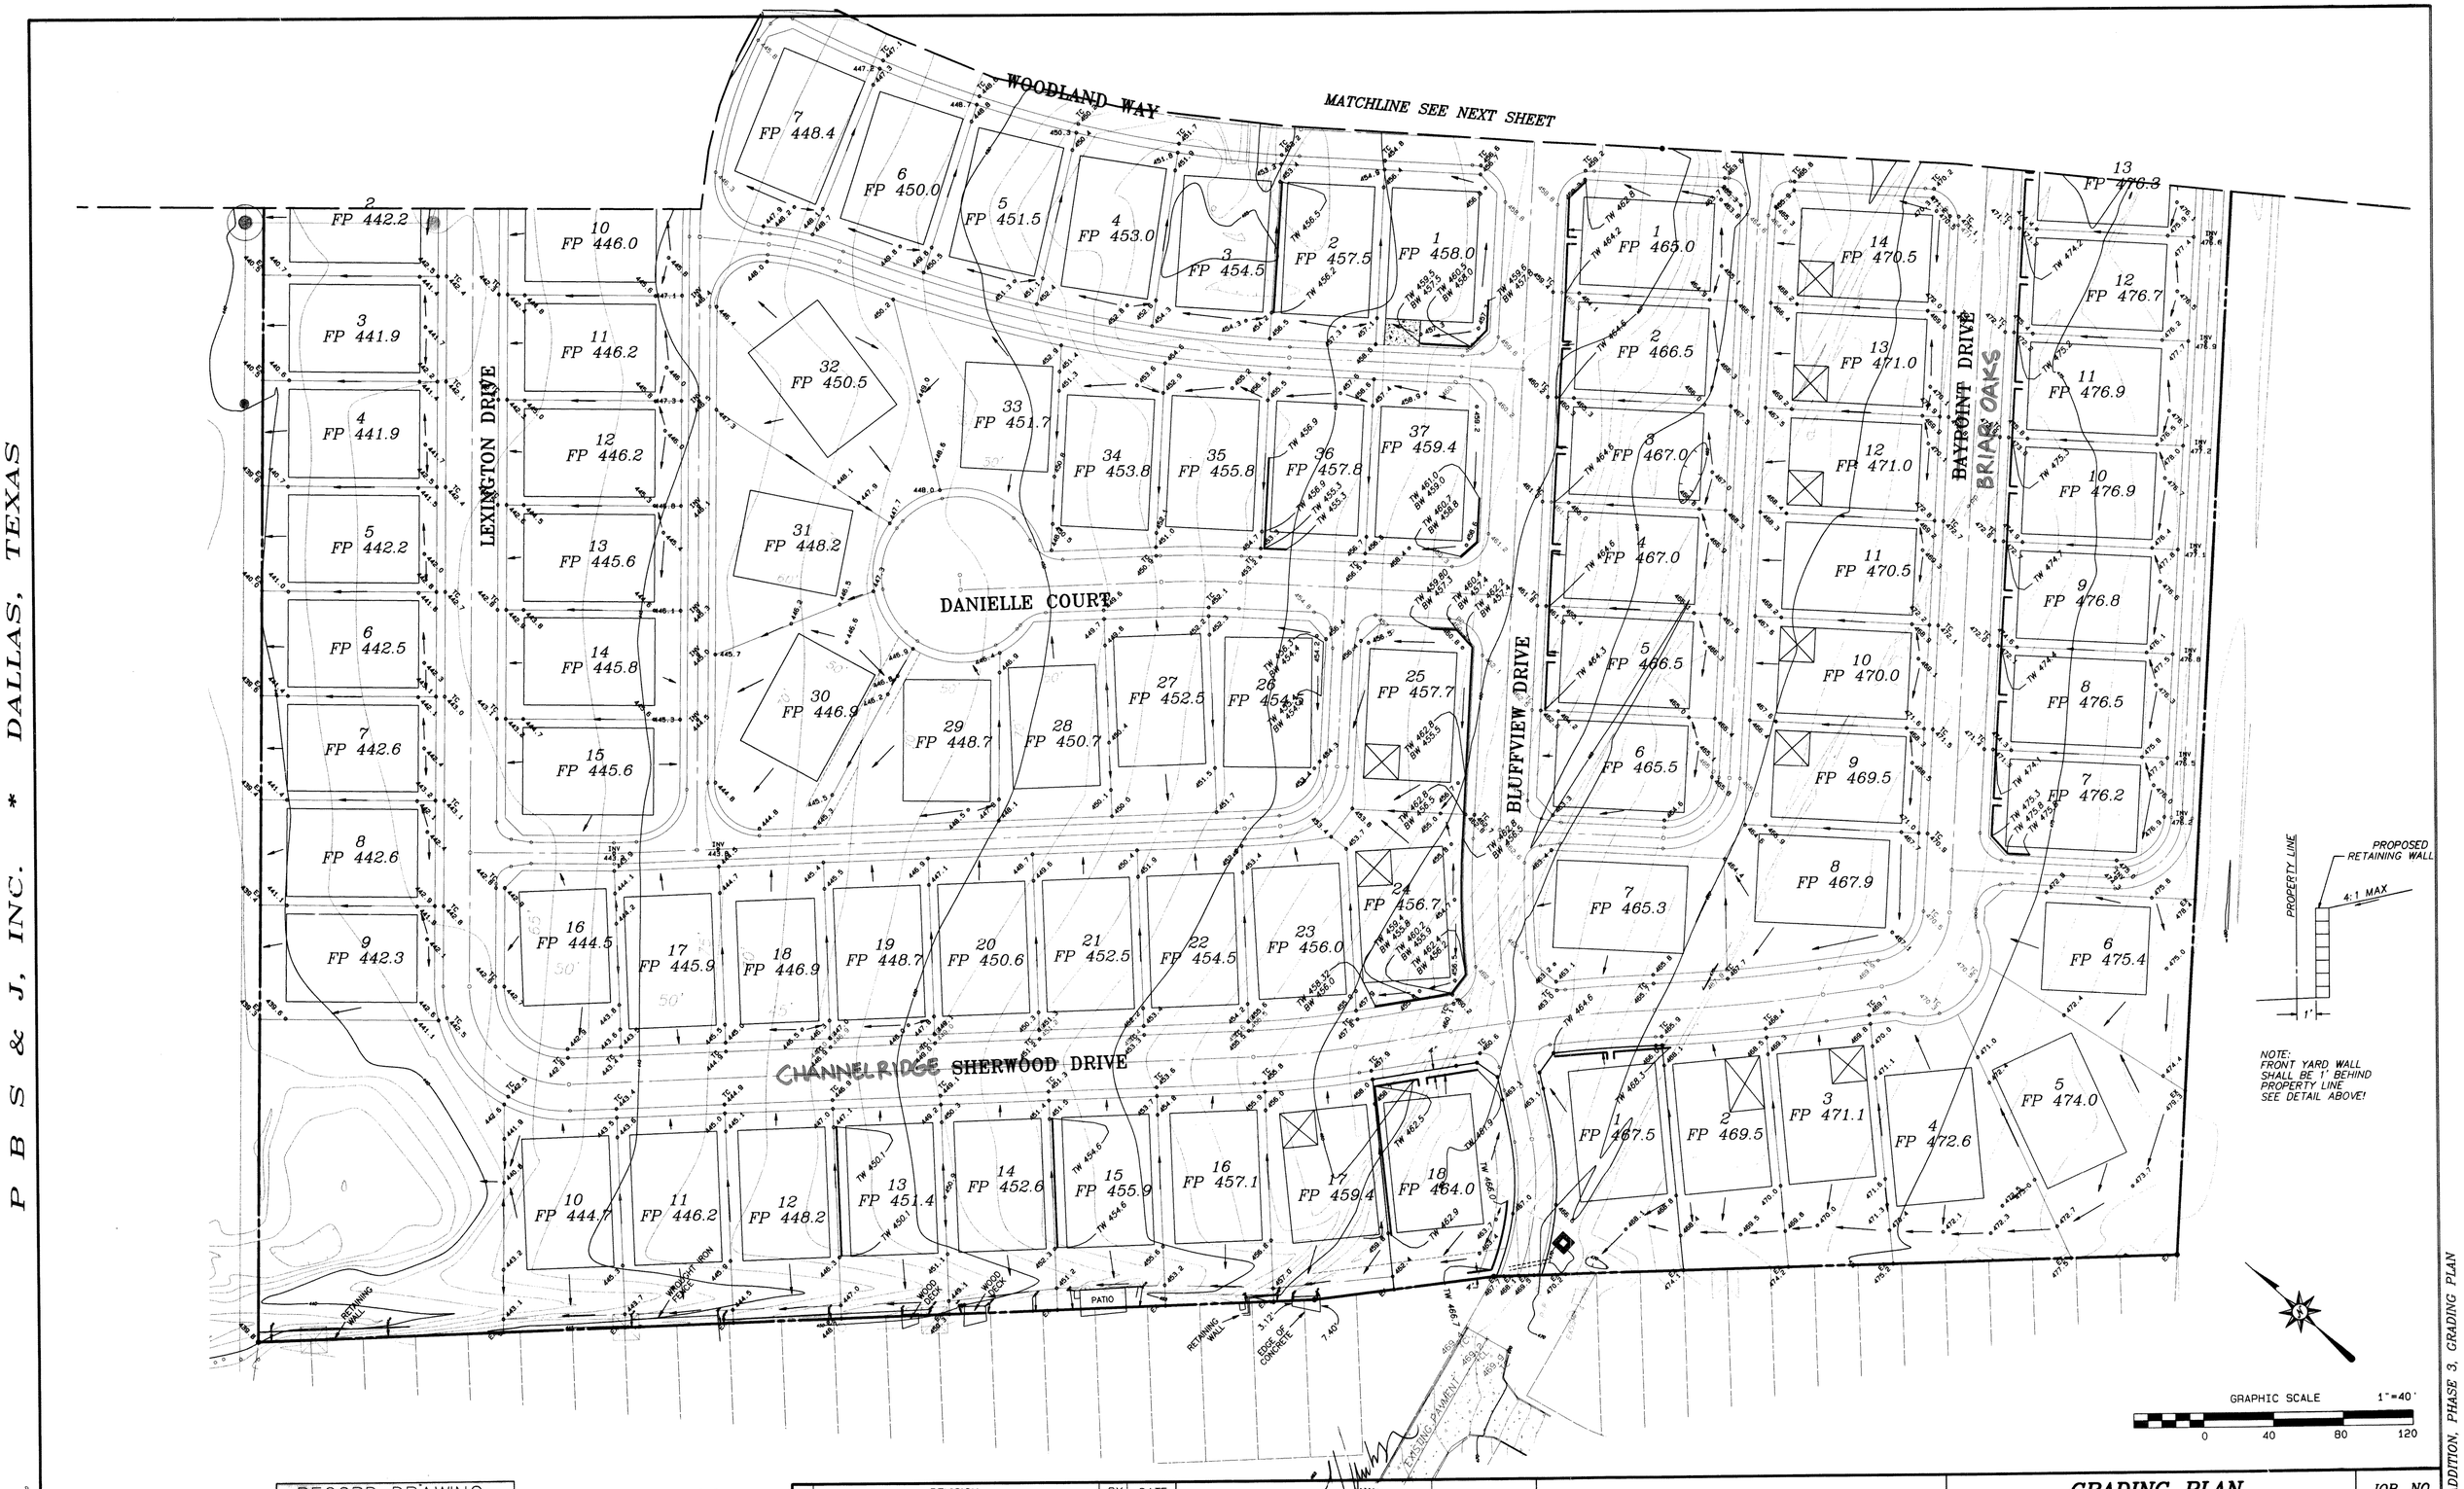

P B S & J, INC. * DALLAS, TEXAS

RECORD DRAWING

DATE: 7-28-00

THIS RECORD DRAWING HEREIN REFLECTS TO THE BEST OF THE DESIGN ENGINEER'S KNOWLEDGE THE APPROXIMATE LOCATION OF THE CONSTRUCTED WORK USING INFORMATION AS PROVIDED BY THE CONTRACTOR(S).

BENCHMARKS:

NO.	REVISION	BY	DATE

STATE OF TEXAS
BRIAN L. UMBERGER
82474
REGISTERED PROFESSIONAL ENGINEER

6-26-00

THE SEAL APPEARING ON THIS DOCUMENT WAS AUTHORIZED BY BRIAN L. UMBERGER, P.E. #82474

SCALE: AS SHOWN
DESIGNED PBS&J
DRAWN PBS&J
DATE
DWG FILE

PBSJ
5999 SUMMERSIDE DRIVE ~ SUITE 202
DALLAS, TEXAS 75252
PH. (972) 380~2605 FAX (972) 380~2609

GRADING PLAN
TURTLE COVE ADDITION, PHASE 3
ROCKWALL
ROCKWALL COUNTY, TEXAS

JOB NO. 95115.02
SHEET 3 OF 28

TURTLE COVE ADDITION, PHASE 3, GRADING PLAN