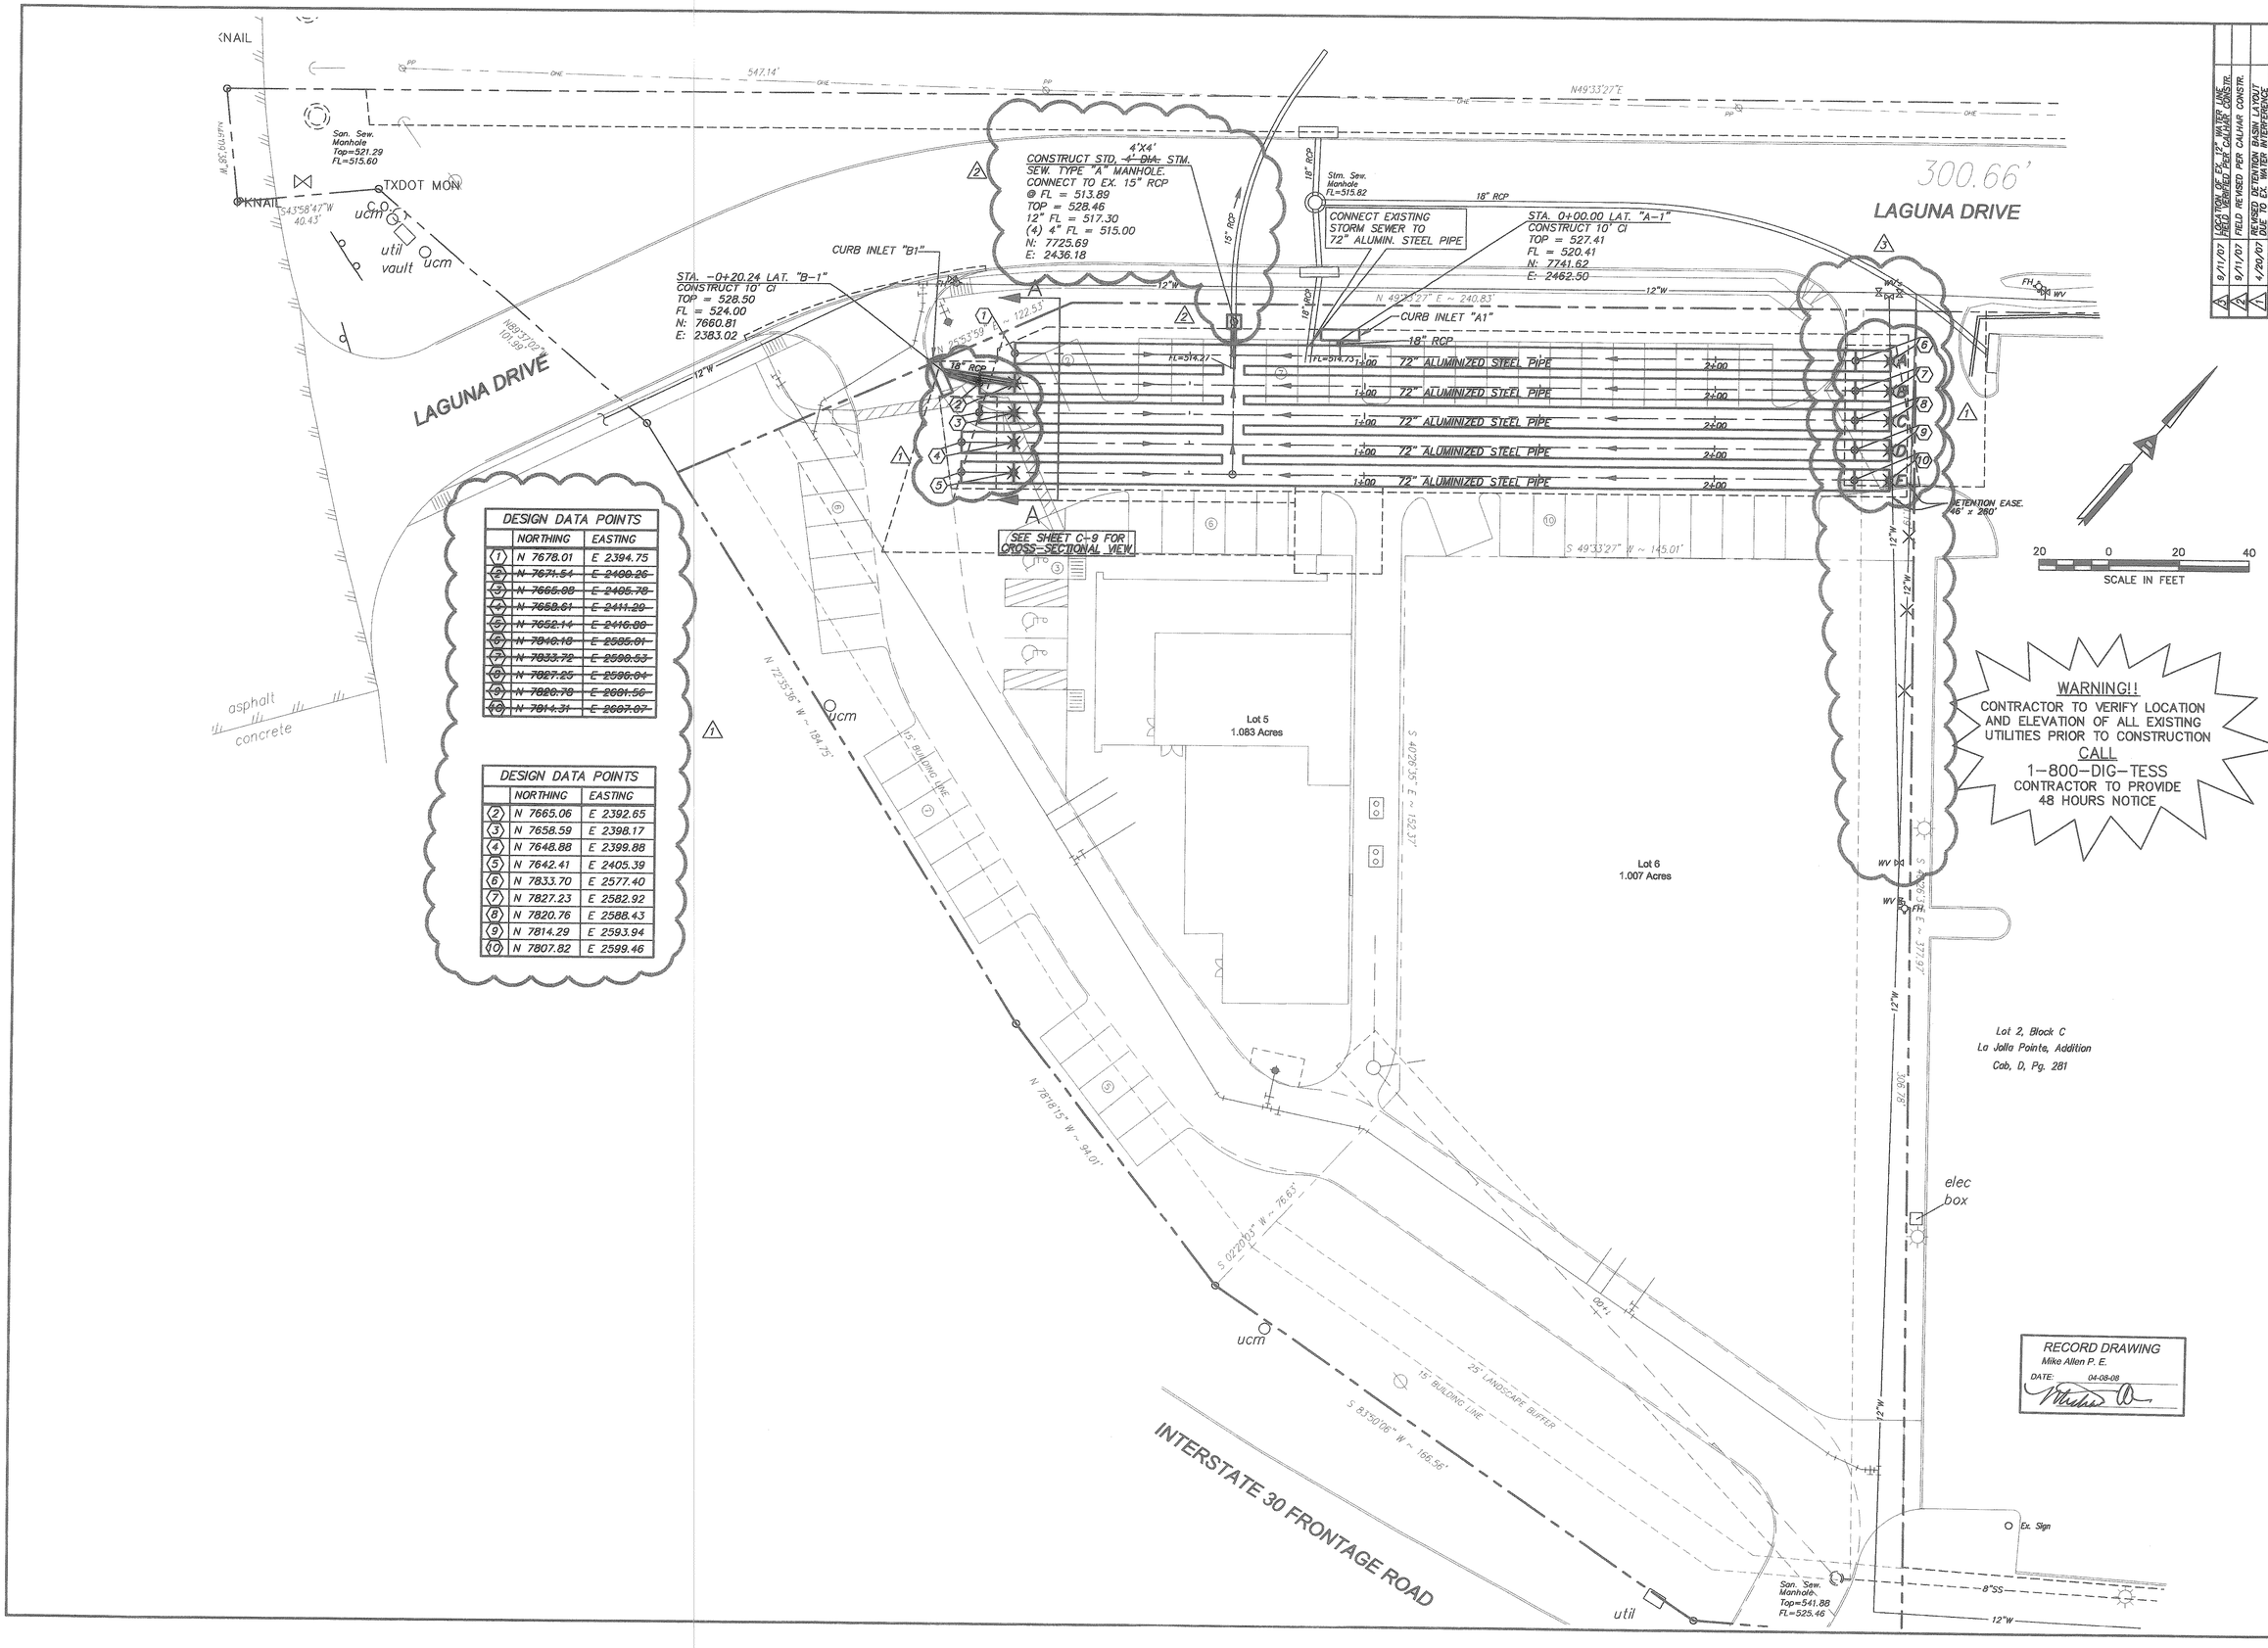

DESIGN DATA POINTS		
	NORTHING	EASTING
1	N 7678.01	E 2394.75
~~2~~	~~N 7671.54~~	~~E 2400.26~~
~~3~~	~~N 7665.08~~	~~E 2405.78~~
~~4~~	~~N 7658.61~~	~~E 2411.29~~
~~5~~	~~N 7652.14~~	~~E 2416.80~~
~~6~~	~~N 7840.18~~	~~E 2585.01~~
~~7~~	~~N 7833.72~~	~~E 2590.53~~
~~8~~	~~N 7827.25~~	~~E 2596.04~~
~~9~~	~~N 7820.78~~	~~E 2601.56~~
~~10~~	~~N 7814.31~~	~~E 2607.07~~

DESIGN DATA POINTS		
	NORTHING	EASTING
2	N 7665.06	E 2392.65
3	N 7658.59	E 2398.17
4	N 7648.88	E 2399.88
5	N 7642.41	E 2405.39
6	N 7833.70	E 2577.40
7	N 7827.23	E 2582.92
8	N 7820.76	E 2588.43
9	N 7814.29	E 2593.94
10	N 7807.82	E 2599.46

WARNING!!
CONTRACTOR TO VERIFY LOCATION AND ELEVATION OF ALL EXISTING UTILITIES PRIOR TO CONSTRUCTION
CALL
1-800-DIG-TESS
CONTRACTOR TO PROVIDE 48 HOURS NOTICE

RECORD DRAWING
Mike Allen P. E.
DATE: 04-08-08

No.	Date	Revisions	App.
3	9/11/07	LOCATION OF EX. 12" WATER LINE FIELD VERIFIED PER CALHAR CONSTR.	
2	9/11/07	FIELD REVISED PER CALHAR CONSTR.	
1	4/20/07	REVISED DETENTION BASIN LAYOUT DUE TO EX. WATER INTERFERENCE	

Allen & Ridinger Consulting, Inc.
285 W. Southwest Pkwy
Lewisville, Texas 75067
Tel. No. (972) 353-8000
Fax No. (972) 353-8011

STATE OF TEXAS
MICHAEL S. ALLEN
86188
LICENSED PROFESSIONAL ENGINEER

VISTA LAGO
ROCKWALL, TEXAS

STORM SEWER PLAN

Scale: 1"=20'
Designed by: JDL
Drawn by: JDL
Checked by: MSA
Date: APRIL 30, 2007
Project No. 069-001

SHEET C-7 OF 10