REVISIONS	BY	REVISIONS	BY
1 JANUARY 17, 1996	G.R.A.		

1 PRICING ORDER NO. 1 – REVISED SANITARY SEWER ROUTE, PIPE LENGHTS AND SLOPES, AND ADDED ADDITIONAL MANHOLE, ALSO ADDED NOTE # 20 REGARDING FLEXIBLE COMPRESSION JOINTS (PER ICBO REVIEW COMMENTS).

DESIGNED R.D.M.
DRAWN R.D.M.
CHECKED D.J.A.

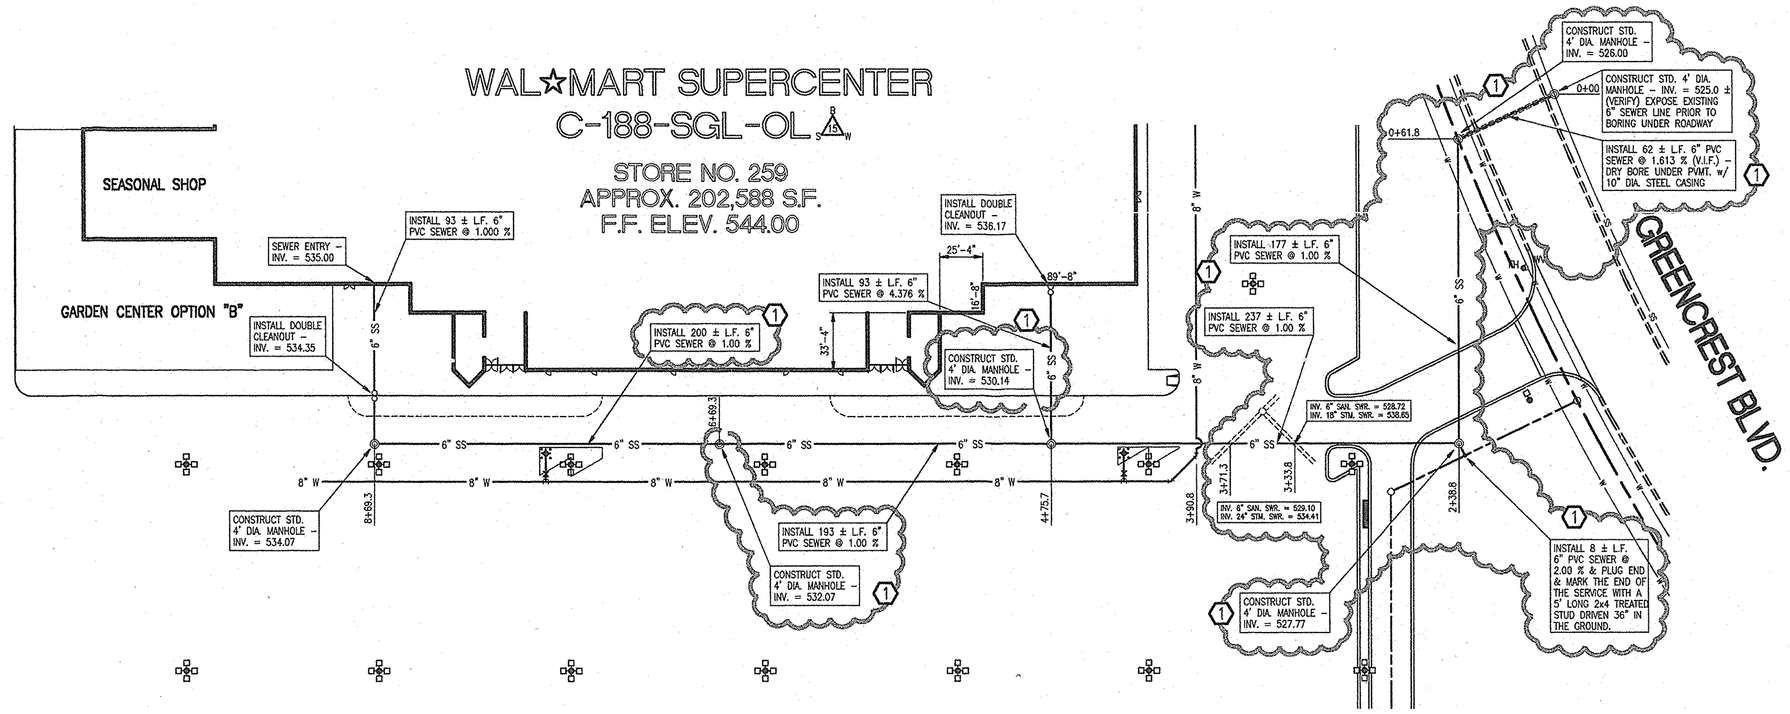

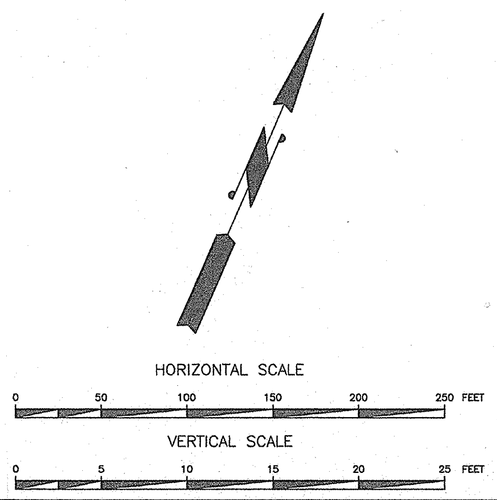

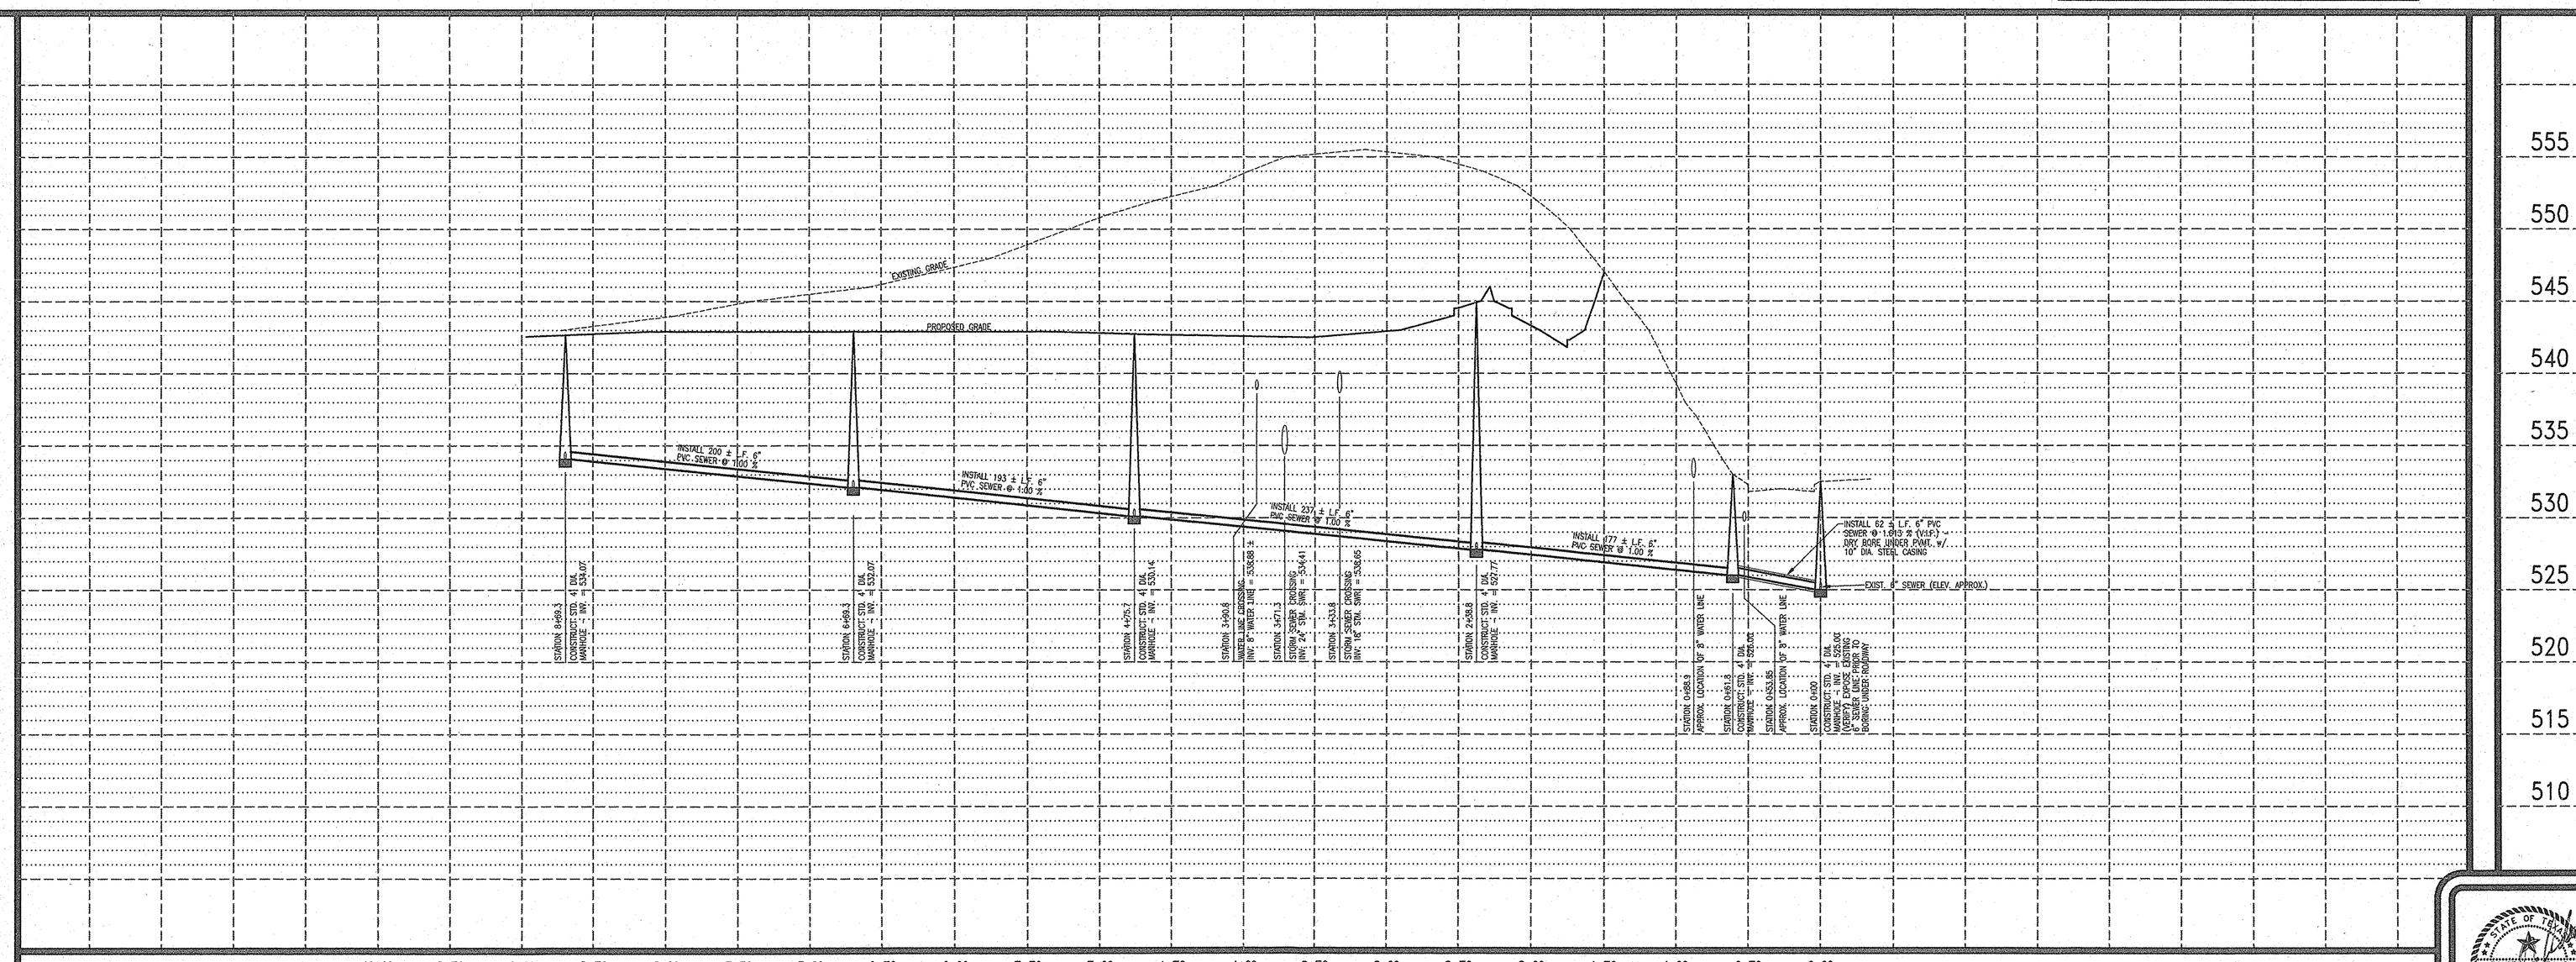

ADAMS CONSULTING ENGINEERS, INC.
CIVIL / ENVIRONMENTAL ENGINEERS • SURVEYORS
6320 Copeland Road • Tyler, Texas 75703 • (903) 561-8919

SANITARY SEWER PLAN / PROFILE

WAL-MART SUPERCENTER #259
INTERSTATE 30
ROCKWALL, TEXAS

STATE OF TEXAS
DANIEL J. ADAMS
94866
REGISTERED PROFESSIONAL ENGINEER

1.17%

DATE 8/25/95
JOB NO. 93-11W
SHEET NO. 11