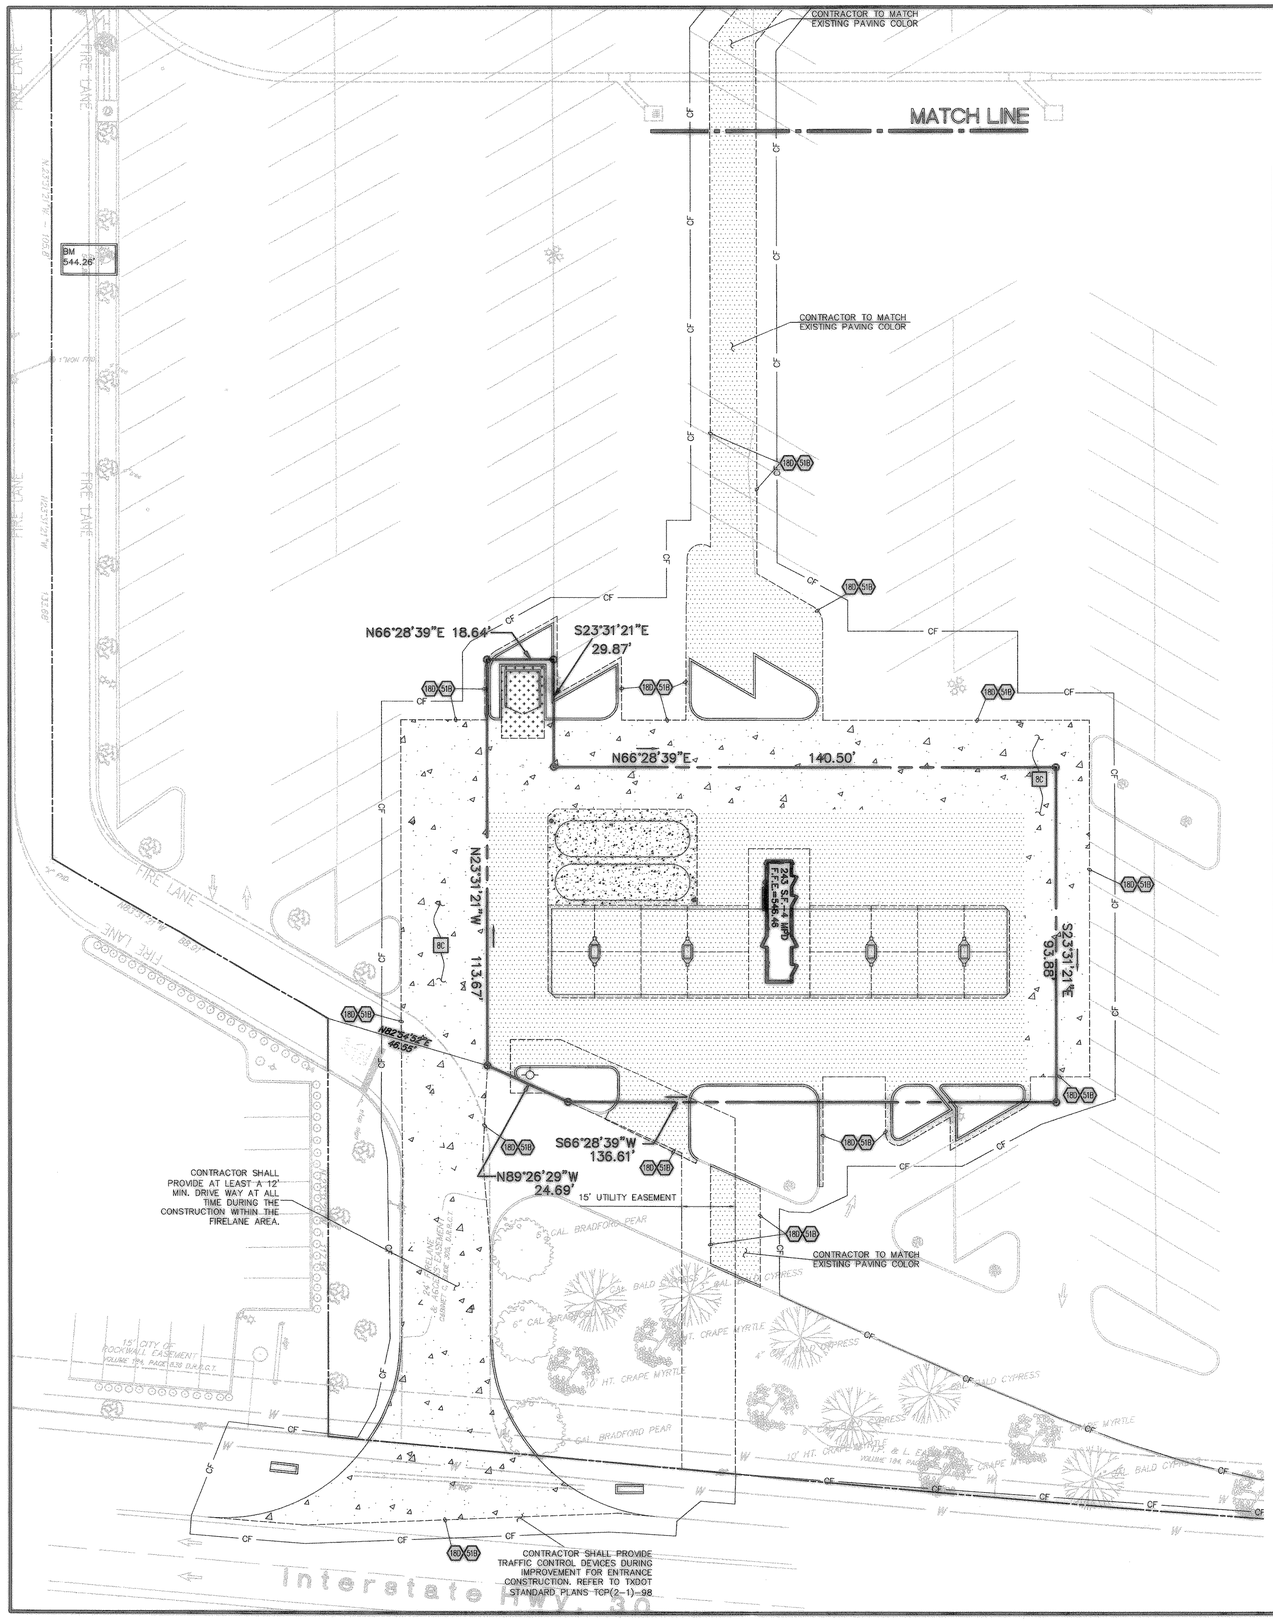

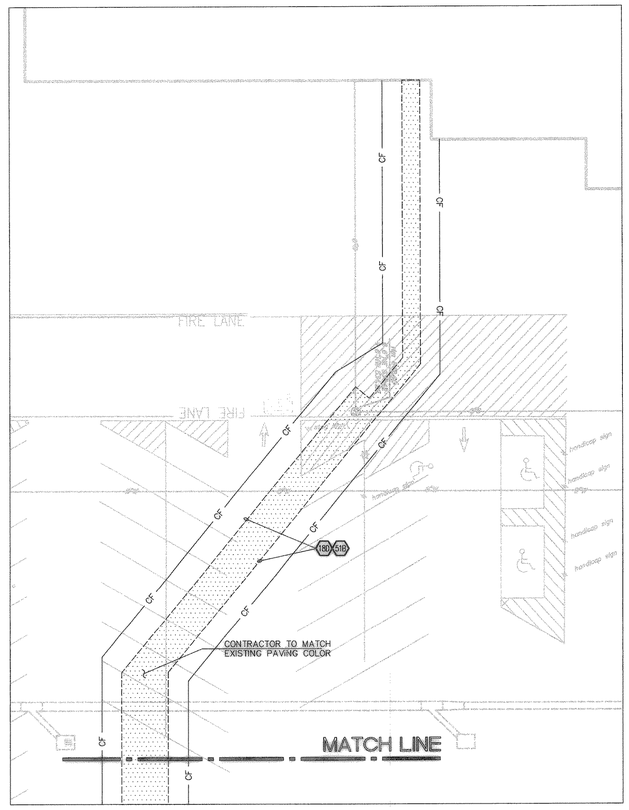

CALL BEFORE YOU DIG 1-800-245-4545 TEXAS ONE CALL SYSTEM

TEXAS EXCAVATION SAFETY SERVICES 1-800-344-8377

0 20' 30' 40'
SCALE IN FEET

LEGEND

EXISTING

- BOUNDARY LINE
- RIGHT OF WAY LINE
- STORM DRAIN
- GAS
- OHE — OVERHEAD ELECTRIC
- OHE&T — OVERHEAD ELECTRIC AND TELEPHONE
- SEWER
- UGE — UNDERGROUND ELECTRIC
- UGE&T — UNDERGROUND ELECTRIC AND TELEPHONE
- WATER
- SIGN
- UTILITY POLE
- LIGHT POLE
- GRATED INLET
- FIRE HYDRANT

- e — EAST OR ELECTRIC
- n — NORTH
- oh — OVERHEAD
- s — SOUTH OR SEWER
- t — TELEPHONE
- ug — UNDERGROUND
- w — WEST OR WATER
- ww — WASTE WATER

PROPOSED

- BOUNDARY LINE
- CF — CONSTRUCTION FENCE
- CONCRETE CURB AND GUTTER. (SEE JGD SHEET YD-5)

PAVING DETAILS

NOTE: SEE SHEET YD-4 & YD-5 FOR PAVING DETAILS, SPECIFICATIONS AND CONSTRUCTION SEQUENCE.

- 10" CONCRETE PAVING (4,000 P.S.I. CONCRETE)
- 8" CONCRETE PAVING (4,000 P.S.I. CONCRETE)
- 6" CONCRETE PAVING (4,000 P.S.I. CONCRETE)
- 8C 7" HEAVY DUTY CONCRETE PAVING (SEE DETAIL ON THIS PLAN)

PAVING NOTES

- 18D MATCH EXISTING PAVEMENT ELEVATION
- 51B LIMITS OF SAWCUT & PAVEMENT REMOVAL

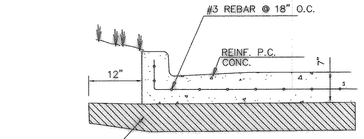

7" HEAVY DUTY CONCRETE PAVING 8C
4,000 PSI CONCRETE)
N.T.S.

NOTE: (PER GEOTECH REPORT BY PROVIDED GLOBE ENGINEERS, INC. DATED 12/10/04.)

1. CONCRETE SHALL HAVE A MIN. 28 DAY COMPRESSIVE STRENGTH OF 4,000 PSI FOR ALL CONCRETE PAVING.

NOTE:
CONTRACTOR TO REFER TO GEOTECHNICAL REPORT FOR SPECIFIC SUBGRADE PREPARATION AND CONSTRUCTION RECOMMENDATIONS.

AS BUILT

SHEET NO. C-8

STATE OF TEXAS LEONG-WEE YEE 93569 PROFESSIONAL ENGINEER 11/17/05

REV-7	DATE	DRN	PRN	JDG	PM	AB'	DES	PHY	DR'W	PHY
	06/15/05									

PAVING PLAN
WAL-MART SUPERCENTER #259
I.H. 30 & WHITEHILLS DRIVE
ROCKWALL, TEXAS

CEI ENGINEERING ASSOCIATES
ENGINEERS • PLANNERS • SURVEYORS
12300 FORD ROAD, SUITE 110
DALLAS, TEXAS 75234
(972) 488-3737
FAX (972) 488-6732
DWG NAME: 9235Pro1
JOB NO: 19235.0

MURPHY OIL U.S.A. INC.
200 PEACH STREET
P.O. BOX 7000
EL DORADO, AR 71731-7000

MURPHY USA

2004 CEI ENGINEERING ASSOCIATES, INC.