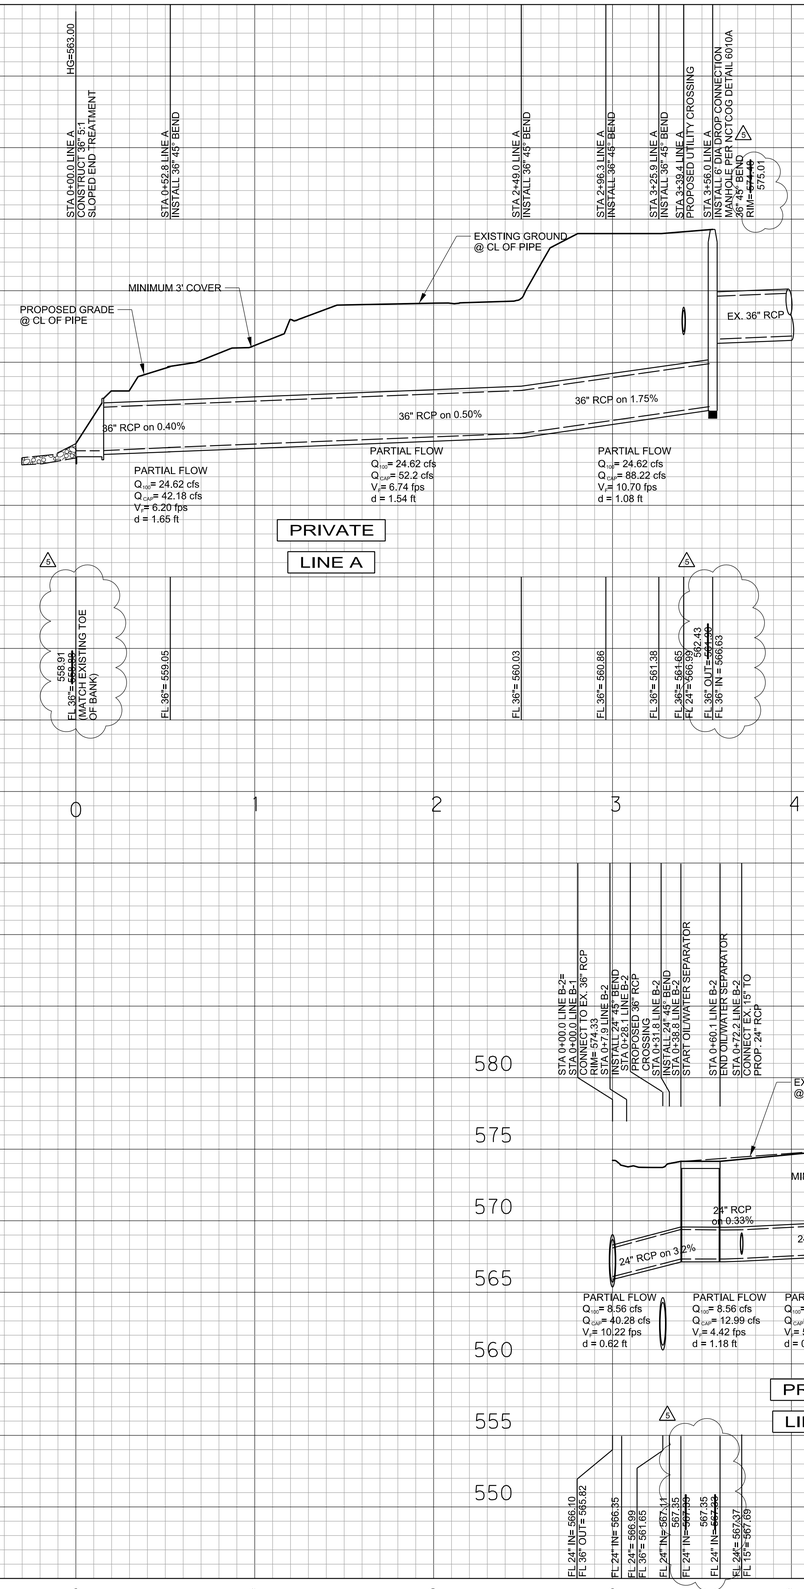

WHITMORE MANUFACTURING
STORM WATER COLLECTION AND TREATMENT EVALUATION
CITY OF ROCKWALL, TEXAS

HALFF
1201 NORTH BOWSER ROAD
RICHARDSON, TEXAS 75081-2275
TEL (214) 346-6200
FAX (214) 739-0095

Revision No.	Date	Description
1	4-2-2013	Revised as shown
2	5-28-2013	Revised as shown
3	11-4-2013	As Built Revision

Project No.:	29023
Issued:	JUNE, 2013
Drawn By:	CAD
Checked By:	DL
Scale:	AS NOTED

Sheet Title

STORM DRAINAGE PROFILES

C3.02

Sheet Number

11/19/2013 2:38:56 PM ah2401 HALFF I:\29000s\29023\CADD\C302-SDP-29023.dgn Untitled Sheet PDF_2D_MON_FW_150.plt