SANITARY SEWER LINE "A"

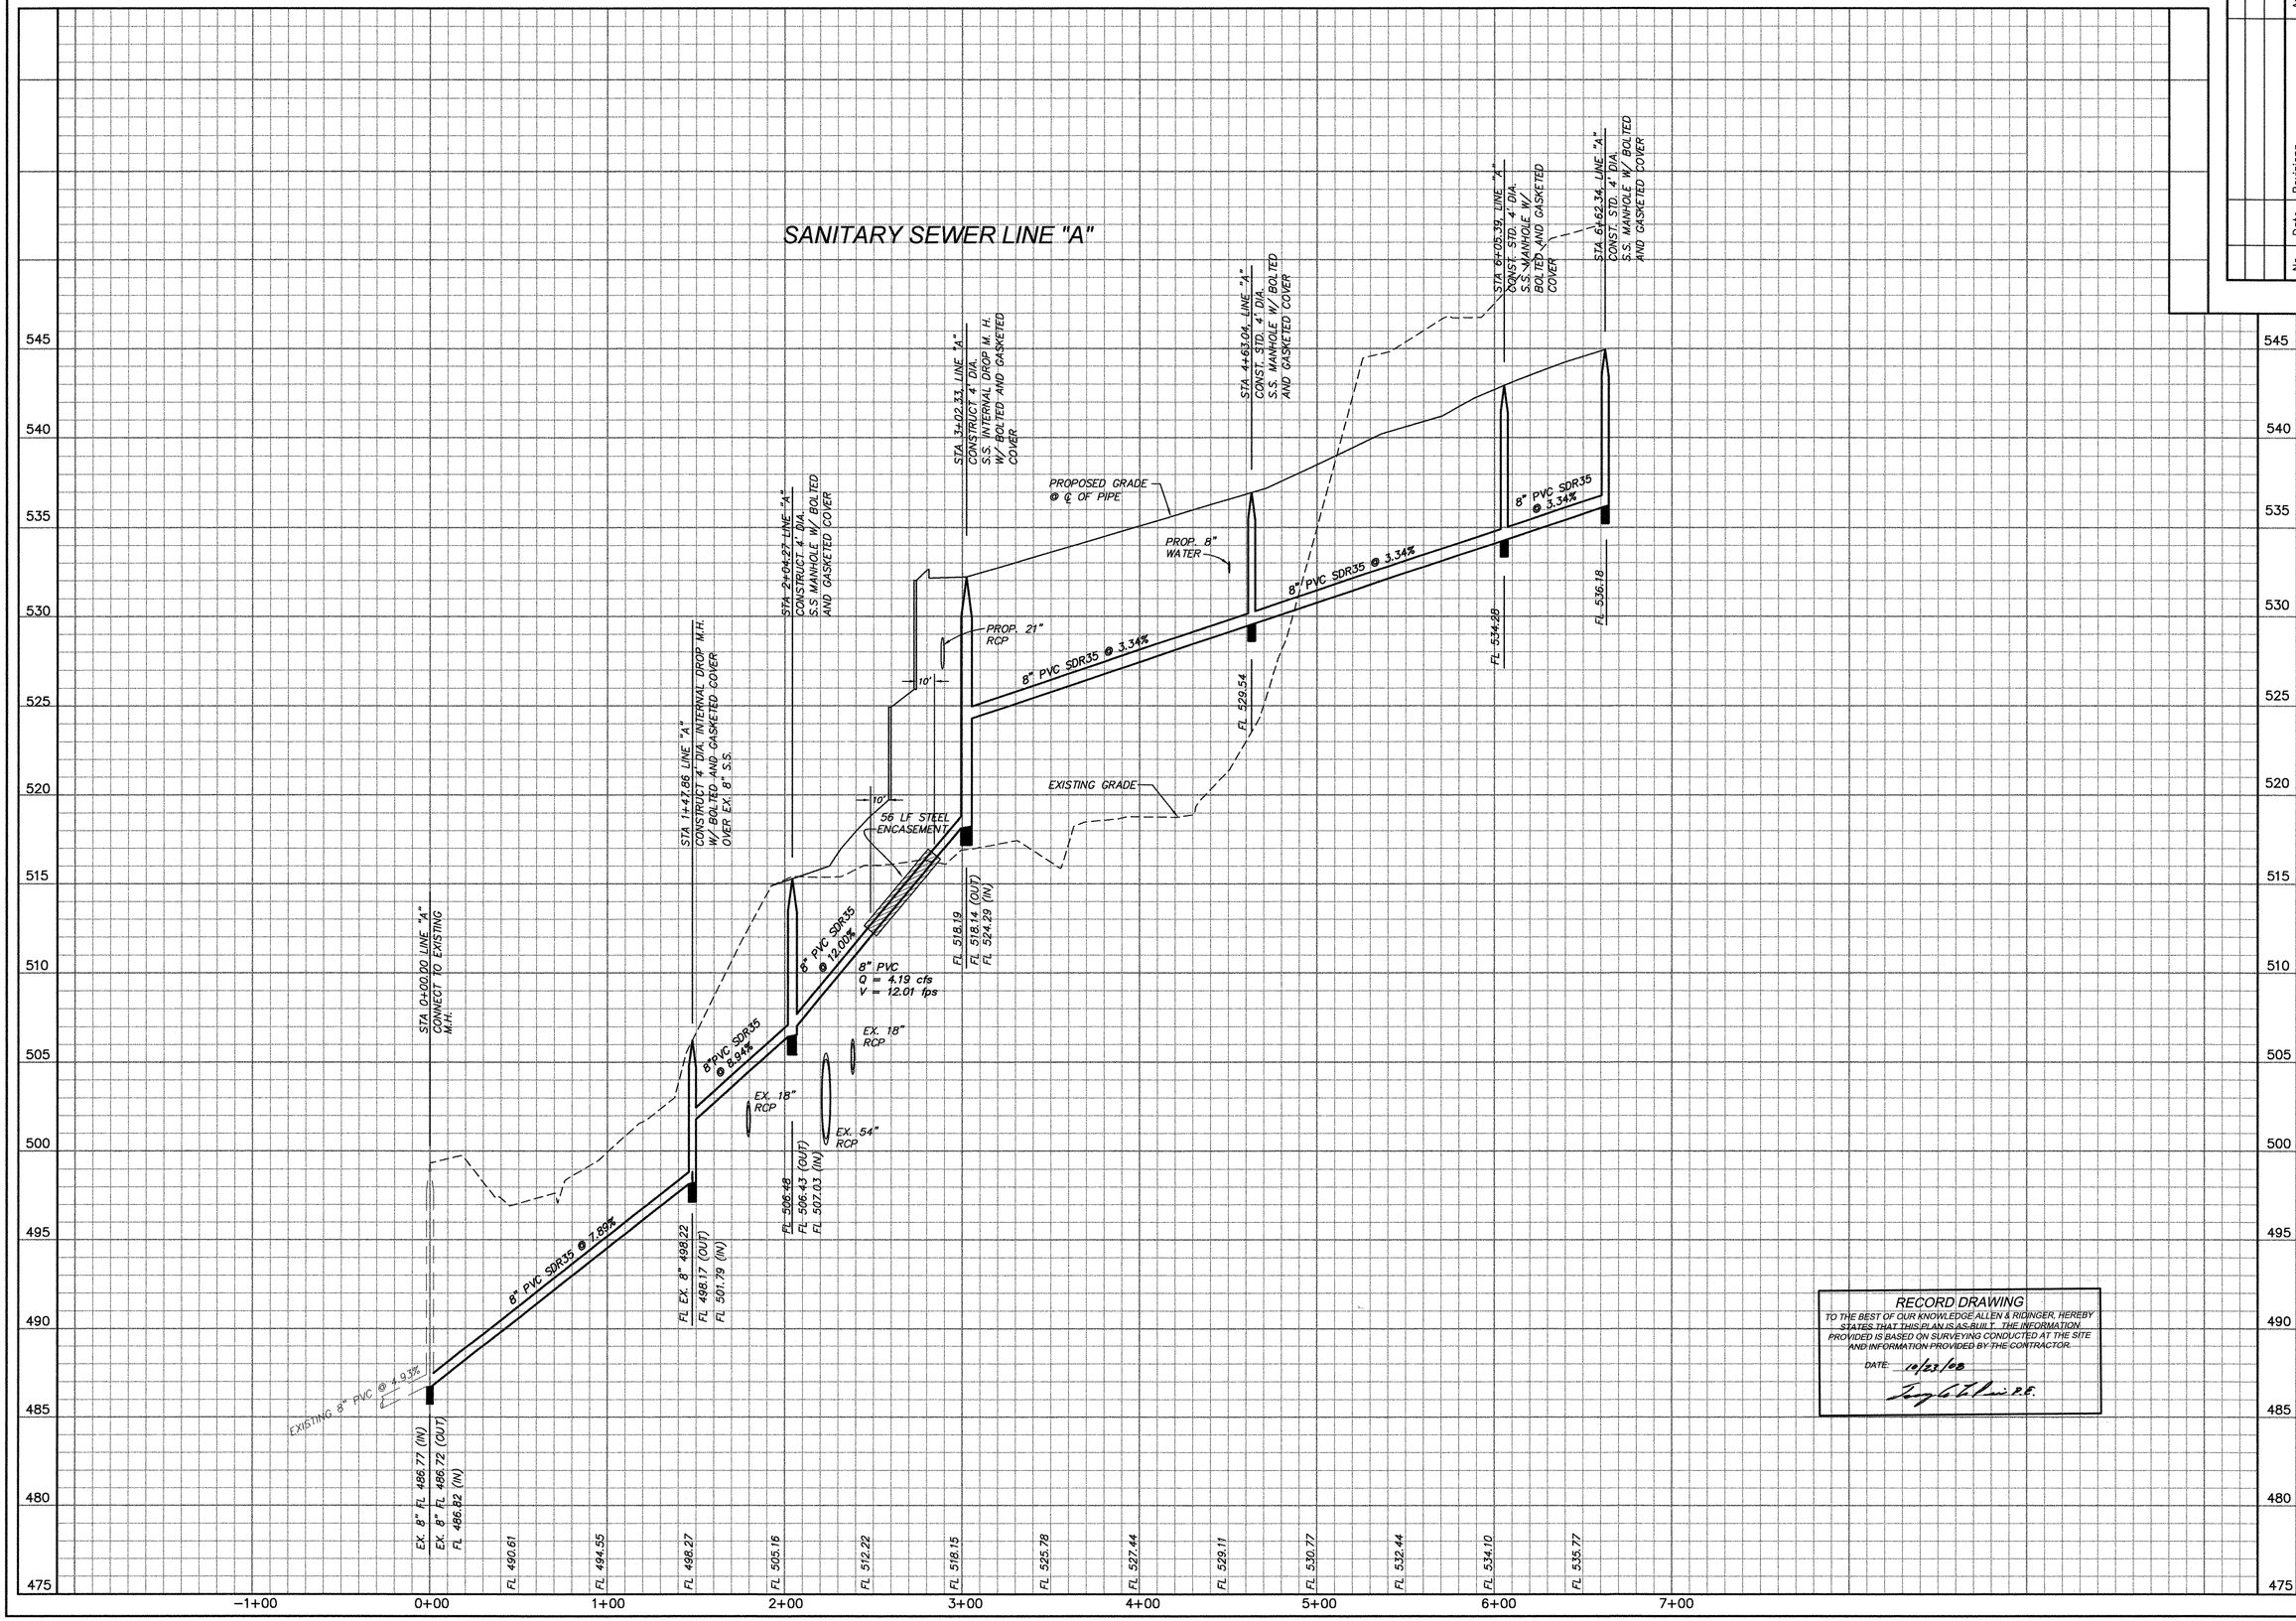

RECORD DRAWING

TO THE BEST OF OUR KNOWLEDGE ALLEN & RIDINGER, HEREBY STATES THAT THIS PLAN IS AS-BUILT THE INFORMATION PROVIDED IS BASED ON SURVEYING CONDUCTED AT THE SITE AND INFORMATION PROVIDED BY THE CONTRACTOR.

DATE: 10/23/08

Ingrid T. Lin P.E.

No.	Date	Revisions	App.

Allen & Ridinger Consulting, Inc.
285 W. Southwest Pkwy
Lewisville, Texas 75067
Tel. No. (972) 353-8000
Fax No. (972) 353-8011

STATE OF TEXAS
MICHAEL S. ALLEN
88188
LICENSED PROFESSIONAL ENGINEER
5/31/07

Wilkinson Commons
ROCKWALL, TEXAS

SANITARY SEWER PROFILE
LINE "A"

Scale: 1"= 40' HORZ., 1"= 4' VERT.	
Designed by:	LHR
Drawn by:	JWH
Checked by:	MSA
Date:	MAY 29, 2007
Project No.	070-001

SHEET
C-5
OF 10

3D:\Jobs \Projects\070-001 wilkinson la jolla\dp drfiles\TXCOC\ENVA-DS-29-DTYDC SEPROA.dwg, 5/30/2007 2:48:50 PM, Jim Hughes, 1:40