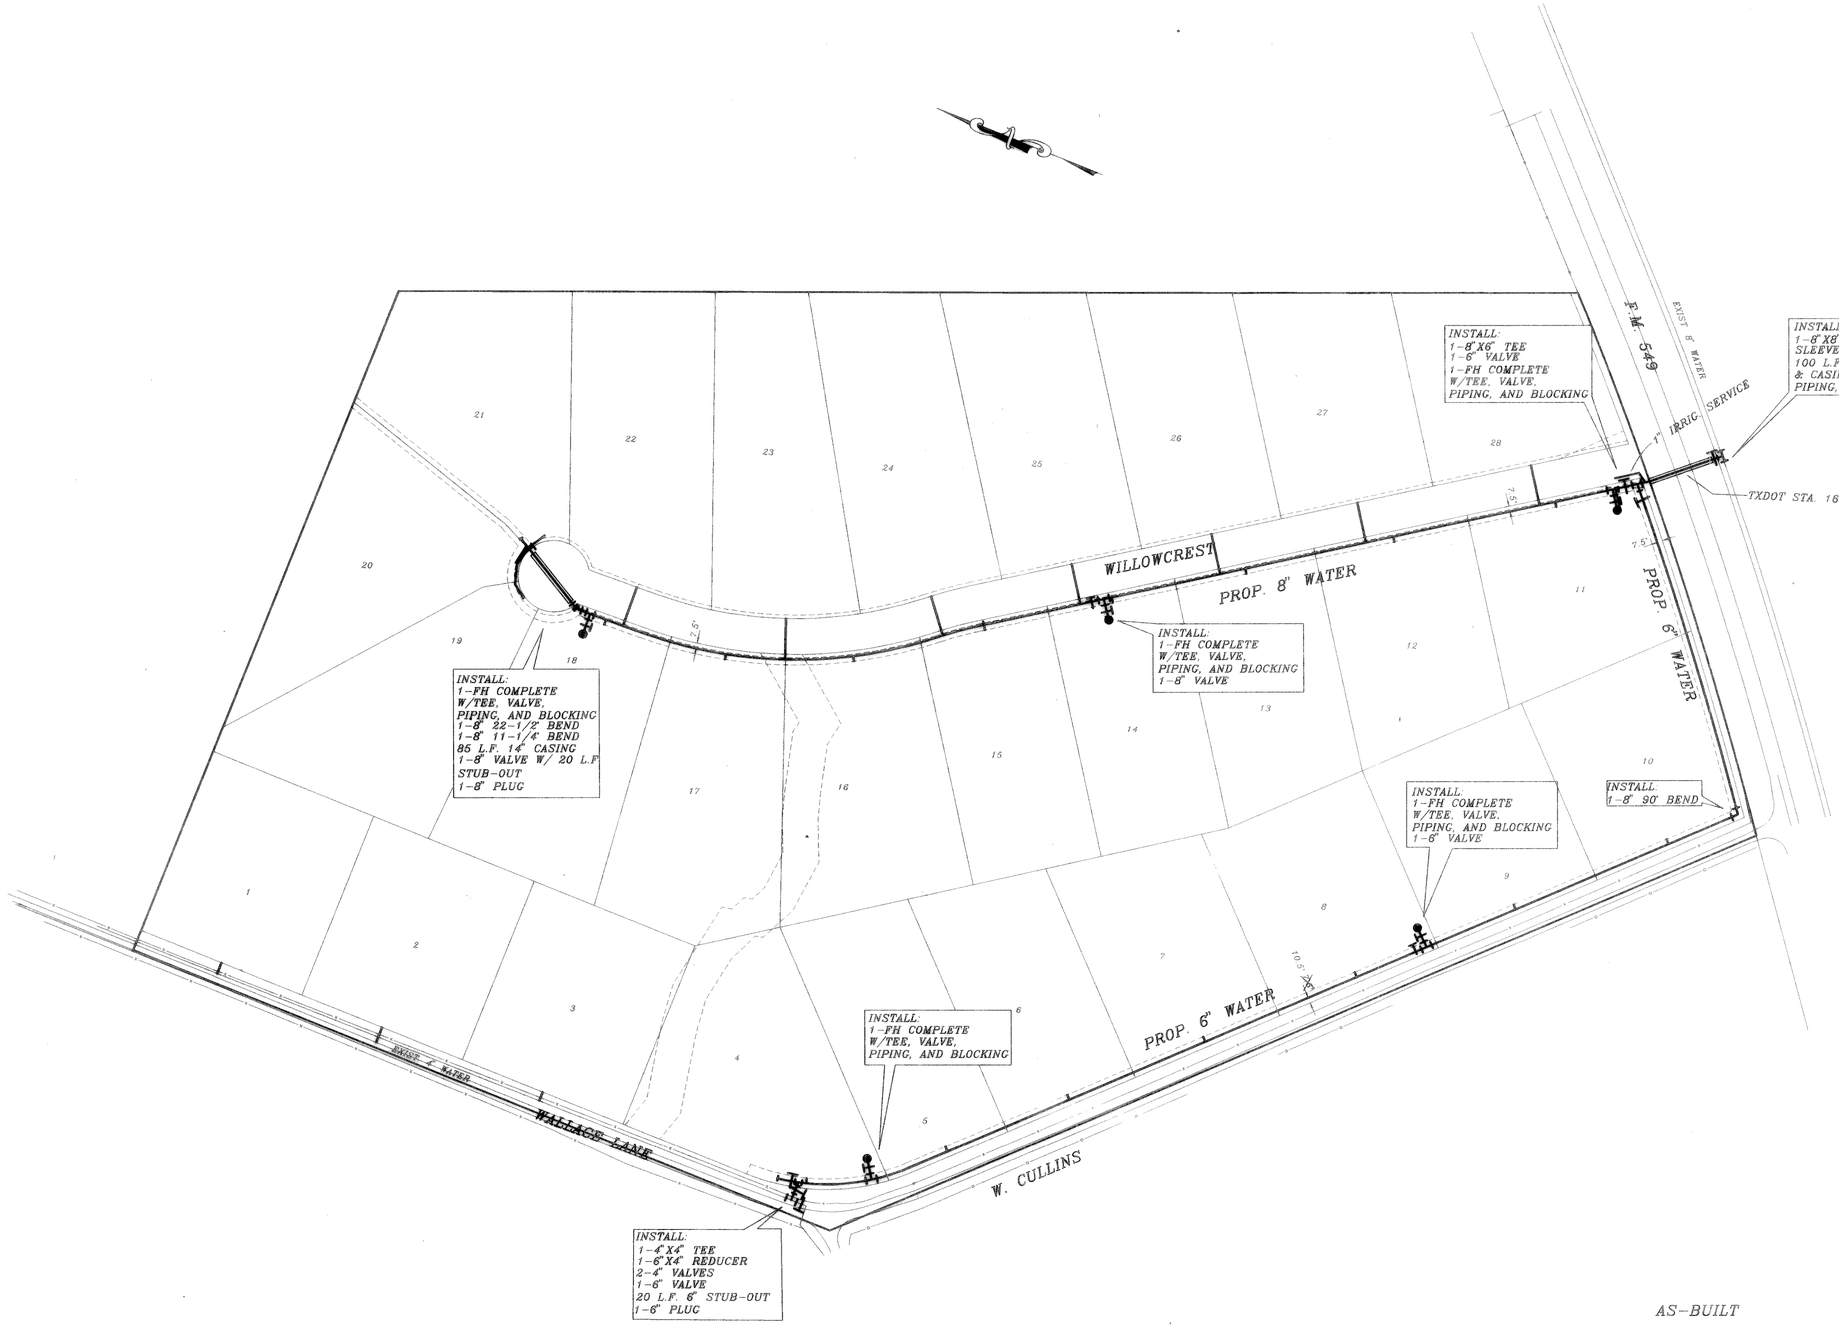

WATER PROFILE

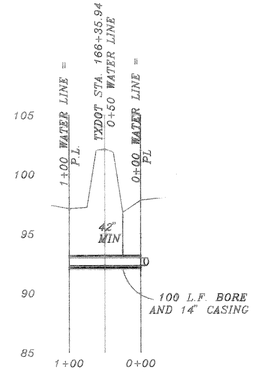

AS-BUILT

STATE OF TEXAS
HAROLD L. EVANS
23155
REGISTERED PROFESSIONAL ENGINEER

	9624WS2
ADDED WATER PROFILE	6/6/96
REV - 10' R.O.W. DED.	5/10/96
REV. PER W.S.C. COMMENTS	4/29/96

REVISION DESCRIPTION

HAROLD L. EVANS
CONSULTING ENGINEER
P.O. BOX 28355
2331 GUS THOMASSON ROAD, SUITE 102
DALLAS, TEXAS 75228 (214) 328-8133

DATE	SCALE	DESIGN	DRAWN
4/27/96	1" = 100'	H.L.E.	

PROPOSED WATER
WILLOWCREST ESTATES
ROCKWALL COUNTY, TEXAS

SHEET NO. 5/5

JOB NO. 9624