


# Horizon Rd. Cut & Plugs

7-14-2015

Curtis Mcaden

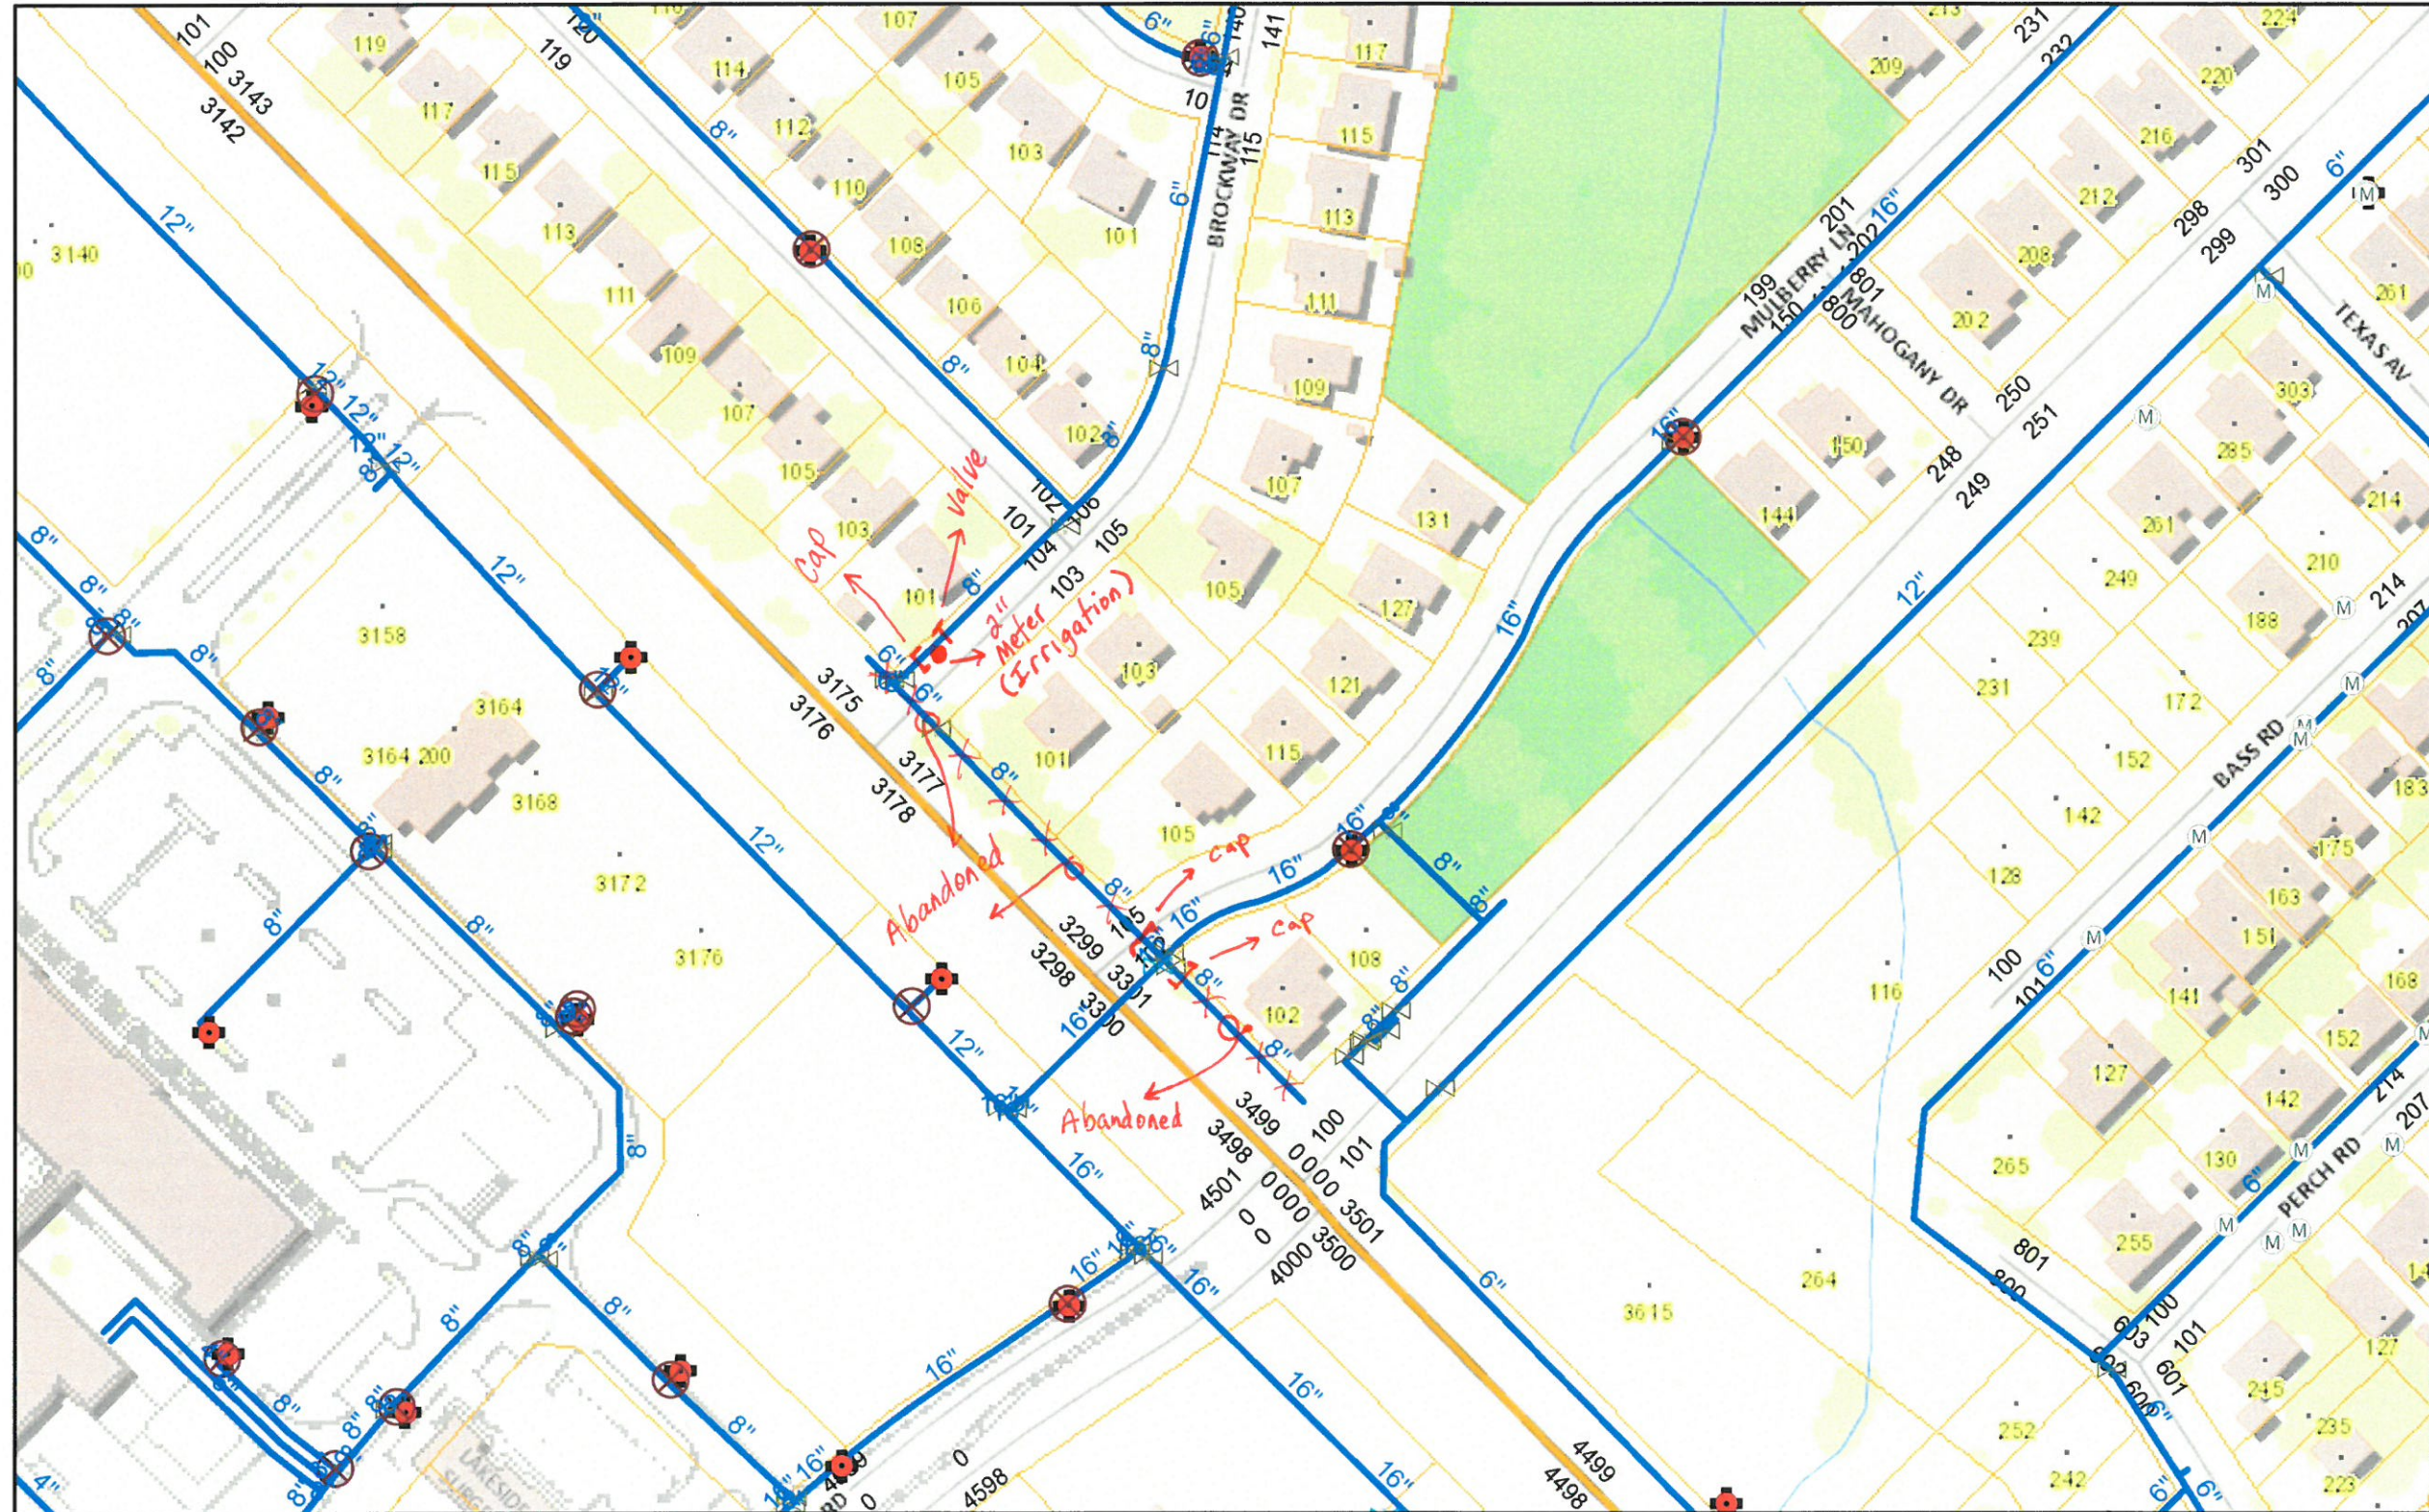

July 15, 2015

- ADDRESS\_POINTS
- M Water Meters
- Water Source

**Water Valves**

