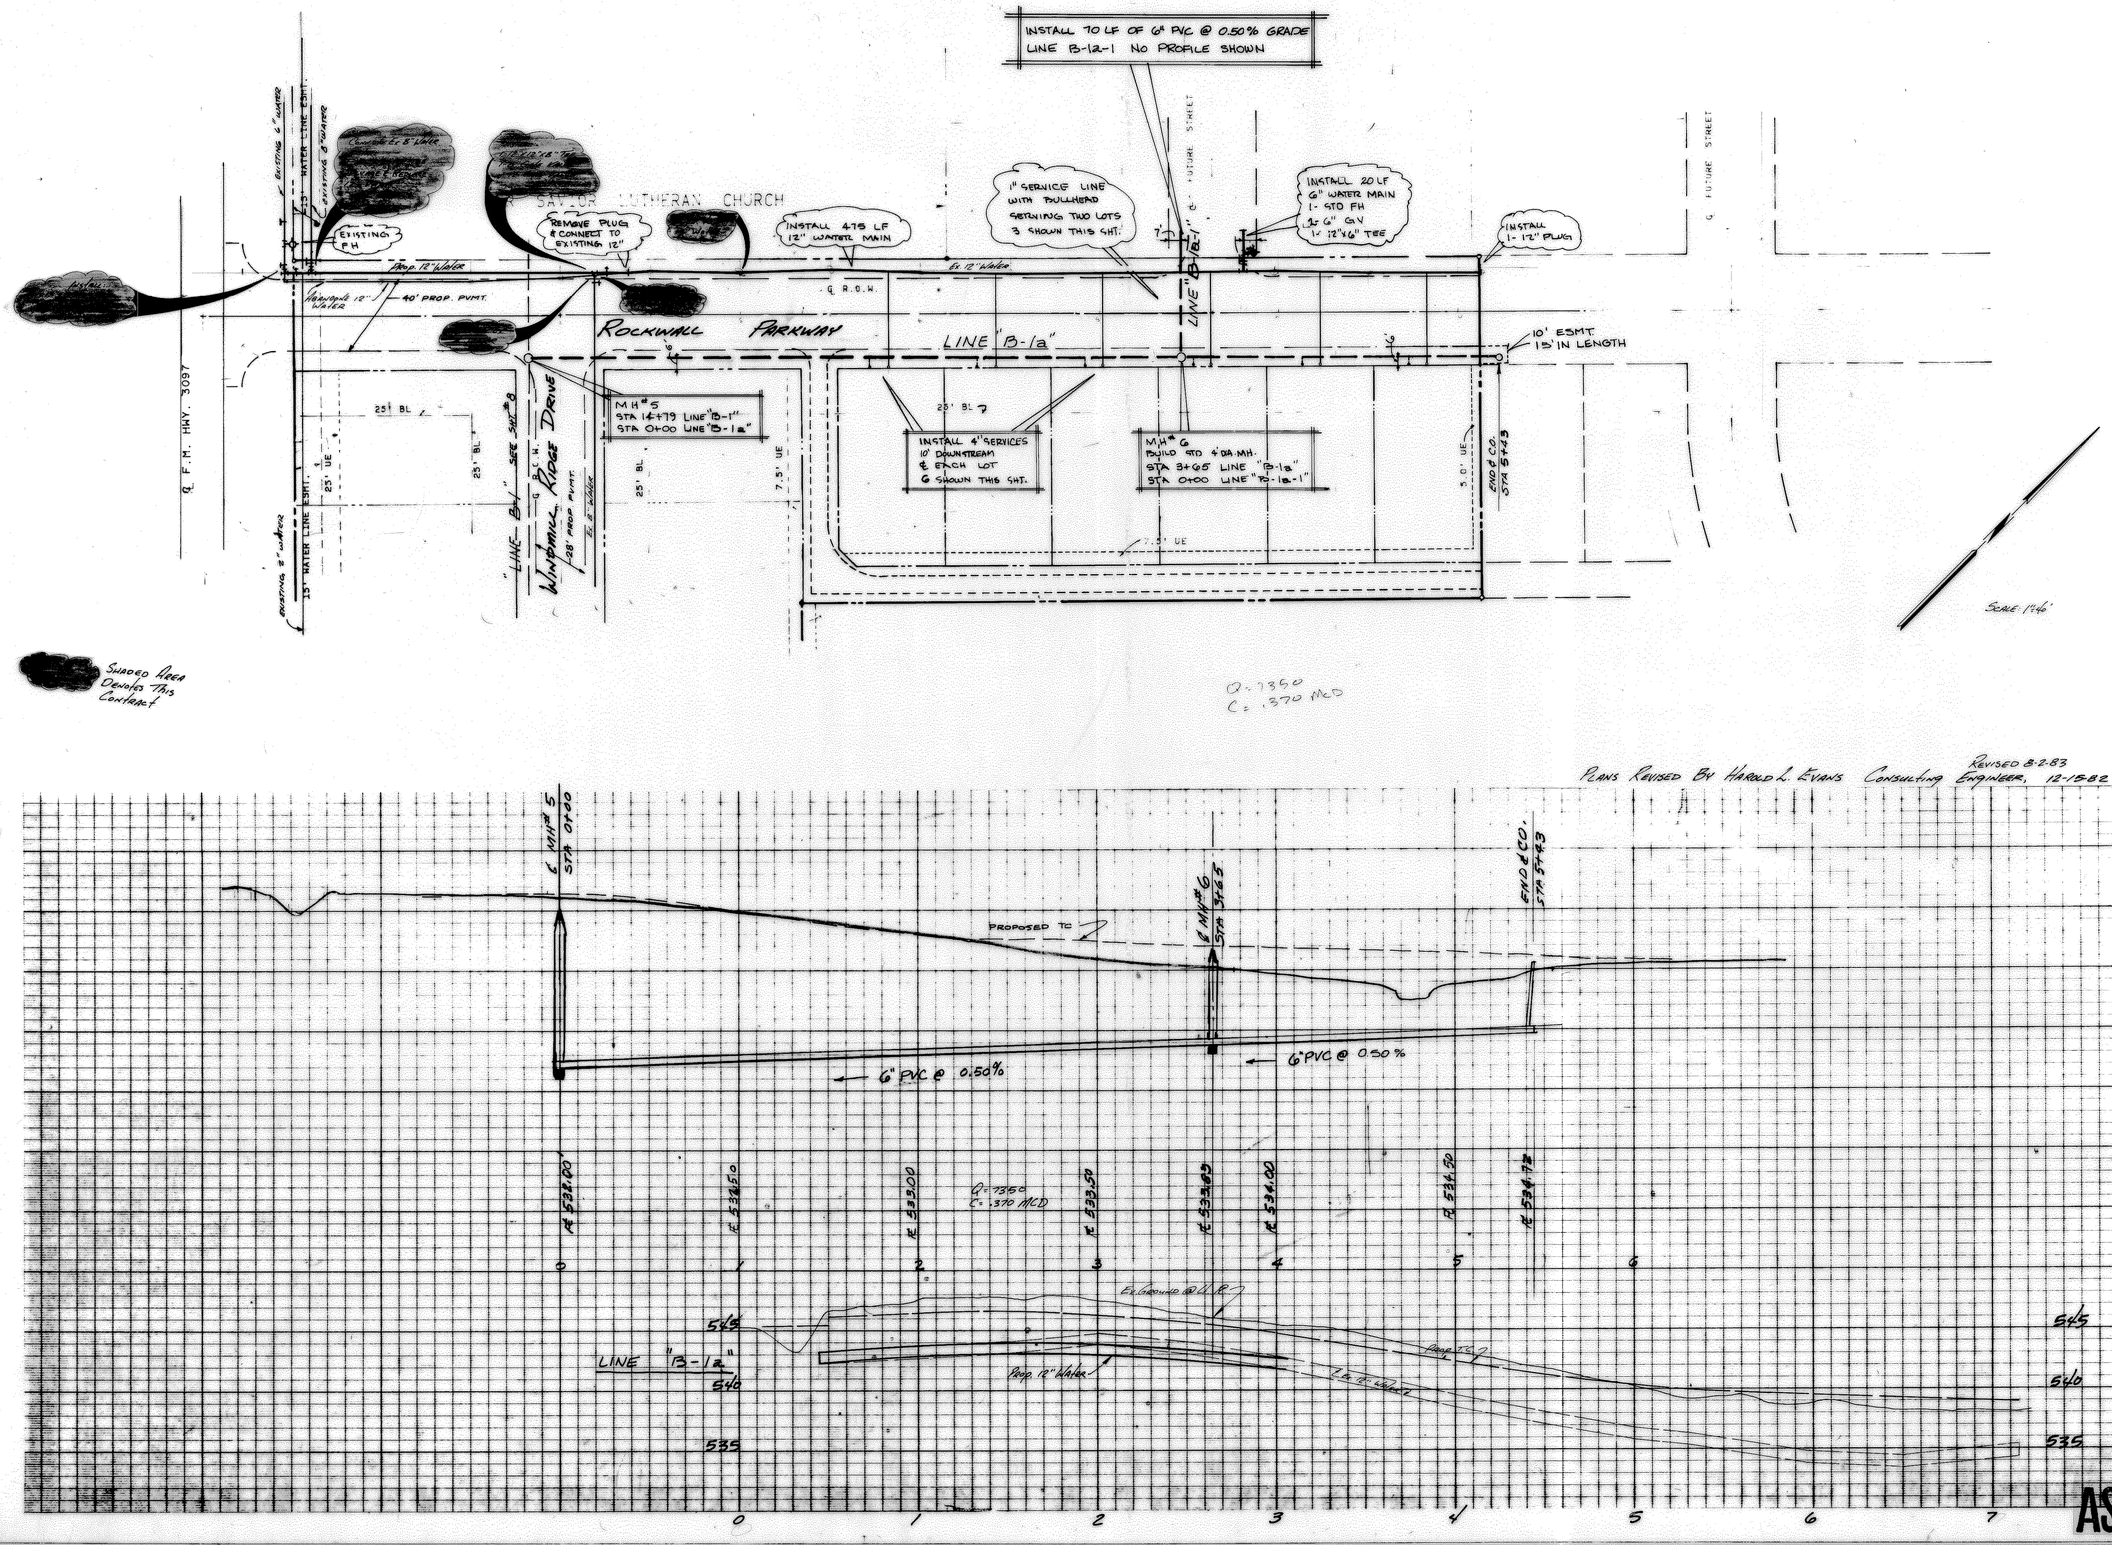

The A.E. Group, Inc.
architects and engineers
8585 N. Stemmons Fwy. · Suite 1100- (214) 630-0823

WATER AND SANITARY SEWER IMPROVEMENTS
WINDMILL RIDGE ESTATES
SECTION "A" INSTALLMENT ONE
ROCKWALL, TEXAS

a development of
EDK INC
8585 STEMMONS FREEWAY · SUITE 816 · DALLAS, TEXAS 75247 · 214/630-1303

9

82112