

Entered Data: Culvert Calculator

Shape Rectangular
 Number of Barrels 2
 Solving for Headwater
 Chart Number 1
 Scale Number 1
 Chart Description CONCRETE PIPE CULVERT; NO BEVELED RING ENTRANCE
 Scale Description SQUARE EDGE ENTRANCE WITH HEADWALL
 Flowrate 368.2400 cfs
 Manning's n 0.0130
 Roadway Elevation 561.3300 ft
 Inlet Elevation 554.4400 ft
 Outlet Elevation 553.9300 ft
 Height 48.0000 in
 Width 84.0000 in
 Length 102.0700 ft
 Entrance Loss 0.5000
 Tailwater 4.0000 ft

Computed Results:
 Headwater 559.1817 ft Outlet Control
 Slope 0.0050 ft/ft
 Velocity 6.5757 fps

Messages:
 Outlet head > Inlet head.
 Headwater: 559.1817 ft

DIS-CHARGE FLOW	HEAD-WATER ELEV	INLET CONTROL DEPTH	OUTLET CONTROL DEPTH	FLOW TYPE	NORMAL DEPTH	CRITICAL DEPTH	VEL	OUTLET DEPTH	VEL	TAILWATER DEPTH
cfs	ft	ft	ft		in	in	fps	ft	fps	ft
37.25	557.98	1.44	3.54	NA	10.18	33.37	1.33	2.52	0.00	4.00
74.51	558.13	2.34	3.69	NA	16.11	33.37	2.66	2.52	0.00	4.00
111.76	558.39	3.14	3.95	NA	21.26	33.37	3.99	2.52	0.00	4.00
149.02	558.75	3.89	4.31	NA	26.07	33.37	5.32	2.52	0.00	4.00
186.27	559.21	4.63	4.77	NA	30.50	33.37	6.65	2.52	0.00	4.00
223.52	559.77	5.22	5.33	NA	34.83	33.37	7.98	2.52	0.00	4.00
260.78	560.56	6.12	6.00	NA	39.02	42.09	11.46	3.25	0.00	4.00
298.03	561.33	6.89	6.77	NA	48.00	48.00	10.64	4.00	0.00	4.00
335.29	561.33	0.00	6.89	NA	48.00	48.00	11.97	4.00	0.00	4.00

Entered Data: Culvert Calculator



Shape Rectangular
 Number of Barrels 2
 Solving for Headwater
 Chart Number 1
 Scale Number 1
 Chart Description CONCRETE PIPE CULVERT; NO BEVELED RING ENTRANCE
 Scale Description SQUARE EDGE ENTRANCE WITH HEADWALL
 Flowrate 277.2000 cfs
 Manning's n 0.0130
 Roadway Elevation 567.0000 ft
 Inlet Elevation 561.6400 ft
 Outlet Elevation 560.1900 ft
 Height 36.0000 in
 Width 96.0000 in
 Length 208.6900 ft
 Entrance Loss 0.5000
 Tailwater 3.0000 ft

Computed Results:
 Headwater 565.1142 ft Inlet Control
 Slope 0.0069 ft/ft
 Velocity 10.5263 fps

Messages:
 Inlet head > Outlet head.
 Headwater: 565.1142 ft

DIS-CHARGE FLOW	HEAD-WATER ELEV	INLET CONTROL DEPTH	OUTLET CONTROL DEPTH	FLOW TYPE	NORMAL DEPTH	CRITICAL DEPTH	VEL	OUTLET DEPTH	VEL	TAILWATER DEPTH
cfs	ft	ft	ft		in	in	fps	ft	fps	ft
55.16	563.39	1.75	1.75	NA	10.73	13.67	7.71	0.89	0.00	3.00
110.31	564.55	2.91	2.34	NA	16.93	21.70	9.77	1.41	0.00	3.00
165.47	565.55	3.91	3.33	NA	22.29	28.43	11.13	1.86	0.00	3.00
220.62	567.00	5.36	4.72	NA	27.22	34.44	12.16	2.27	0.00	3.00
275.78	567.00	0.00	5.36	NA	36.00	34.44	11.49	2.27	0.00	3.00

BENCHMARK: NW CORNER OF CONCRETE HEADWALL, +/- 285' EAST OF THE SOUTHEAST LOT CORNER OF TRACT & ALONG N. ROW LINE OF HWY 276. ELEV 581.52.

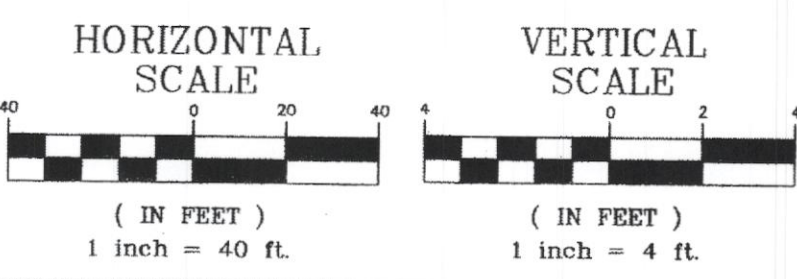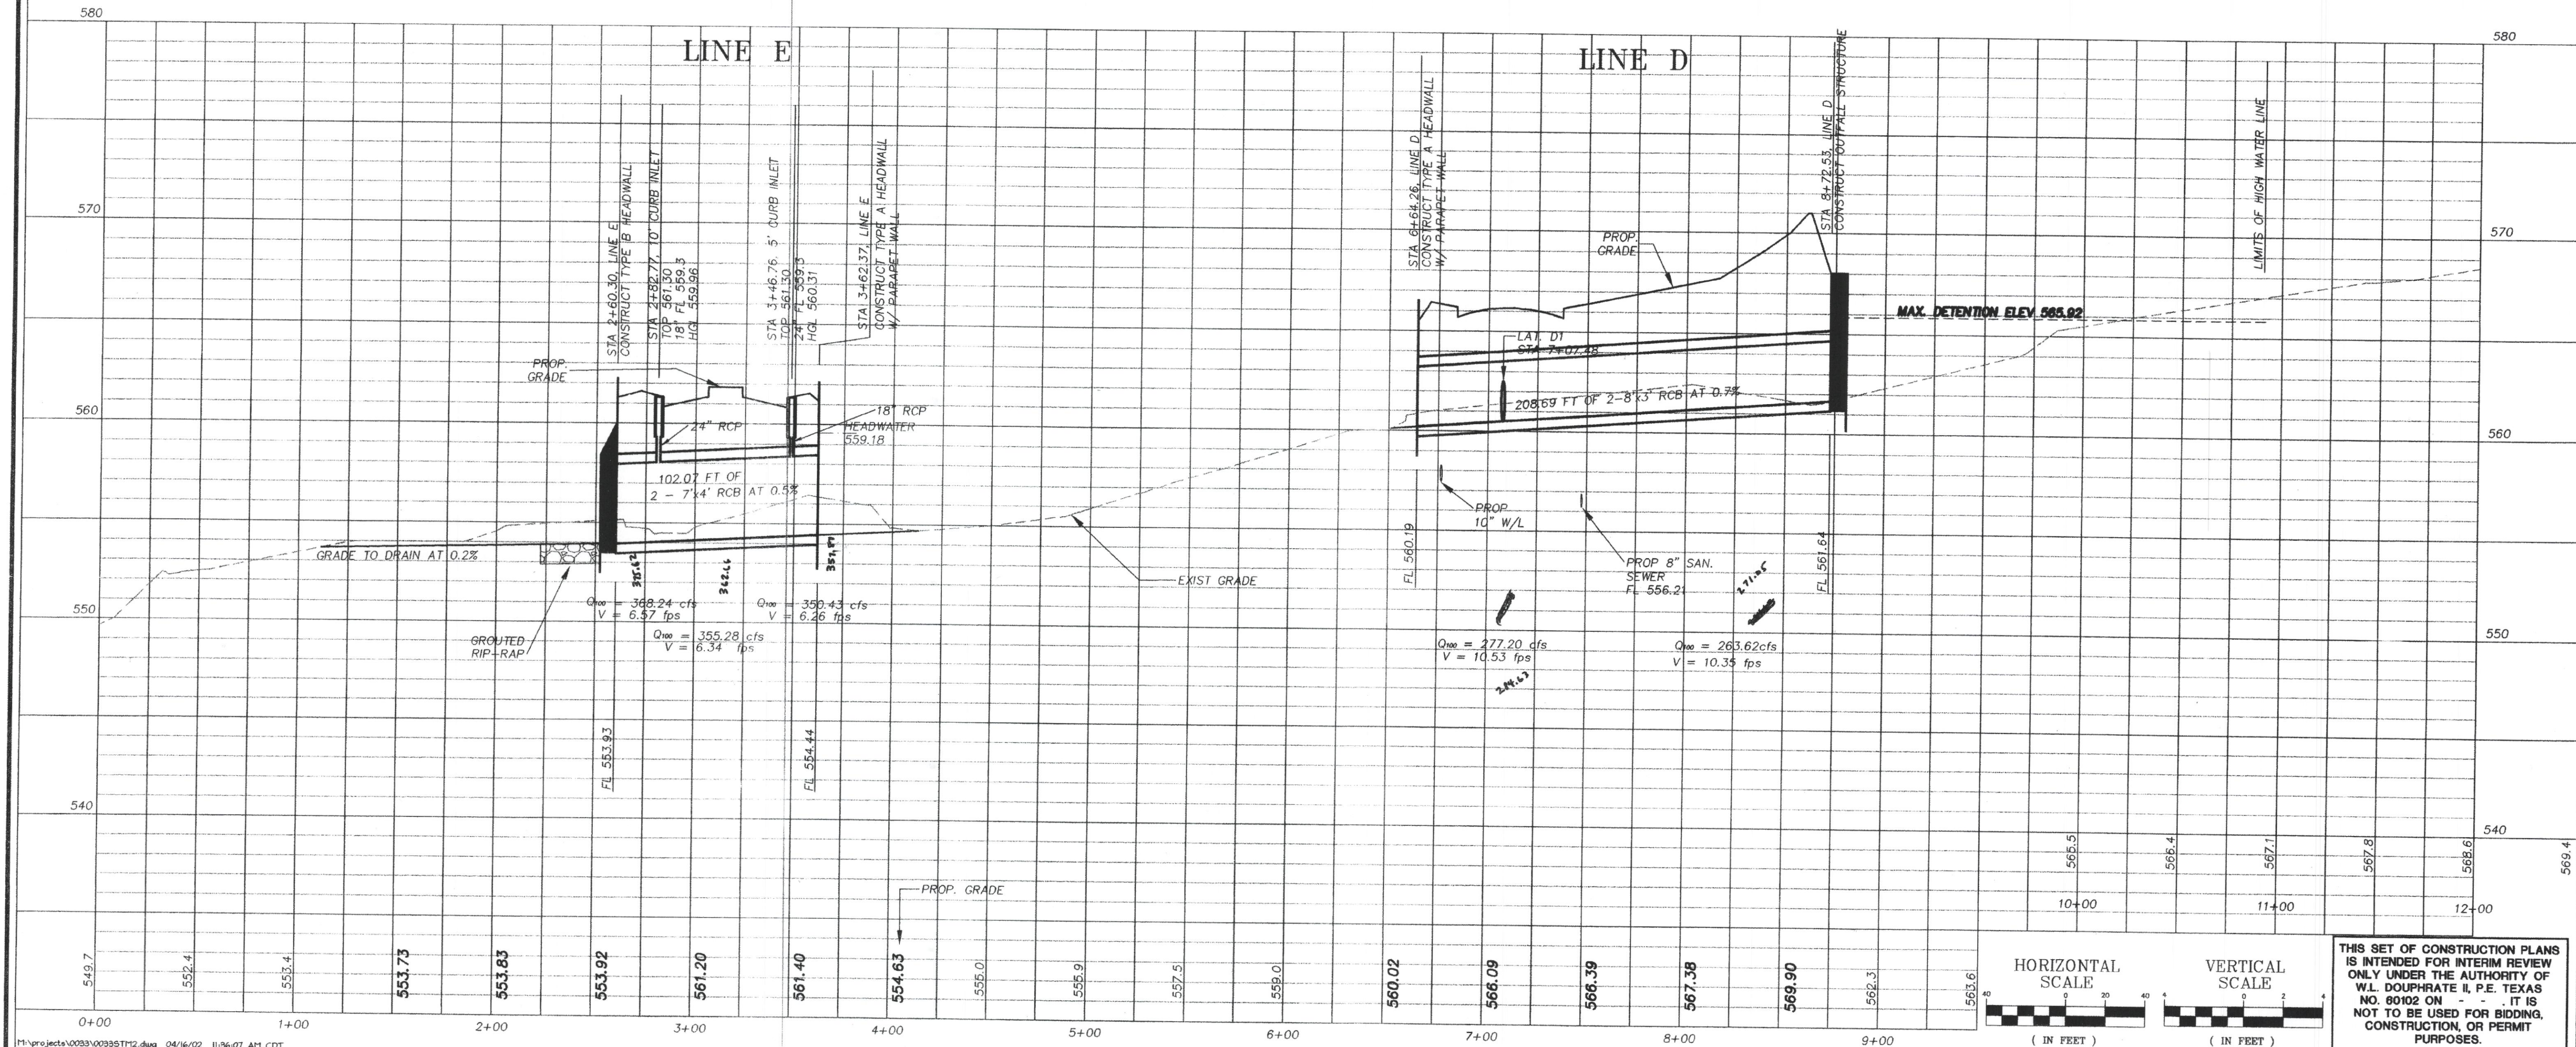

THIS SET OF CONSTRUCTION PLANS IS INTENDED FOR INTERIM REVIEW ONLY UNDER THE AUTHORITY OF W.L. DOUPHRATE II, P.E. TEXAS NO. 60102 ON - IT IS NOT TO BE USED FOR BIDDING, CONSTRUCTION, OR PERMIT PURPOSES.



THE SEAL APPEARING ON THIS DOCUMENT IS AUTHORIZED BY W.L. DOUPHRATE II, P.E. NO. 60102 ON

DOUPHRATE & ASSOCIATES, INC.
 ENGINEERING - PROJECT MANAGEMENT - SURVEYING
 2235 RIDGE RD., # 200 ROCKWALL, TEXAS 75087
 PHONE: (972)771-9004 FAX: (972)771-9005

STORM SEWER - LINE D AND E PROFILE
 ROCKWALL DISTRIBUTION COMPLEX - PH. I
 CITY OF ROCKWALL, ROCKWALL COUNTY, TEXAS

REVISION	DATE	BY
- FILED CITY COMMENTS	08/23/01	
- FILED DEVELOPER	07/07/06	
CHECKED	W.L.D.	
DRAWN	AL	
DATE	08/01	
DRAWING	0033STM2	
PROJECT	0033	
	14	