Storm Drain Line A

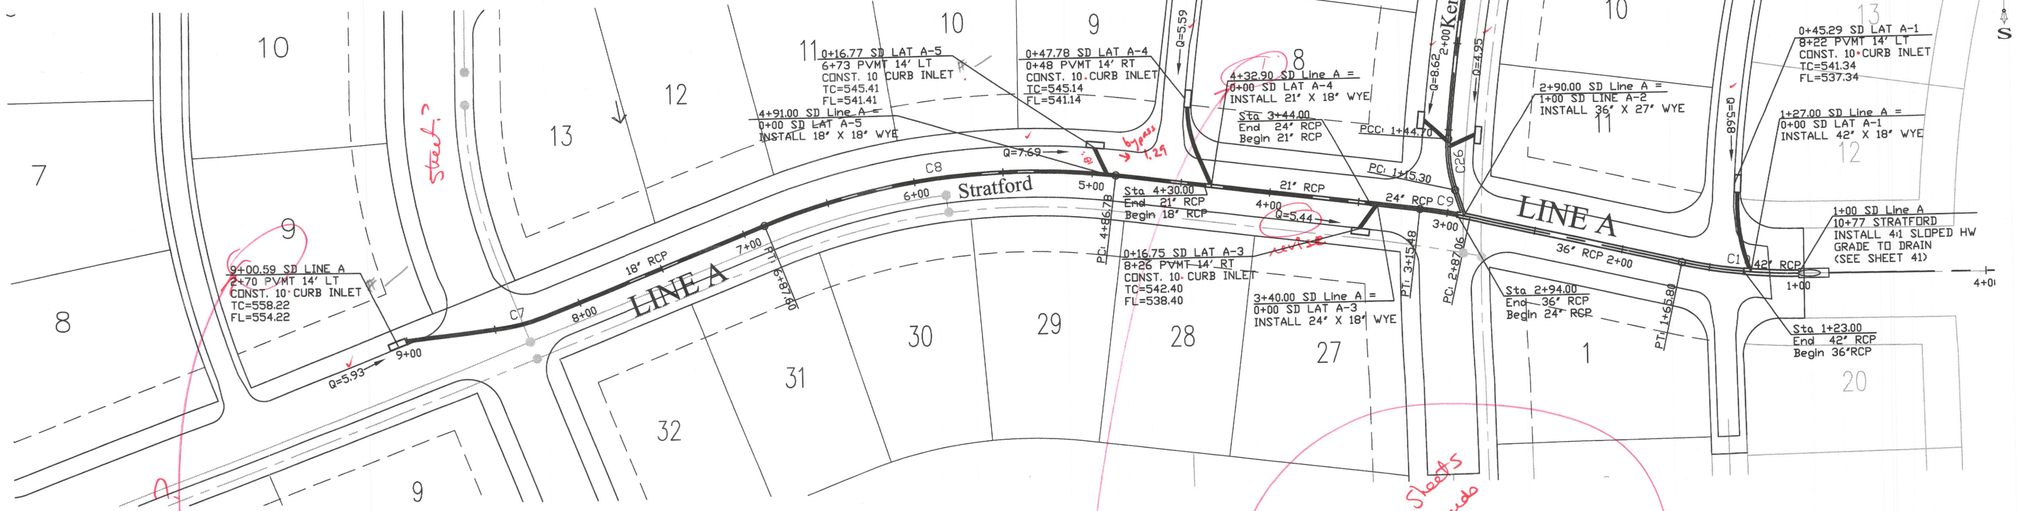

SD CENTERLINE CURVE TABLE				
CURVE	DELTA	RADIUS	LENGTH	CHORD	BEARING
C7	14°25'8"	100.00	25.17	25.10	N 76°4'39" E
C8	28°45'52"	400.00	200.81	198.71	S 83°15'1" W
C9	5°25'43"	300.00	28.42	28.41	N 79°39'12" W
C10	12°34'0"	300.00	65.80	65.67	S 83°13'20" E

All Storm Sheets
- Every inlet needs to be labeled w/ HGL or room with grates (Yes)
- Label size of all callouts on plan view

SD Line A PROFILE

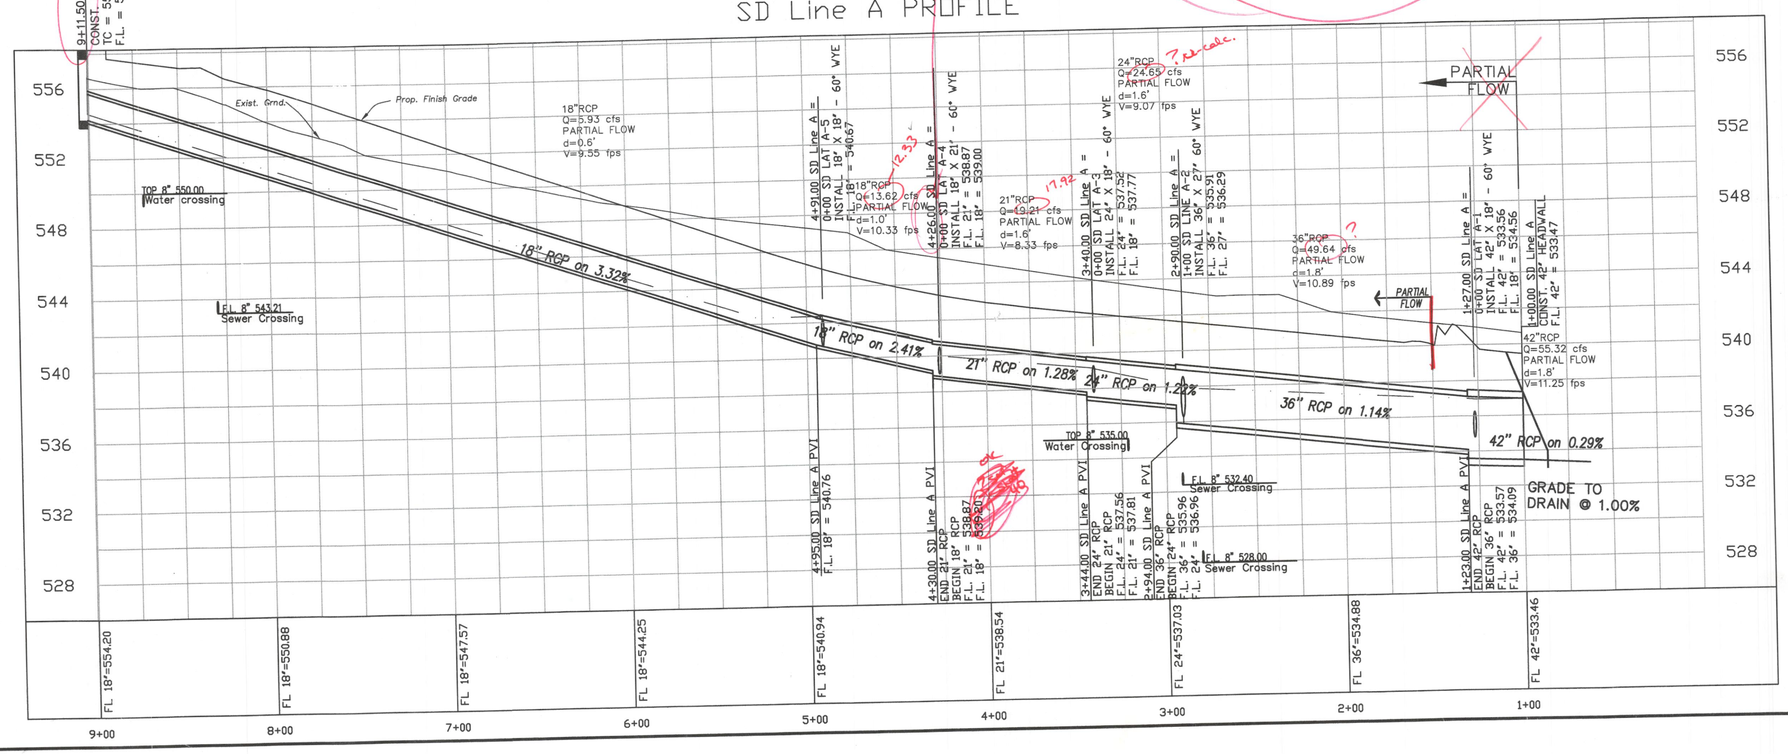

Revision	Date	Description

Owner:
SPRING HAVEN INVESTMENTS, INC.
6750 HILLCREST PLAZA DR. • STE 325
DALLAS, TEXAS 75230 • Phone: 972-386-3333

The Highlands

F.C. CUNY CORPORATION
#2 Horizon Court • Ste. 500 • Heath, Texas 75032
Phone: 469-402-7700
Fax: 469-402-0700

THE SEAL APPEARING ON THIS DOCUMENT WAS AUTHORIZED BY CHRISTOPHER R. CUNY, P.E. 65642

STATE OF TEXAS
CHRISTOPHER R. CUNY
65642
REGISTERED
PROFESSIONAL ENGINEER

Drawn By:	Checked By:
MSC	JW
Date: 09/25/2007	Project No.: 06-004

Sheet Title:
Storm Drain Line A Plan & Profile

Scale:	Sheet No.:
1" = 40'	32 of 61