



Turner

Construction Managers/General Contractors
460 West Dussel Drive
Maumee, Ohio 43537
p | 419.893.7000 f | 419.893.1741
www.turnerconstruction.com/lathrop

CONSULTANTS:

PREPARED BY:
WIA WIER & ASSOCIATES, INC.
ENGINEERS SURVEYORS LAND PLANNERS
701 HIGHLANDER BLVD., SUITE 300 ARLINGTON, TEXAS 76015 METRO (817)467-7700
6849 ELM STREET FRISCO, TEXAS 75034 METRO (214)267-8800
Texas Firm Registration No. F-2776 www.WierAssociates.com

SEAL ON THIS DOCUMENT AUTHORIZED BY:



SEAL ID: *BJL*
DATE: *5/19/12*

PROJECT INFORMATION:

ROCKWALL TECHNOLOGY PARK PHASE III BIMBO BAKERIES USA ROCKWALL, TEXAS

CLIENT INFORMATION:

ALLEN FOODS, INC
3055 Discovery Blvd.
Rockwall, Texas
75032

CLIENT PROJECT NO: **00-00000-00**


NO.	DATE	SUBJECT
1	XXXXXX	REVISION NAME
	X	

PROJECT NO: **WA # 12002**
PROJECT MANAGER: **RON RAMIREZ, P.E.**
DESIGNED: **RON RAMIREZ, P.E.**
CHECKED: **RON RAMIREZ, P.E.**

DRAWING TITLE:
DRAINAGE AREA MAP

DRAWING NO: **C-D101**

DATE: 03-20-2012

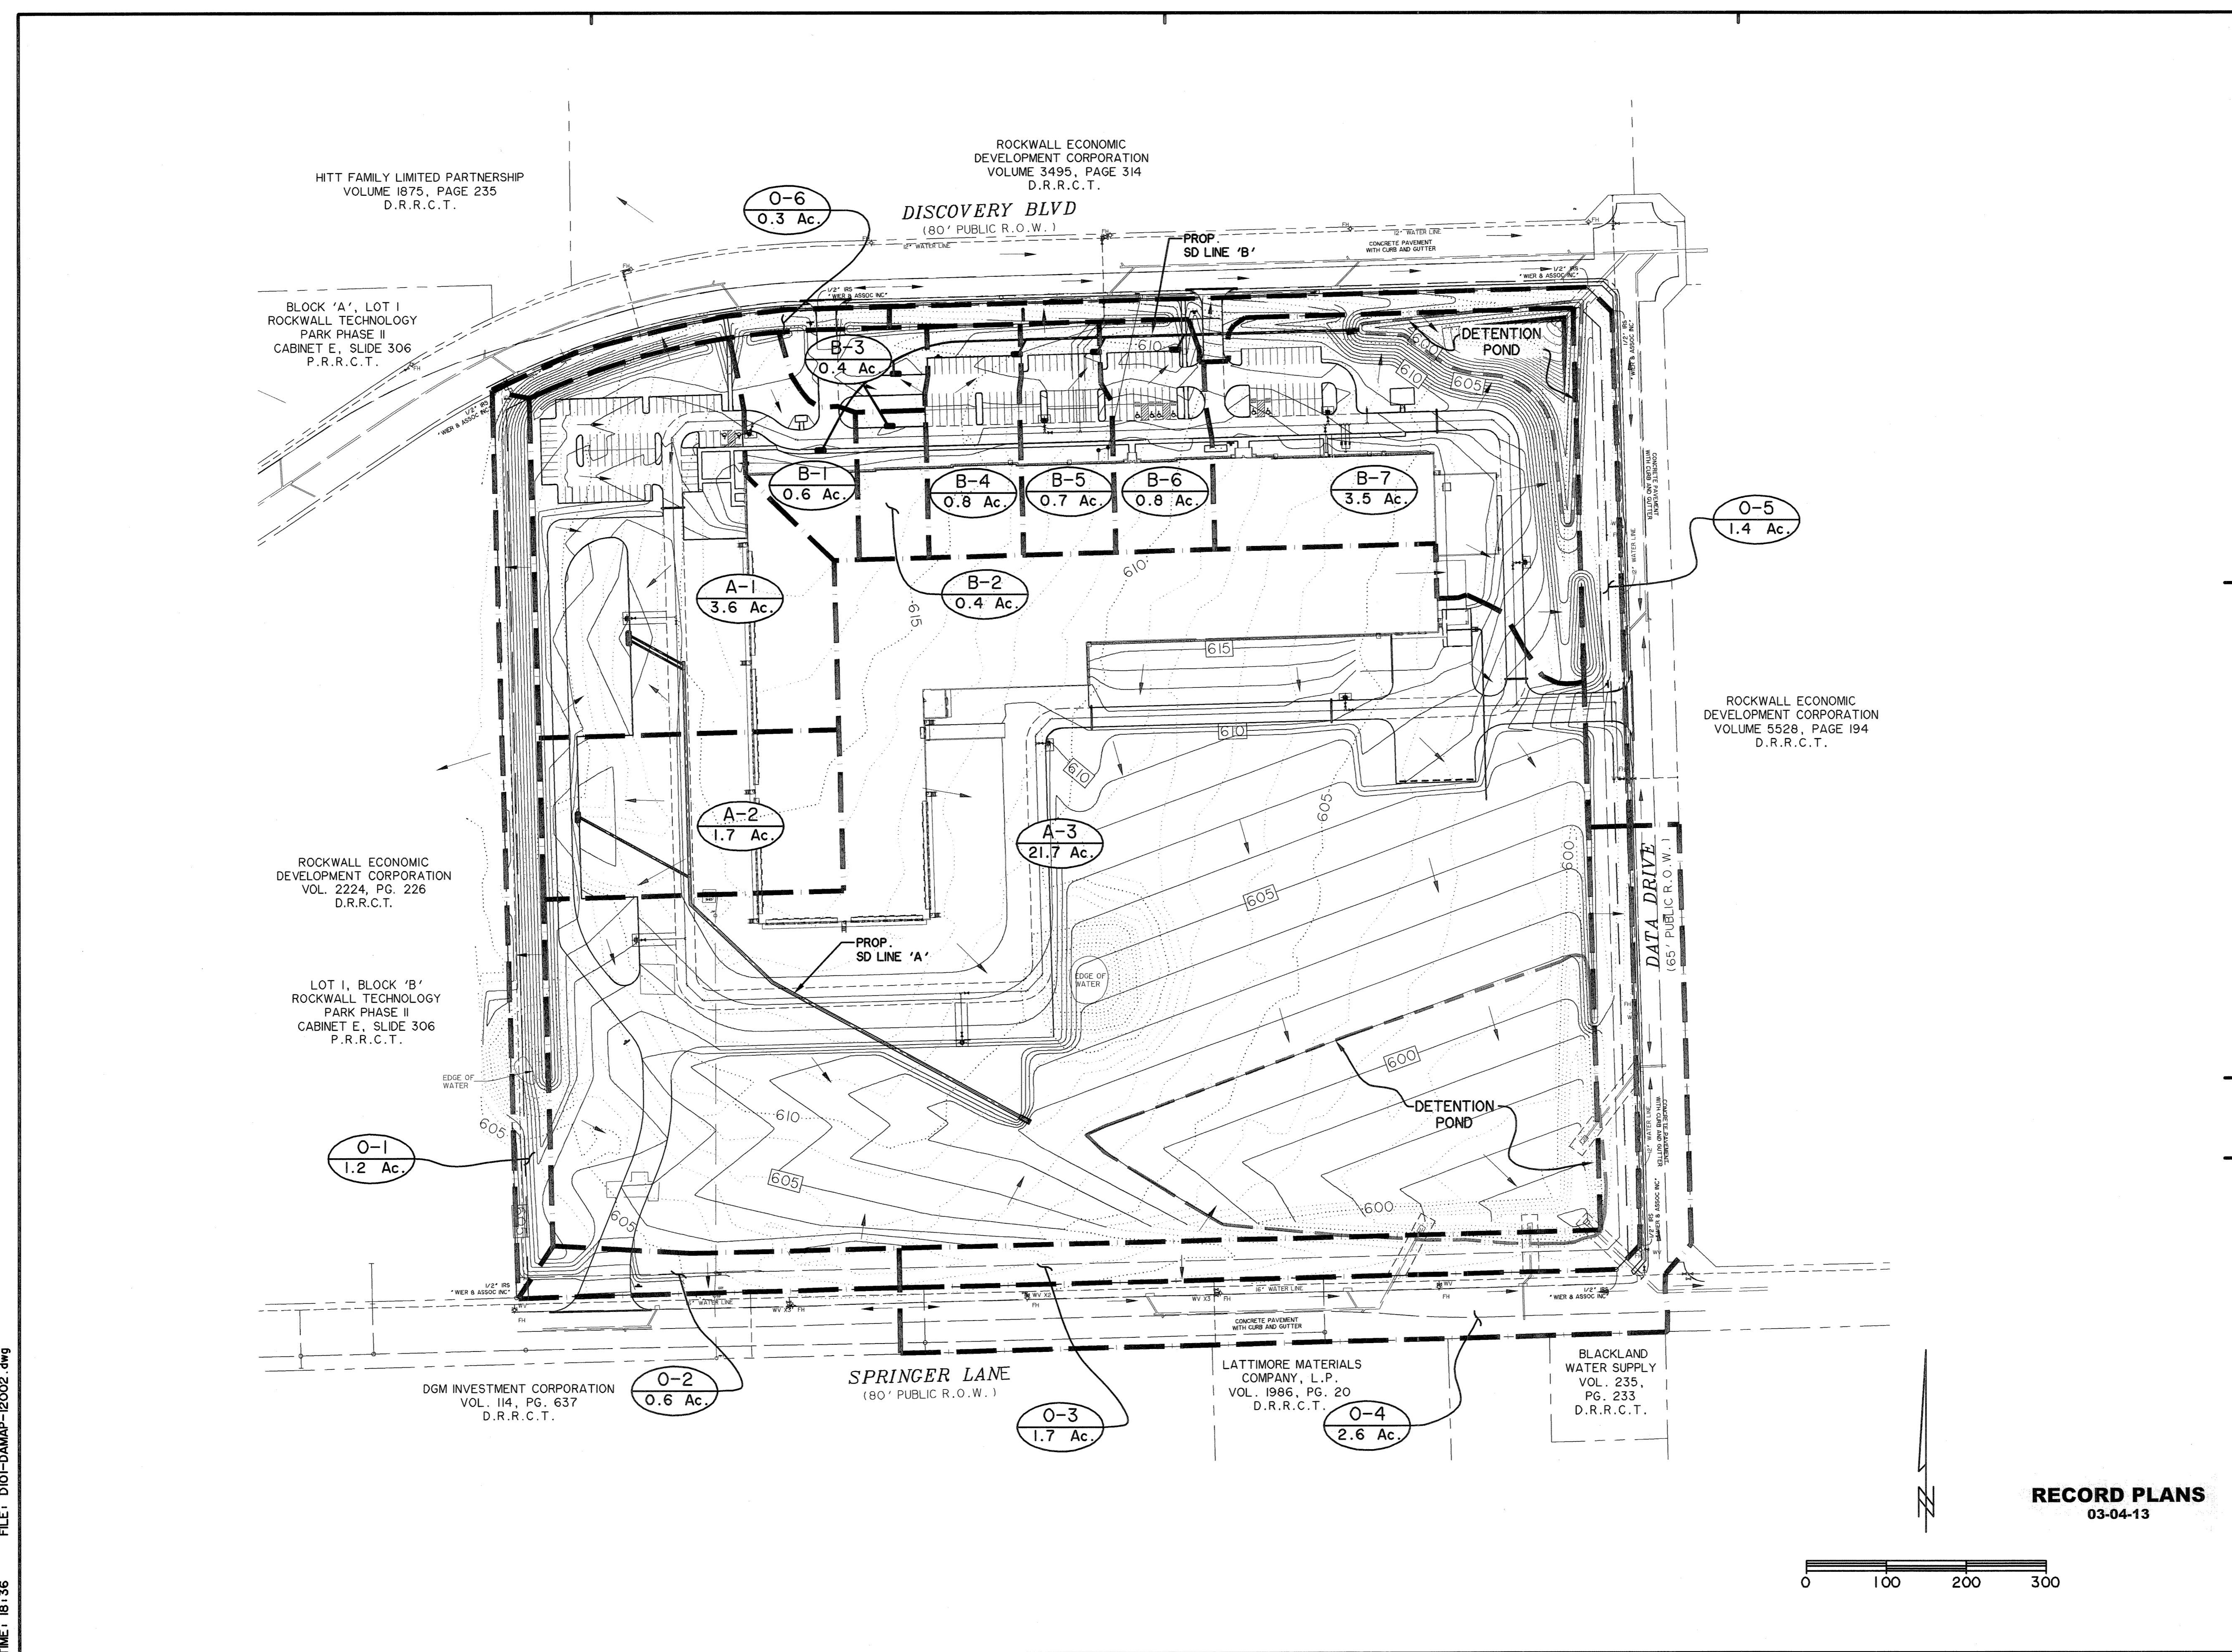

FILE: D:\01-DAMAP-12002.dwg
JME: 18:36