NO.	DATE	REVISION	APPROV.
1	8/30/00	REVISED INLET LOCATION AT STA. 3+51.18	JFW
2	10/09/01	REVISED PER CONSTRUCTION RECORDS	JFW
3			

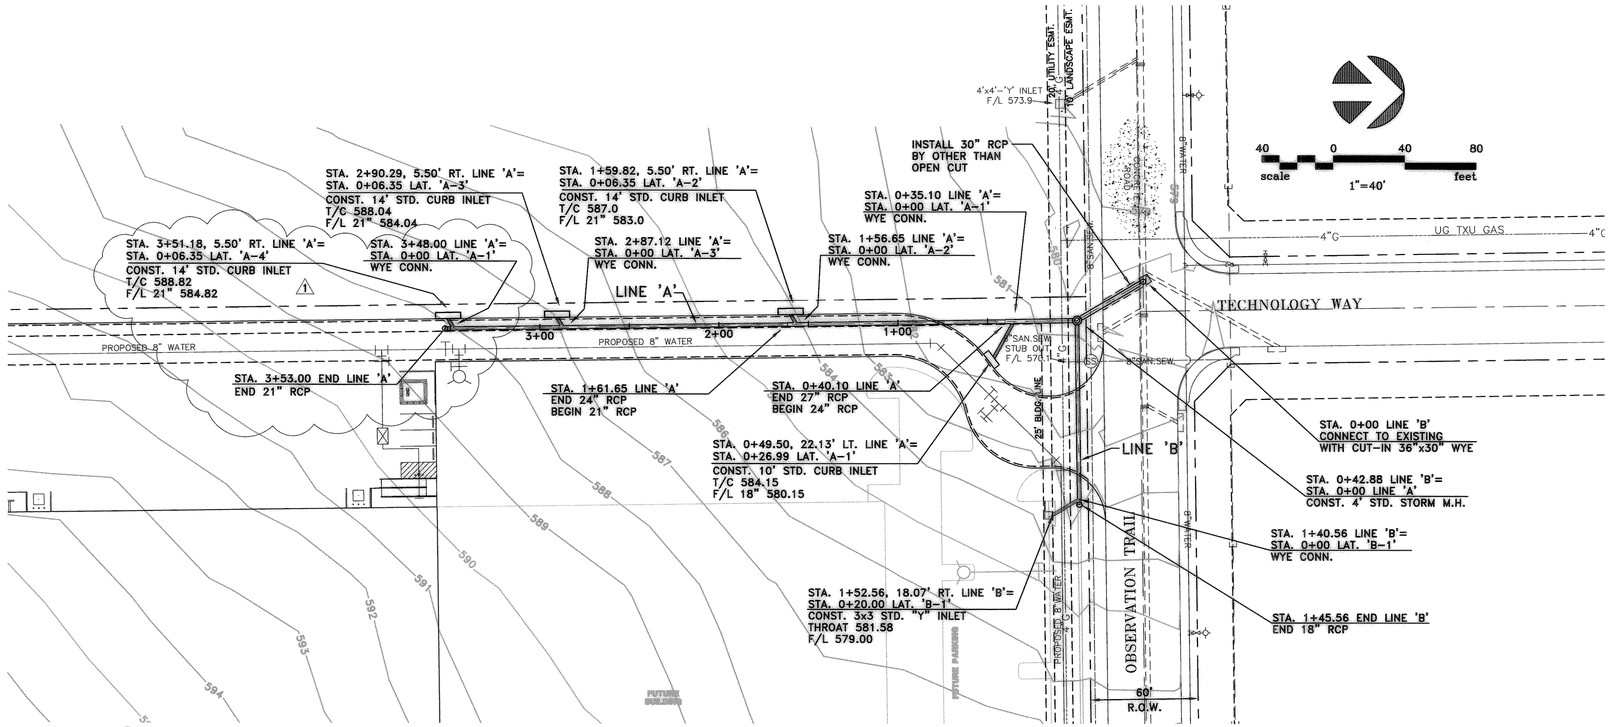

!! CAUTION !!

EXISTING AND/OR PROPOSED UTILITIES IN AREA.
CONTRACTOR SHALL CONTACT THE PROPER UTILITY COMPANIES AT LEAST 48 HOURS PRIOR TO CONSTRUCTION.
THESE CONTACTS SHALL INCLUDE, BUT NOT BE LIMITED TO THE FOLLOWING COMPANIES:

TXU ELECTRIC	972-485-6277
TXU GAS	1-800-725-0934
NORTH TEXAS CABLE COM.	972-771-0202
SOUTHWESTERN BELL TELEPHONE	214-320-5307

2

RECORD DRAWING
BASED ON CONTRACTOR MARKUPS, NOT FIELD SURVEY.

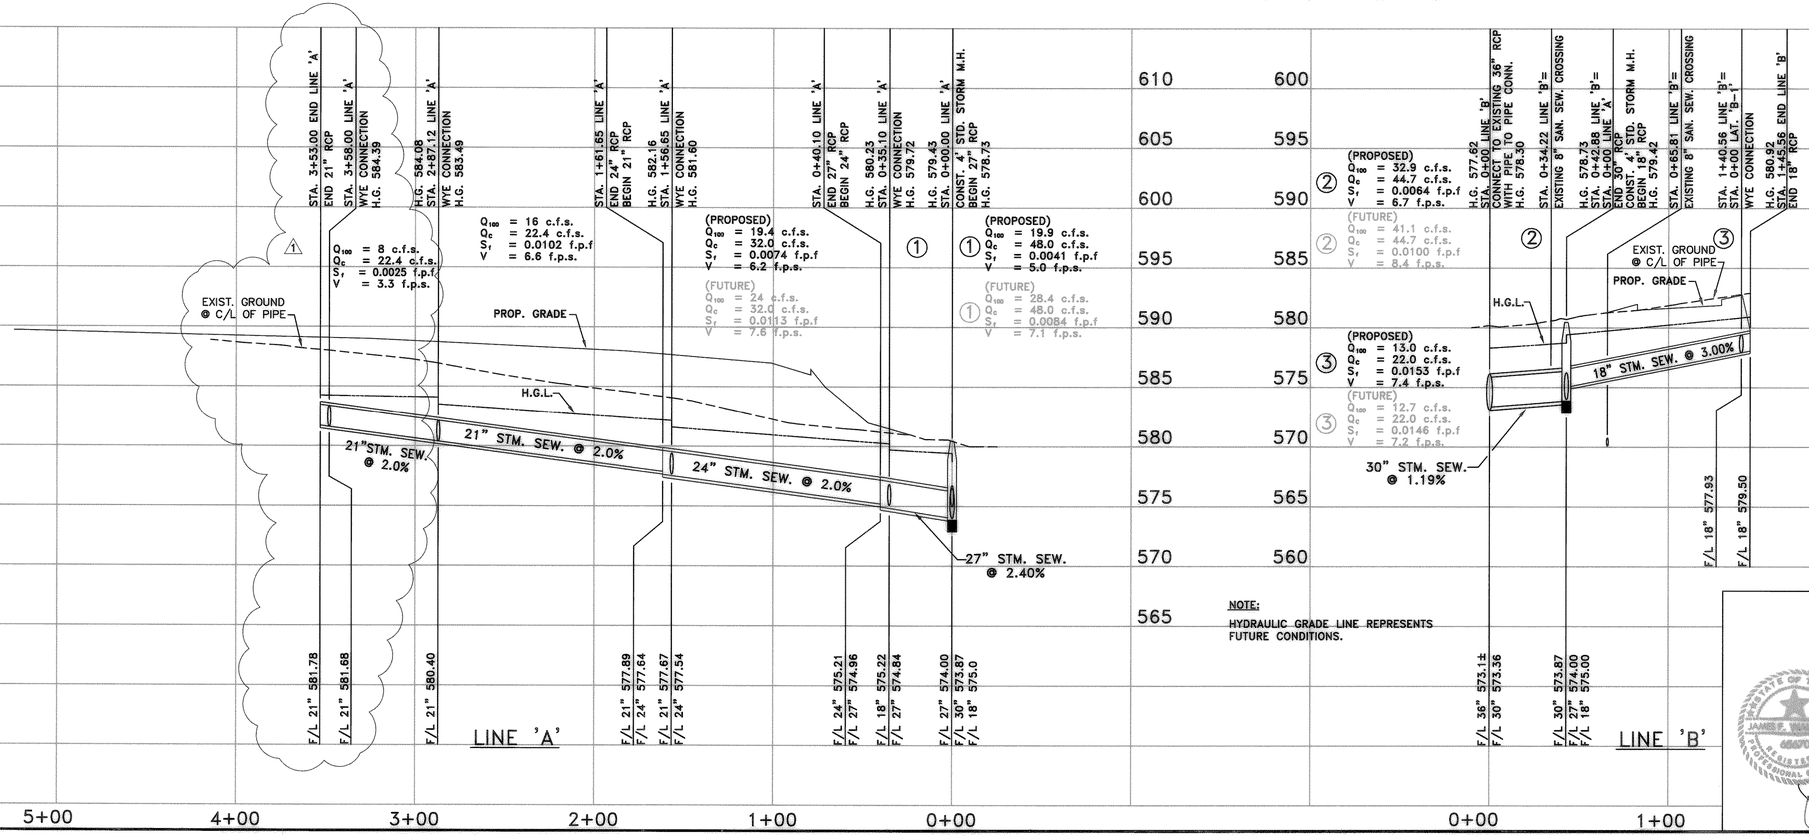

NOTE:
HYDRAULIC GRADE LINE REPRESENTS FUTURE CONDITIONS.

DATE:	JULY, 2000	SCALE:	1"=40'(H)1"=6'(V)	JOB NO.:	00-226
DRAWN:	GBW	DESIGN: JFW	REVIEWED: BRG	DWG:	STMPP01.DWG

REDC PHASE I OFFICE/WAREHOUSE
DRAINAGE PLAN & PROFILE

ROCKWALL ECONOMIC DEVELOPMENT CORPORATION

Grantham, Burge & Waldbauer Engineers, Inc.
1919 S. SHILOH ROAD, SUITE 530, L.B. 27
GARLAND, TEXAS 75042
(972) 840-1916 (TEL)
(972) 840-2156 (FAX)