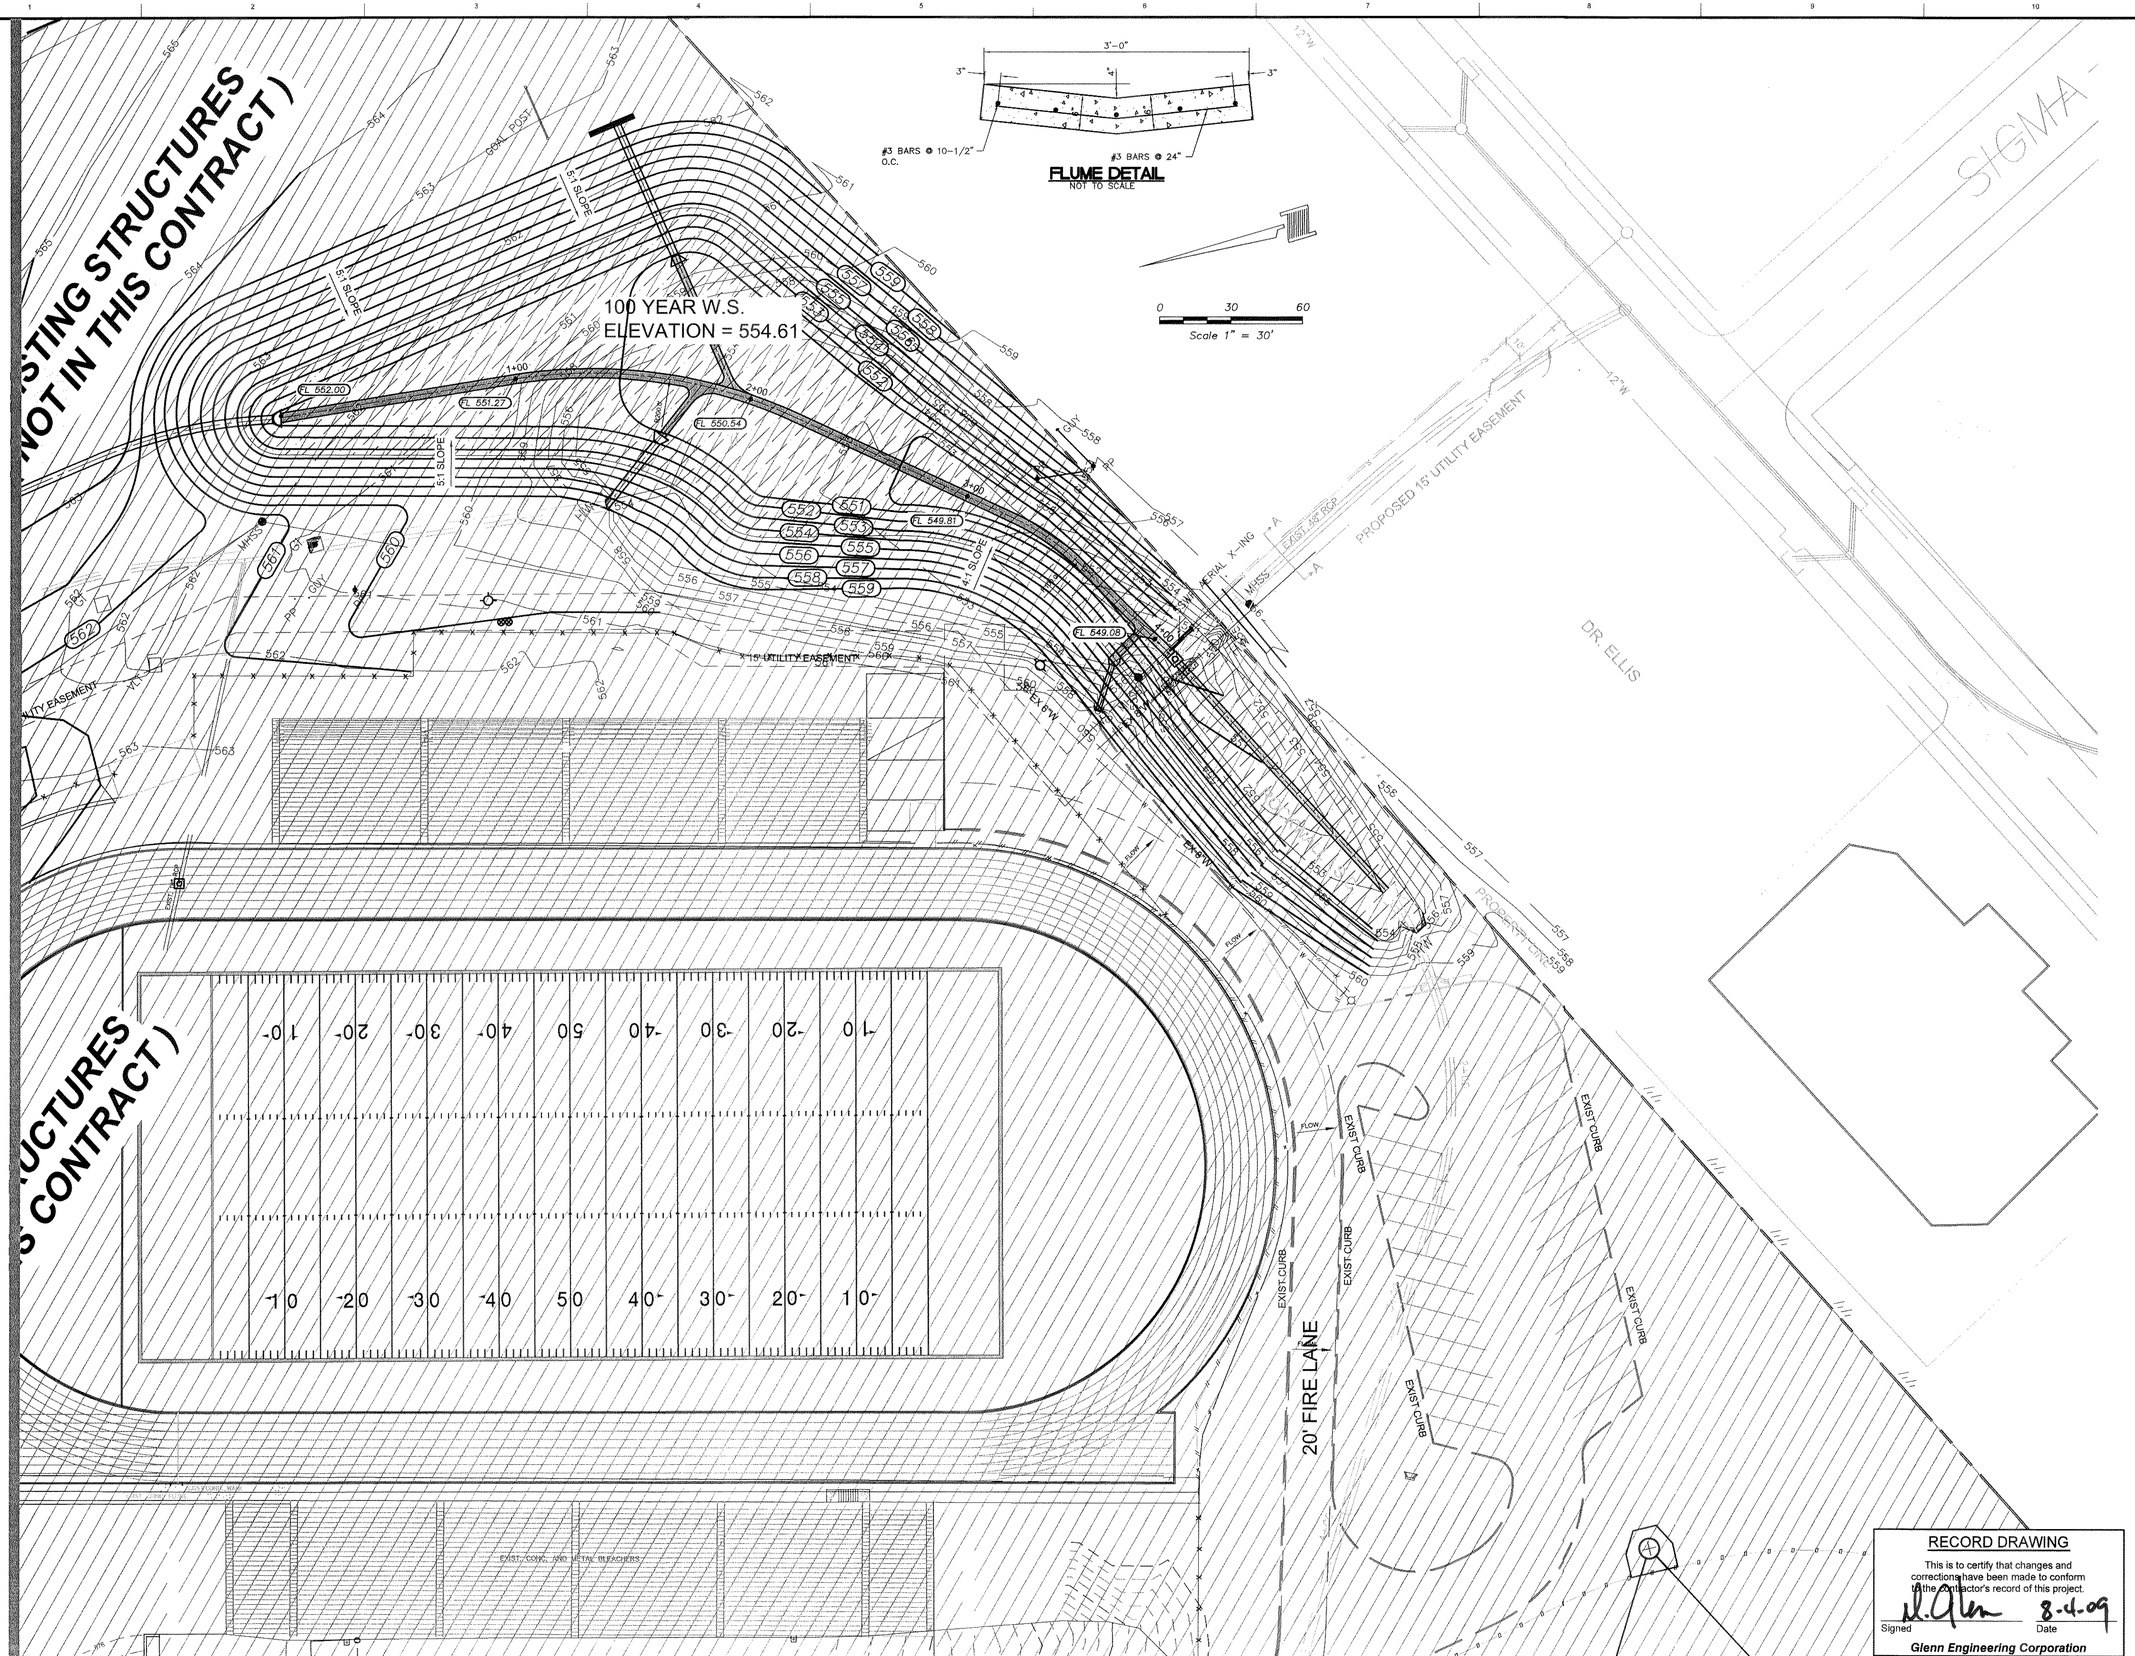

RECORD DRAWING

This is to certify that changes and corrections have been made to conform to the contractor's record of this project.

Signed: [signature] Date: 8-4-09

Glenn Engineering Corporation

SHWGROUP

ARCHITECTS | ENGINEERS | PLANNERS

CIVIL:
GLENN ENGINEERING, INC.

STRUCTURAL:
SHW GROUP LLP

MEP:
ESTES, McCLURE & ASSOCIATES

LANDSCAPING:
GRUBBS-RAMSEY, INC.

FOOD SERVICE:
JMK DESIGNS

AQUATICS:
AQUATIC EXCELLENCE

FINAL PLANS
FOR BIDDING AND CONSTRUCTION

STATE OF TEXAS
MIKE GLENN
35659
8-4-09

Rockwall ISD

HERMAN E. UTLEY MIDDLE SCHOOL

CHECKED:
File:
© 2008 SHW Group LLP

ISSUE: 08/22/2008

1	09/19/08	CITY REVISIONS #1
2	09/28/08	CITY REVISIONS #2
3	10/01/08	CITY REVISIONS #3
4	10/13/08	REVISIONS #4
5	11/18/08	GRADING REVISIONS
6	12/02/08	UTILITY REVISIONS
7	01/14/09	GRADING REVISIONS
8	02/26/09	GRADING REVISIONS
9	05/20/09	COURTYARD STORM
10	07/27/09	RECORD SET

Sheet Title:
VISITOR SIDE GRADING PLAN

CG 1.05

SHW Project: 4107.043.00

Plotted: Aug 3, 2009, 1:14 PM by user: rick - Saved: 7/31/2009 by user: rick
\\Robertplc-drive\ROCKISD\UTLEY\2008 ADDITIONS\BID SET\2008 UTLEY-SCH+NAT-REV3.dwg