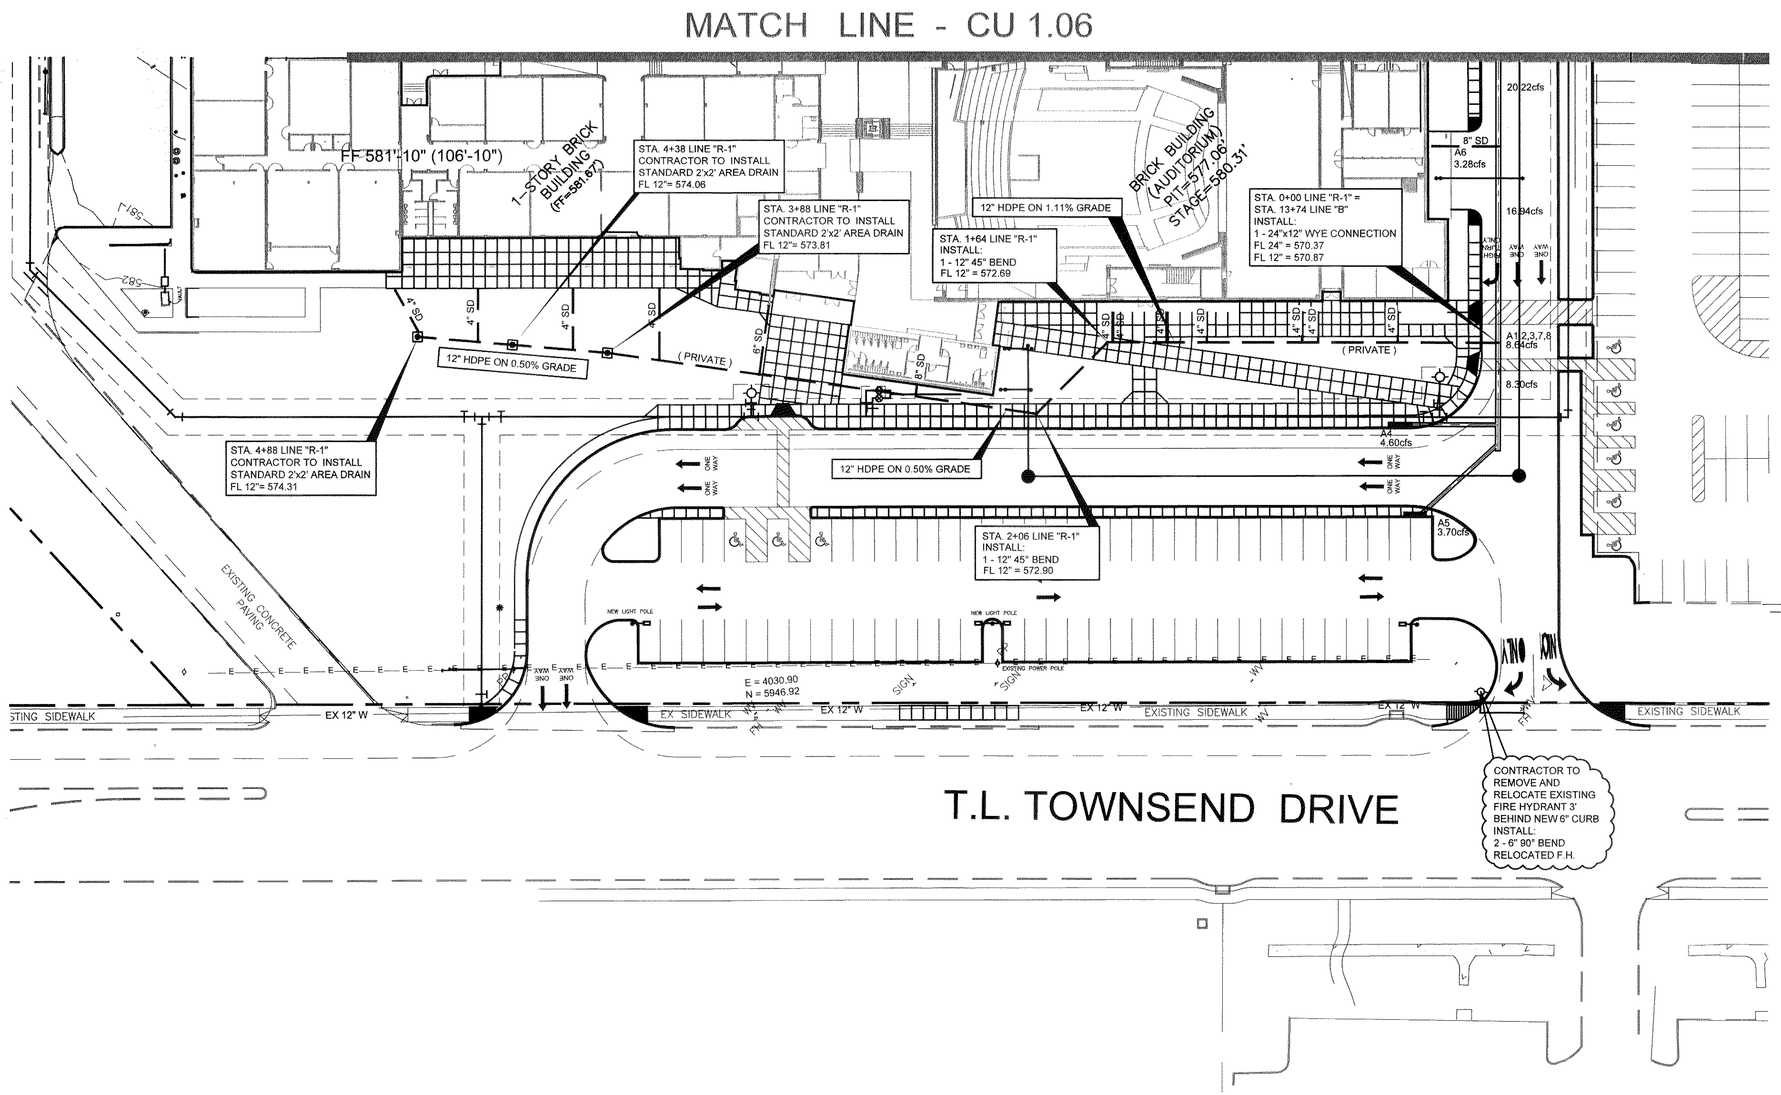

GENERAL STORM SEWER NOTES

1. All construction to be in accordance with these plans and City of Rockwall standards and specifications.
2. Prior to starting construction, the contractor shall make certain that all required permitsand approvals have been obtained. No construction or fabrication shall begin until the contractor has received and thoroughly reviewed all plans and other documents approved by all of the permitting authorities.
3. All work shall be performed in accordance with these plans and specifications and the requirements and standards of the local governing authority.
4. In the event an item is not covered in the City of Rockwall specifications, the engineer's decision shall apply.
5. Barricading, traffic control, and project signs shall conform to "state department of highways and public transportation barricading and construction standards".
6. The general contractor and all sub-contractors shall verify the suitability of all existing and proposed site conditions including grades and dimensions before commencement of any construction. In the event of any conflict and prior to commencement of any construction, immediately notify engineer. Minor adjustments of finish grade to accomplish spot drainage are acceptable, if necessary, upon prior approval of engineer. Paving installed shall 'flush out' at any juncture with existing paving.
7. The locations of underground utilities shown on this plan are based on field surveys and local utility company records. It shall be the contractor's full responsibility to contact the various utility companies to locate their utilities prior to starting construction.
8. Contractor shall verify all existing inverts, rim elevations and sizes prior to construction.
9. All PVC pipe shall be SCH 40 or approved equal.
10. All RCP shall be class III.
11. All storm sewer in public areas will be constructed to City of Rockwall standards.

0 30 60
Scale 1" = 30'

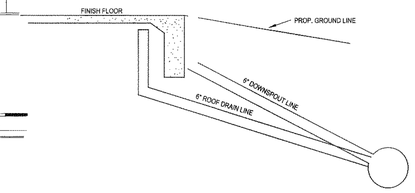

DOWNSPOUT DETAIL

NTS

NOTE:
1. AT ALL LOCATIONS OF DOWNSPOUTS AND ROOF DRAINS A 6" PVC PIPE IS TO BE INSTALLED FROM THE 12" PVC LINE TO THE FOUNDATION AND EXTEND UP ABOVE THE FINISH FLOOR ELEV. SEE ARCH. PLAN FOR THE CONNECTION DETAIL AND THE ROOF PLAN FOR ACTUAL DOWNSPOUT AND ROOF DRAIN LOCATIONS.

RECORD DRAWING

This is to certify that changes and corrections have been made to conform to the contractor's record of this project.

Signed 8.4.09 Date

Glenn Engineering Corporation

SHWGROUP
ARCHITECTS | ENGINEERS | PLANNERS

CIVIL:
GLENN ENGINEERING, INC.

STRUCTURAL:
SHW GROUP LLP

MEP:
ESTES, McCLURE & ASSOCIATES

LANDSCAPING:
GRUBBS-RAMSEY, INC.

FOOD SERVICE:
JMK DESIGNS

AQUATICS:
AQUATIC EXCELLENCE

FINAL PLANS
FOR BIDDING AND CONSTRUCTION

STATE OF TEXAS
MIKE GLENN
35097
REGISTERED PROFESSIONAL ENGINEER
8.4.09

Rockwall ISD

HERMAN E. UTLEY MIDDLE SCHOOL

CHECKED:
File:
© 2008 SHW Group LLP

ISSUE: 08/22/2008

1	09/19/08	CITY REVISIONS #1
2	09/28/08	CITY REVISIONS #2
3	10/01/08	CITY REVISIONS #3
4	10/13/08	REVISIONS #4
5	11/18/08	GRADING REVISIONS
6	12/02/08	UTILITY REVISIONS
7	01/14/09	GRADING REVISIONS
8	02/26/09	GRADING REVISIONS
9	05/20/09	COURTYARD STORM
10	07/27/09	RECORD SET

Sheet Title:
UTLEY WEST ROOF DRAIN PLAN

CU 1.07

SHW Project: 4107.043.00

Plotted: Aug 3, 2009, 1:23 PM by user: rick - Saved: 7/31/2009 by user: rick
\\Robertspic-drive\ROCKISDUTLEY\2008 ADDITIONS\BID SET\2008 UTLEY-SCH+NAT-REV3.dwg