

Notes:
No part of the wall, Tie backs, Footing, Etc. shall be located in a Easement, Right of Way or Off-site. Engineer or Representative to inspect and clarify wall constructed per plans.


RECORD DRAWING

This is to certify that changes and corrections have been made to conform to the contractor's record of this project.

Signed: *Glenn* Date: 8-11-09

Glenn Engineering Corporation



RETAINING WALL DETAILS
SCALE: AS SHOWN

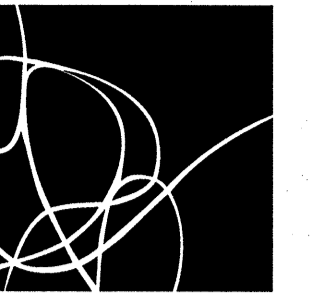

SHW GROUP
ARCHITECTS | ENGINEERS | PLANNERS

- CIVIL:
GLENN ENGINEERING, INC.
- STRUCTURAL:
SHW GROUP LLP
- MEP:
ESTES, McCLURE & ASSOCIATES
- LANDSCAPING:
RAMSEY LANDSCAPE ARCHITECTS
- FOOD SERVICE:
JMK DESIGNS

FINAL PLANS FOR PERMITTING AND CONSTRUCTION

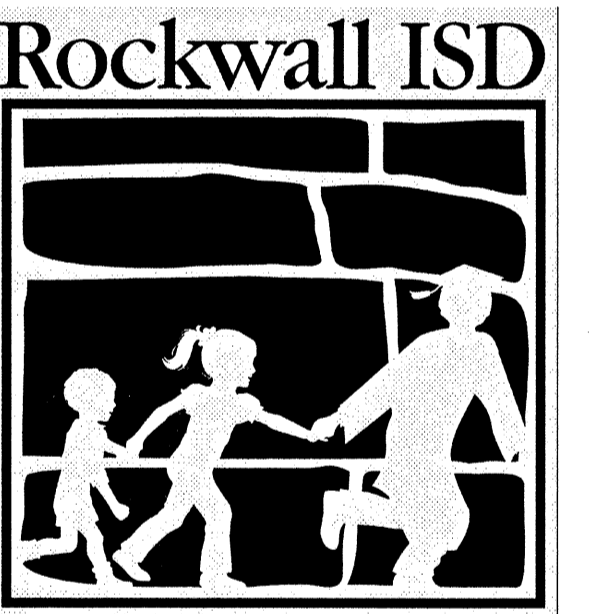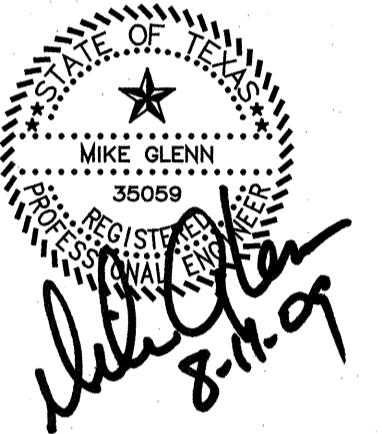

ROCKWALL HIGH SCHOOL
ROCKWALL, TEXAS

CHECKED:
File:
© 2008 SHW Group LLP
ISSUE: 5/27/2008

- Revisions:
- 1 ADDENDA #1 - MARCH 17, 2008
 - 2 ADDENDA #2 - MARCH 25, 2008
 - 3 ADDENDA #3 - APRIL 1, 2008
 - 4 CITY REVIEW COMMENTS - APRIL 22, 2008
 - 5 CITY REVIEW COMMENTS - SEPT. 09, 2008
 - 6 RECORD SET - MARCH 04, 2009
 - 7 REVISED RECORD SET - JUNE 04, 2009

Sheet Title:
RETAINING WALL DETAILS

CR 1.01

Plotted: Aug 11, 2009, 1:43 PM by user: rick - Saved: 8/11/2009 by user: rick
\\robertp-c-drive\rockwall\high-school\017 ADDITIONS\ROCKWALL-HS-APP-REV16.dwg