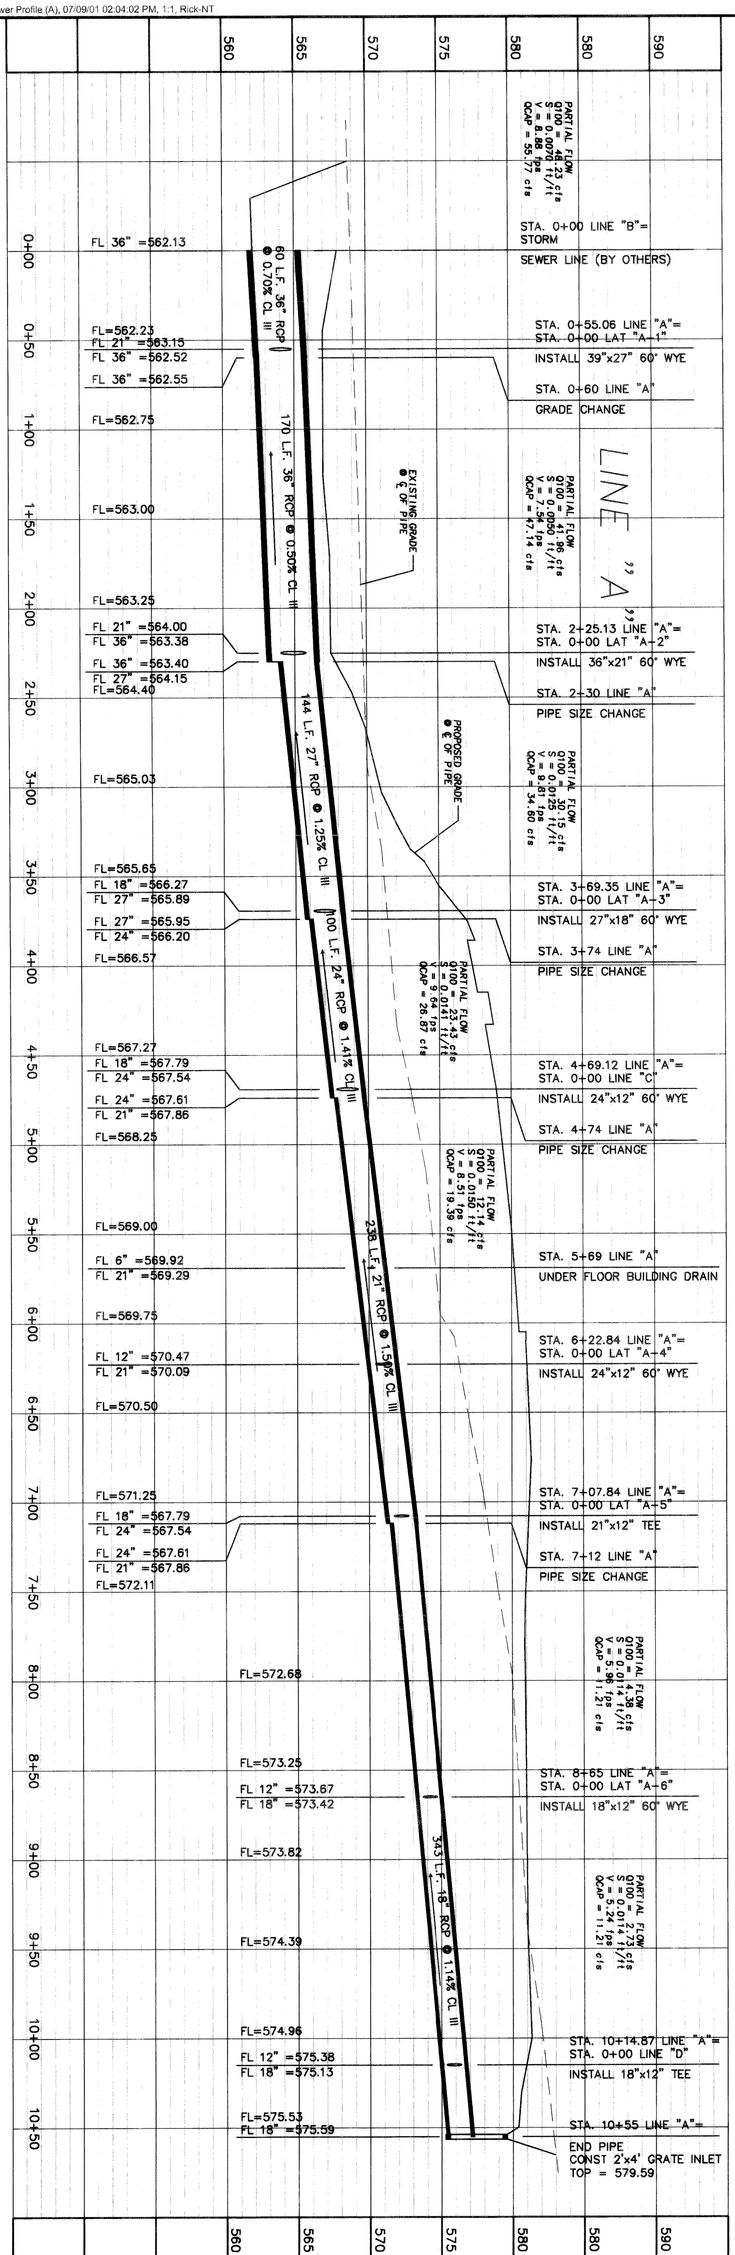

STORM SEWER PROFILE

SCALE: H-1" = 40', V-1" = 5'

These Drawings have been modified to conform to the Construction Records.
Glenn Engineering Corporation
By: _____ Date: 9-25-04

GLENN ENGINEERING
PHONE 972-717-5151 FAX 972-719-4229
100 DECKER COURT - SUITE 250 IRVING, TEXAS 75062

SHEET NUMBER C 2.12 OF ___
SET NUMBER

SPW Group Inc. Architects • Engineers

STATE OF TEXAS MIKE GLENN 75059 REGISTERED PROFESSIONAL ENGINEER 7-9-01

FINAL PLANS FOR BIDDING AND CONSTRUCTION

ROCKWALL ELEMENTARY #8

ROCKWALL INDEPENDENT SCHOOL DISTRICT

ROCKWALL, TEXAS

DATE MAY 2, 2001
DRAWN BY R.HOWMAN
CHECKED TJC
COMM NO.
REVISED