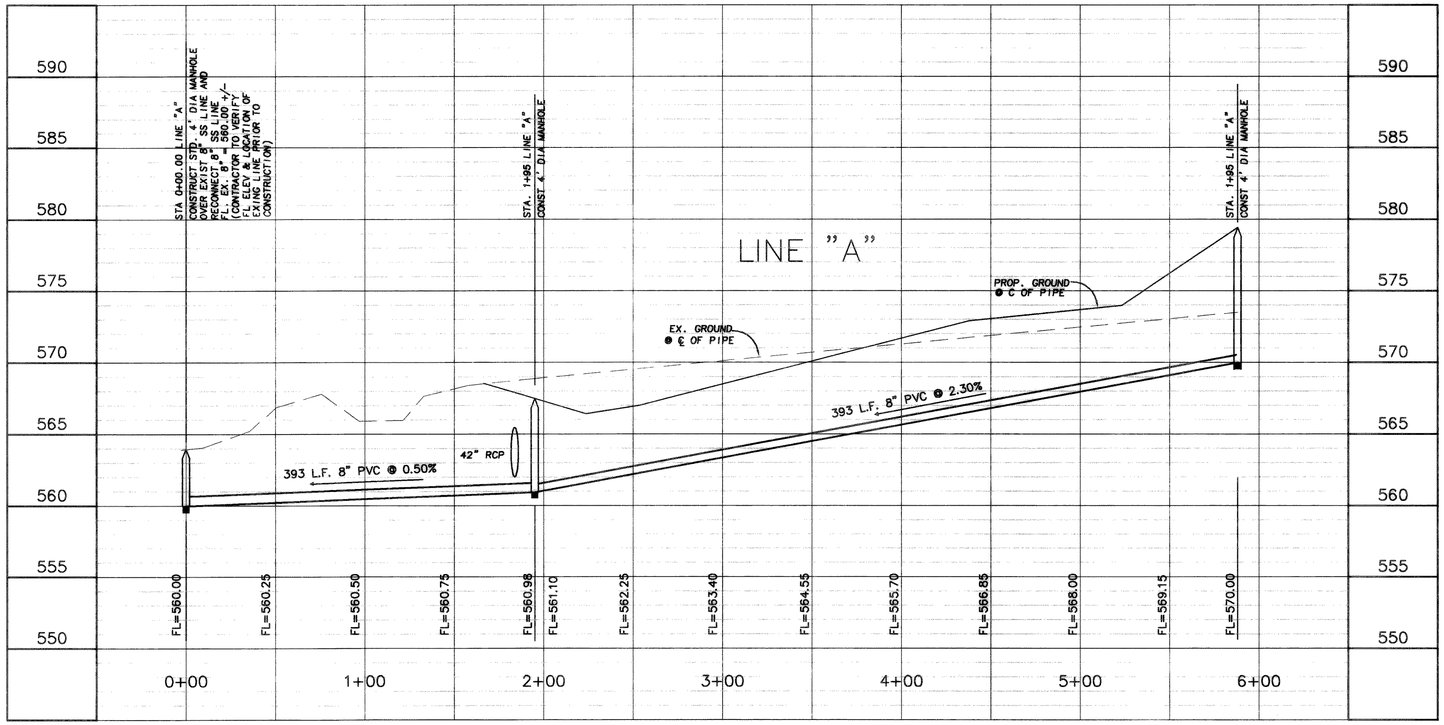

BENCH MARKS:
☐ CUT: ON NORTHEAST CURB RETURN HIGHPOINT BOULVARD AND SUMMIT DRIVE. ELEVATION = 679.03
☐ CUT: ON SOUTH TOP OF CURB OF WILMETH RD. AT STUB OUT 181' WEST OF PENNACLE DRIVE. ELEVATION = 681.72

SANITARY SEWER PROFILE

SCALE: H-1" = 40', V-1" = 5'

These Drawings have been modified to conform to the Construction Records.
Glenn Engineering Corporation
By L.J. Glenn Date: 2-23-04

GLENN ENGINEERING
PHONE 972-717-5151 FAX 972-719-4229
100 DECKER COURT - SUITE 250 IRVING, TEXAS 75062

DATE MAY 2, 2001
DRAWN BY R.HOWMAN
CHECKED TJC
COMM NO
REVISED

ROCKWALL ELEMENTARY #8
ROCKWALL INDEPENDENT SCHOOL DISTRICT
ROCKWALL, TEXAS

FINAL PLANS FOR BIDDING AND CONSTRUCTION

STATE OF TEXAS — WAYNE GLENN — 35059 — REGISTERED PROFESSIONAL ENGINEER

SHW Group Inc.
Architects + Engineers

SHEET NUMBER C
OF ___ 2.17
SET NUMBER

H:\ROCKSD\Architect Forms\NORMID-SETBRICK\OAKLAND FARMS BEV2.dwg, Sanitary Profile, 07/29/01 09:38:21 PM, 1:1, Bits-NT