


- LEGEND**
- EXISTING ASPHALT PAVEMENT
 - PROPOSED CONCRETE PAVEMENT
 - PROPOSED ASPHALT PAVEMENT
 - PROPOSED 2" ASPHALT OVER-LAY
 - PROPOSED 4" SIDEWALK
 - TACK COAT AND SEAL COAT
 - 2-4" PVC SLEEVES



DATE MAY 15, 1998
 DRAWN BY R. HOWMAN
 CHECKED R.A.H.
 COUN. NO. 0494453
 REVISIONS NONE
 JUN. 15, 1998

ROCKWALL I.S.D. 1998 PAVING IMPROVEMENTS
 WILKERSON SANDERS STADIUM PAVING IMPROVEMENTS
 ROCKWALL, TEXAS
 ROCKWALL I.S.D.

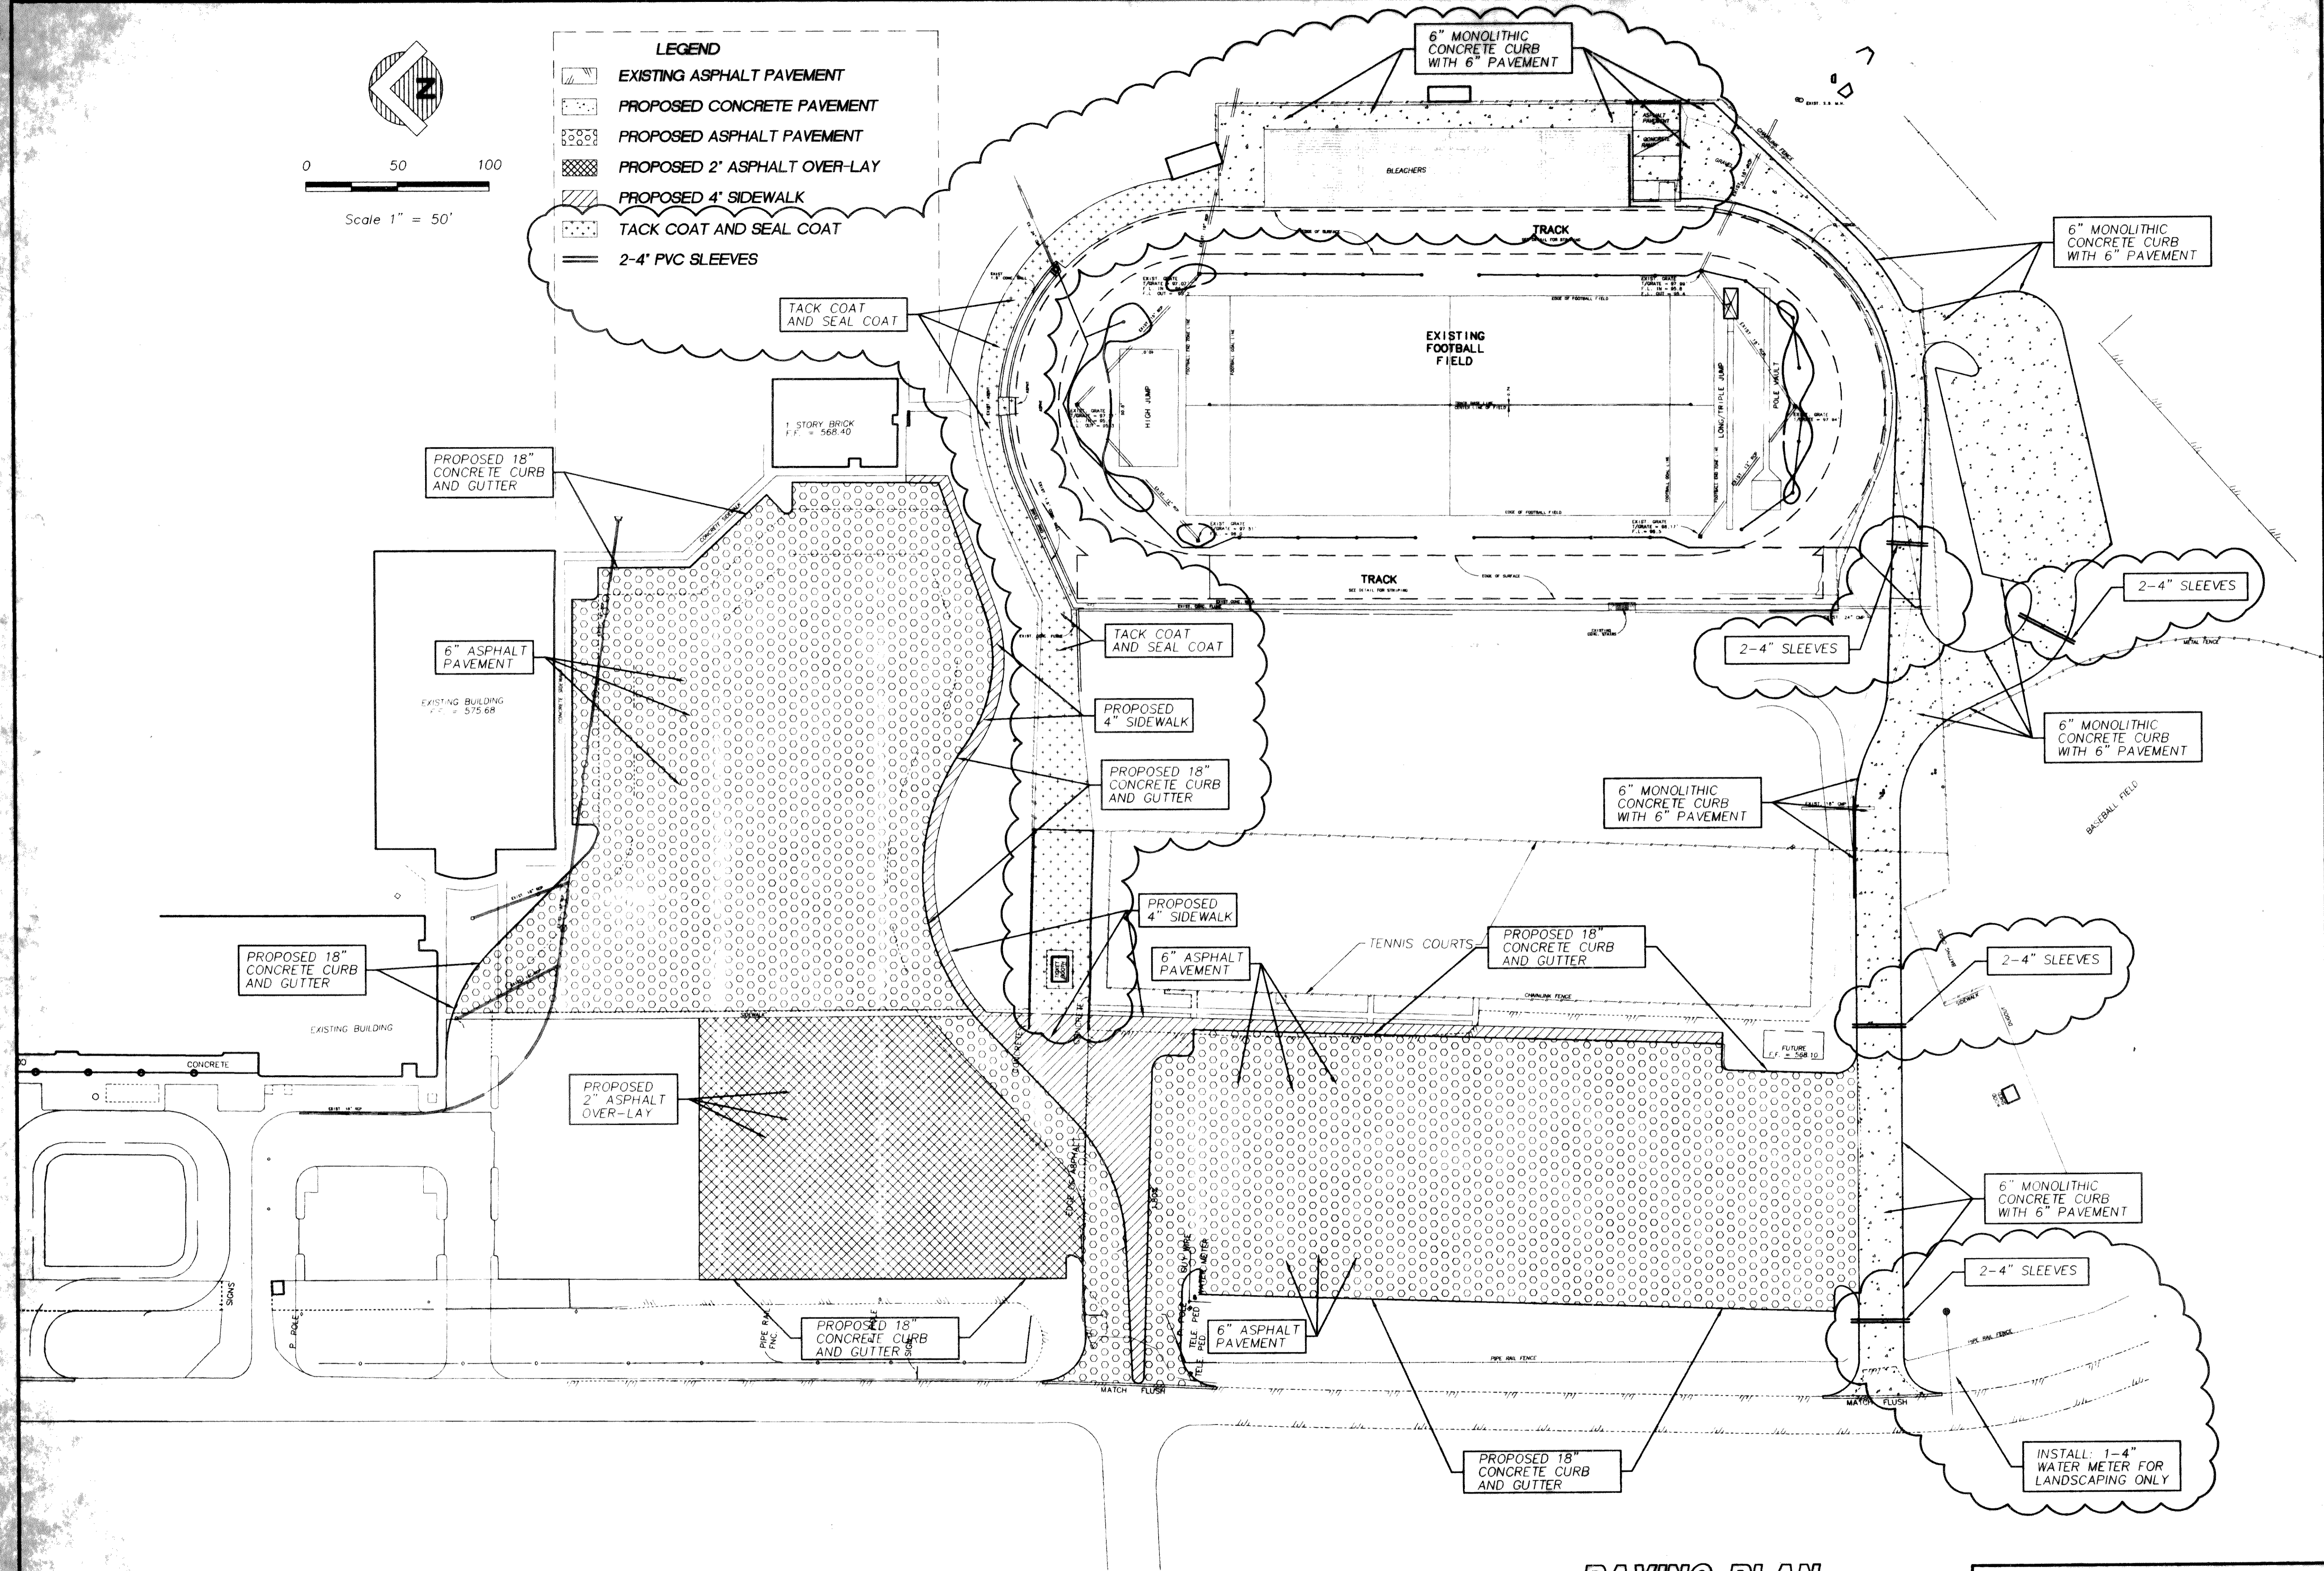

Glenn Engineering
Glenn Group Inc.
 Architects • Engineers

PAVING PLAN
 SCALE: 1"=50'

GLENN ENGINEERING
 PHONE 94-77-981 FAX 94-77-929
 100 DECKER COURT - SUITE 250 FARMING, TEXAS 76046

SHEET NUMBER	C
OF	4
SET NUMBER	2.3R

C:\WORK\SOFT\LE\plans.dwg Tue Jun 16 13:51:33 1998