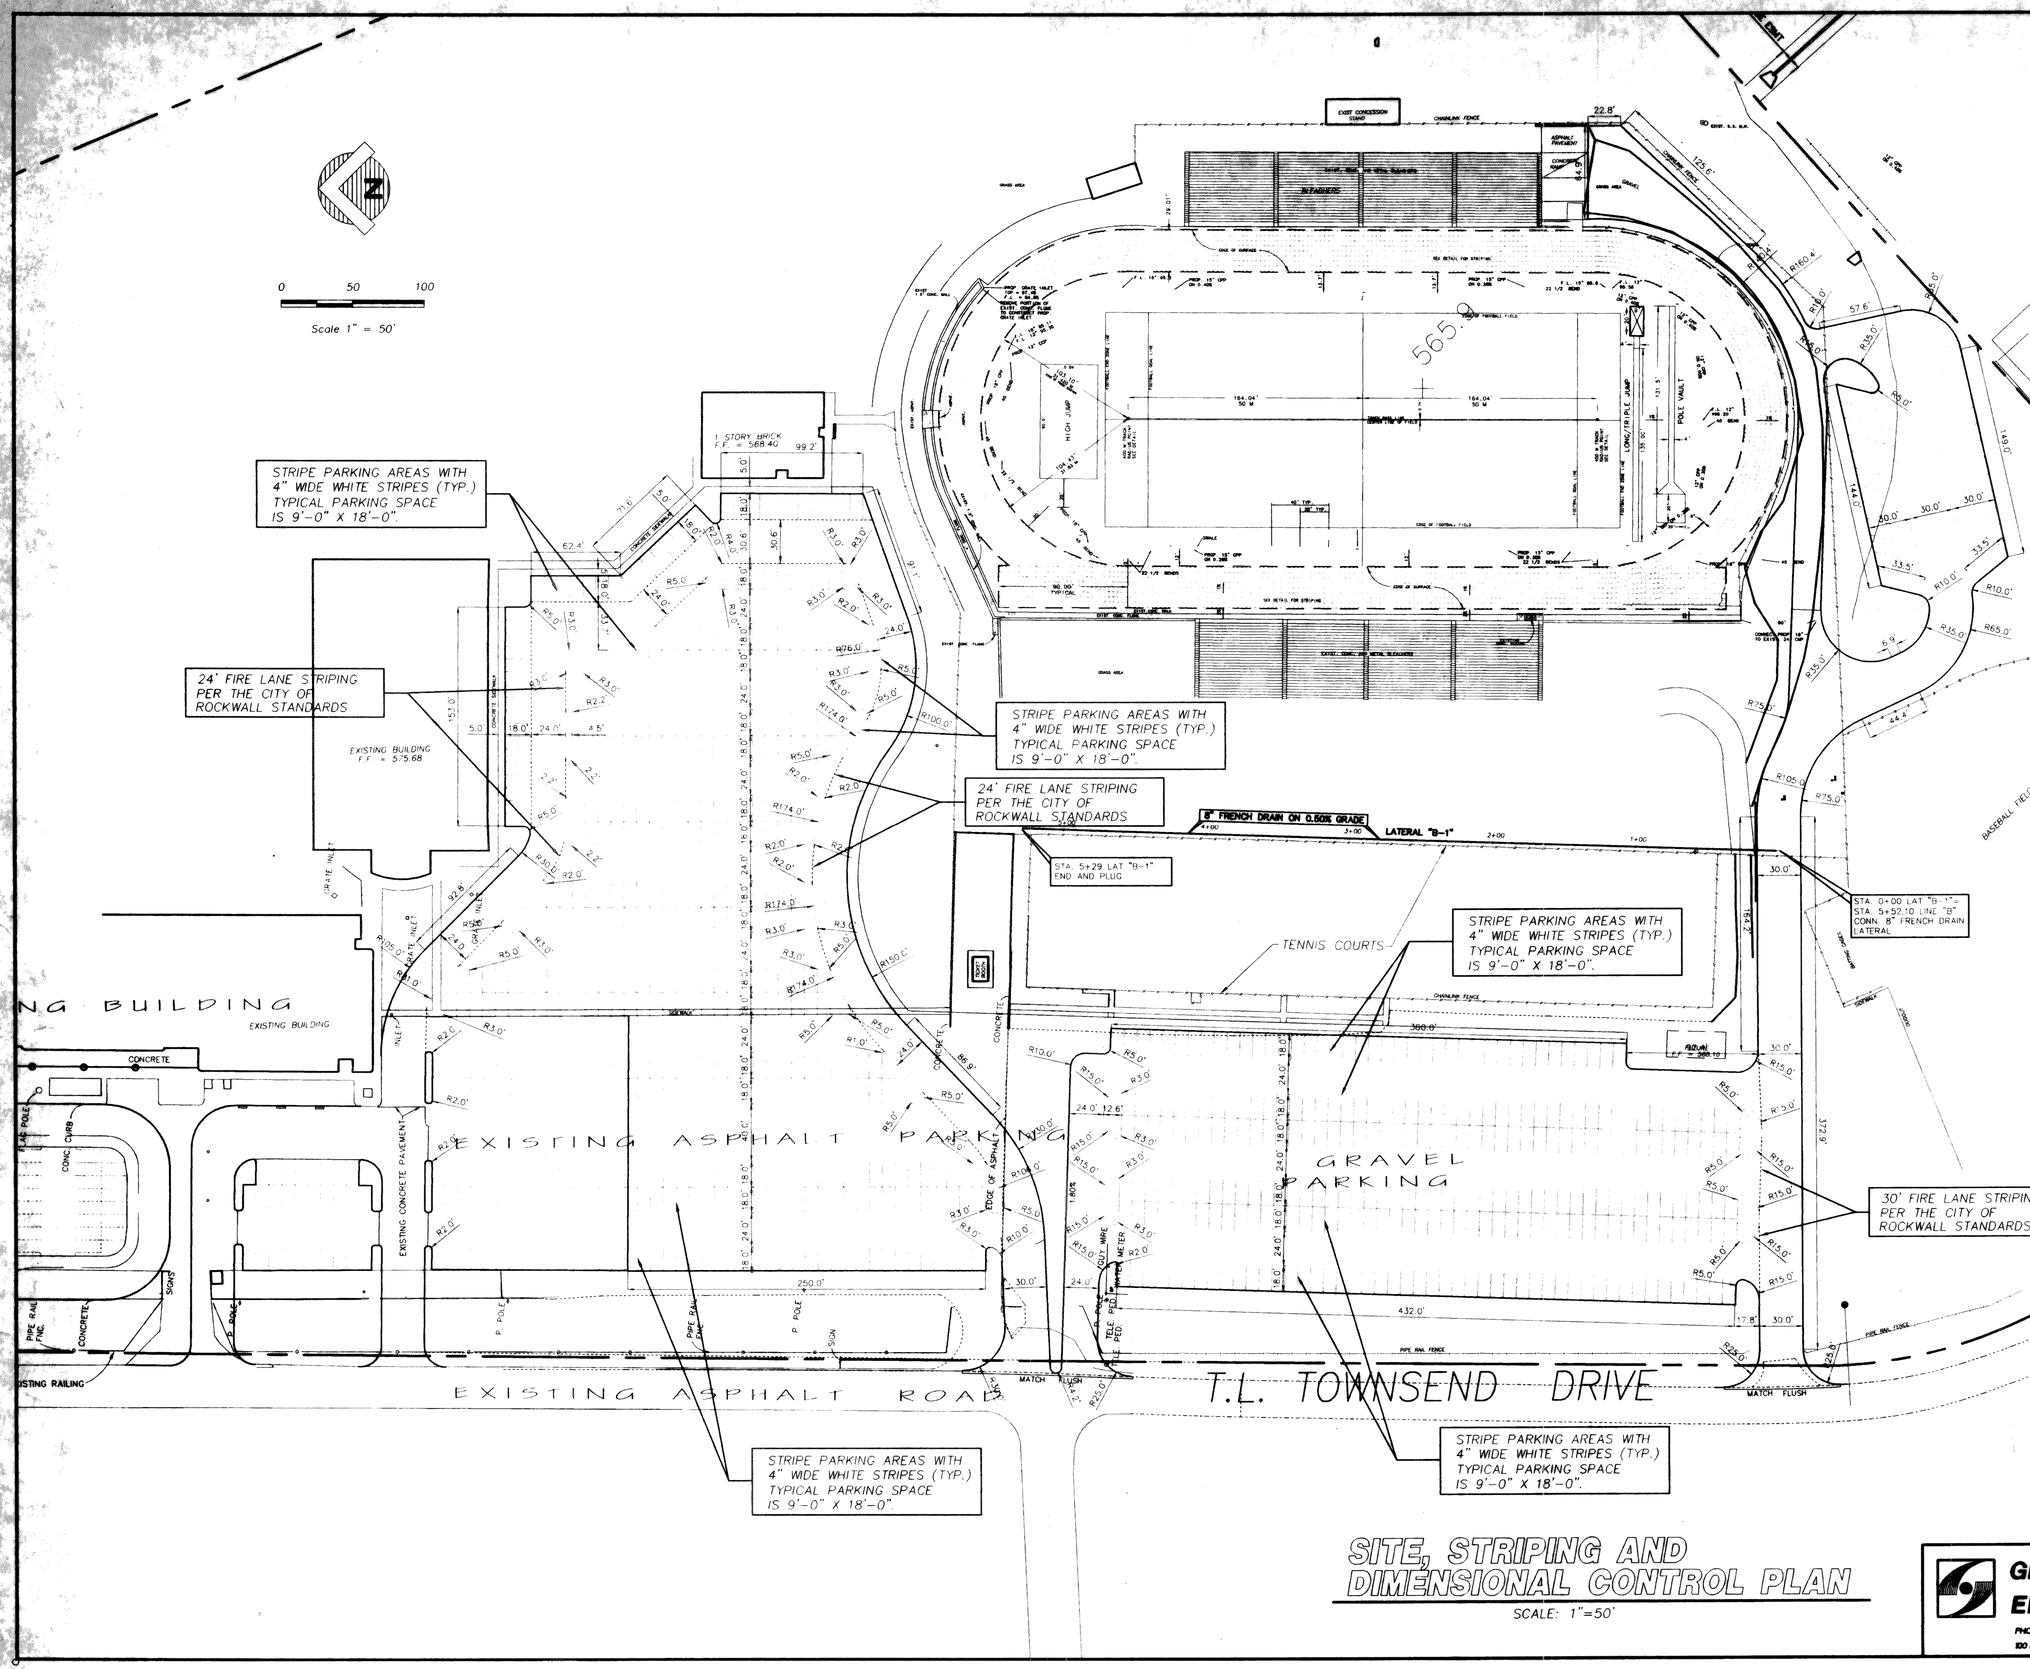

SITE, STRIPING AND DIMENSIONAL CONTROL PLAN

SCALE: 1"=50'

DATE MAY 15, 1998
DRAWN BY R. HOWMAN
CHECKED R.A.H.
COMM NO 0494453
REVISED JULY 06, 1998

ROCKWALL L.S.D. 1998 PAVING IMPROVEMENTS
WILKERSON SANDERS STADIUM PAVING IMPROVEMENTS
ROCKWALL L.S.D.
ROCKWALL, TEXAS

SHW Group Inc.
Architects + Engineers

SHEET NUMBER C 2.2R
OF 16
SET NUMBER

GLENN ENGINEERING
PHONE 214-717-0351 Fax 214-717-4239
100 DECKER COURT - SUITE 250 IRVING, TEXAS 75062

I:\GT-BOB-NTO-DRIVE\ROCKISD\UTILITY\PLANS-1.DWG Wed Jul 08 08:57:44 1998