


DATE MAY 15, 1998
 DRAWN BY R.HOWMAN
 CHECKED R.A.H.
 CONN NO 0494453
 REVISIONS JUNE 15, 1998

ROCKWALL I.S.D. 1998 PAVING IMPROVEMENTS
 WILKERSON SANDERS STADIUM PAVING IMPROVEMENTS
 ROCKWALL I.S.D.

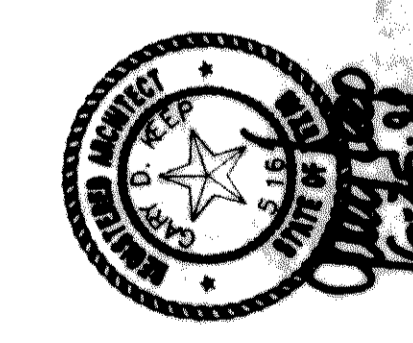

Glenn Group Inc.
 Architects & Engineers


SHEET NUMBER C
 OF 4 2.7R
 SET NUMBER

GENERAL STORM SEWER NOTES

- ALL CONSTRUCTION TO BE IN ACCORDANCE WITH THESE PLANS AND CITY OF ROCKWALL STANDARDS AND SPECIFICATIONS.
- PRIOR TO STARTING CONSTRUCTION, THE CONTRACTOR SHALL MAKE CERTAIN THAT ALL REQUIRED PERMITS AND APPROVALS HAVE BEEN OBTAINED. NO CONSTRUCTION OR FABRICATION SHALL BEGIN UNTIL THE CONTRACTOR HAS RECEIVED AND THOROUGHLY REVIEWED ALL PLANS AND OTHER DOCUMENTS APPROVED BY ALL OF THE PERMITTING AUTHORITIES.
- ALL WORK SHALL BE PERFORMED IN ACCORDANCE WITH THESE PLANS AND SPECIFICATIONS AND THE REQUIREMENTS AND STANDARDS OF THE LOCAL GOVERNING AUTHORITY.
- IN THE EVENT AN ITEM IS NOT COVERED IN THE CITY OF ROCKWALL SPECIFICATIONS, THE ENGINEER'S DECISION SHALL APPLY.
- BARRICADING, TRAFFIC CONTROL, AND PROJECT SIGNS SHALL CONFORM TO "STATE DEPARTMENT OF HIGHWAYS AND PUBLIC TRANSPORTATION BARRICADING AND CONSTRUCTION STANDARDS".
- THE GENERAL CONTRACTOR AND ALL SUBCONTRACTORS SHALL VERIFY THE SUITABILITY OF ALL EXISTING AND PROPOSED SITE CONDITIONS INCLUDING GRADES AND DIMENSIONS BEFORE COMMENCEMENT OF ANY CONSTRUCTION. IN THE EVENT OF ANY CONFLICT AND PRIOR TO COMMENCEMENT OF ANY CONSTRUCTION, IMMEDIATELY NOTIFY ENGINEER. MINOR ADJUSTMENTS OF FINISH GRADE TO ACCOMPLISH SPOT DRAINAGE ARE ACCEPTABLE IF NECESSARY, UPON PRIOR APPROVAL OF ENGINEER. PAVING INSTALLED SHALL "FLUSH OUT" AT ANY JUNCTURE WITH EXISTING PAVING.
- THE LOCATIONS OF UNDERGROUND UTILITIES SHOWN ON THIS PLAN ARE BASED ON FIELD SURVEYS AND LOCAL UTILITY COMPANY RECORDS. IT SHALL BE THE CONTRACTOR'S FULL RESPONSIBILITY TO CONTACT THE VARIOUS UTILITY COMPANIES TO LOCATE THEIR UTILITIES PRIOR TO STARTING CONSTRUCTION.
- CONTRACTOR SHALL VERIFY ALL EXISTING INVERTS AND RIM ELEVATIONS PRIOR TO CONSTRUCTION.
- ALL PVC PIPE SHALL BE SCH 40, ADS, HANCOR OR APPROVED EQUAL.
- ALL RCP SHALL BE CLASS III, ADS OR HANCOR OR APPROVED EQUAL.
- CONTRACTOR SHALL CONNECT ALL EXISTING STORM SEWER TO NEW SEWER. REMOVE AND HAUL OFF EXISTING HEADWALLS.

CONTRACTOR SHALL VERIFY ALL EXISTING INVERTS AND ELEVATIONS PRIOR TO CONSTRUCTION.


ALL STORM SEWER CONSTRUCTION TO BE PER CITY OF ROCKWALL STANDARDS.

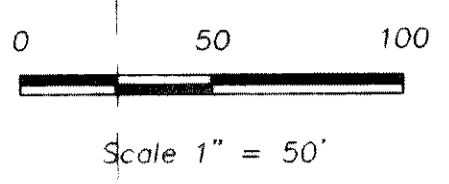

R = 195.00'
 D = 48'12"23"
 T = 87.24'
 L = 164.07'
 CH = 159.27'
 CB = S 68°43'39" E


R = 195.00'
 D = 41°47'37"
 T = 74.45'
 L = 142.24'
 CH = 139.11'
 CB = N 66°16'21" E

R = 100.00'
 D = 82°00'15"
 T = 86.93'
 L = 143.12'
 CH = 131.22'
 CB = S 85°55'22" E

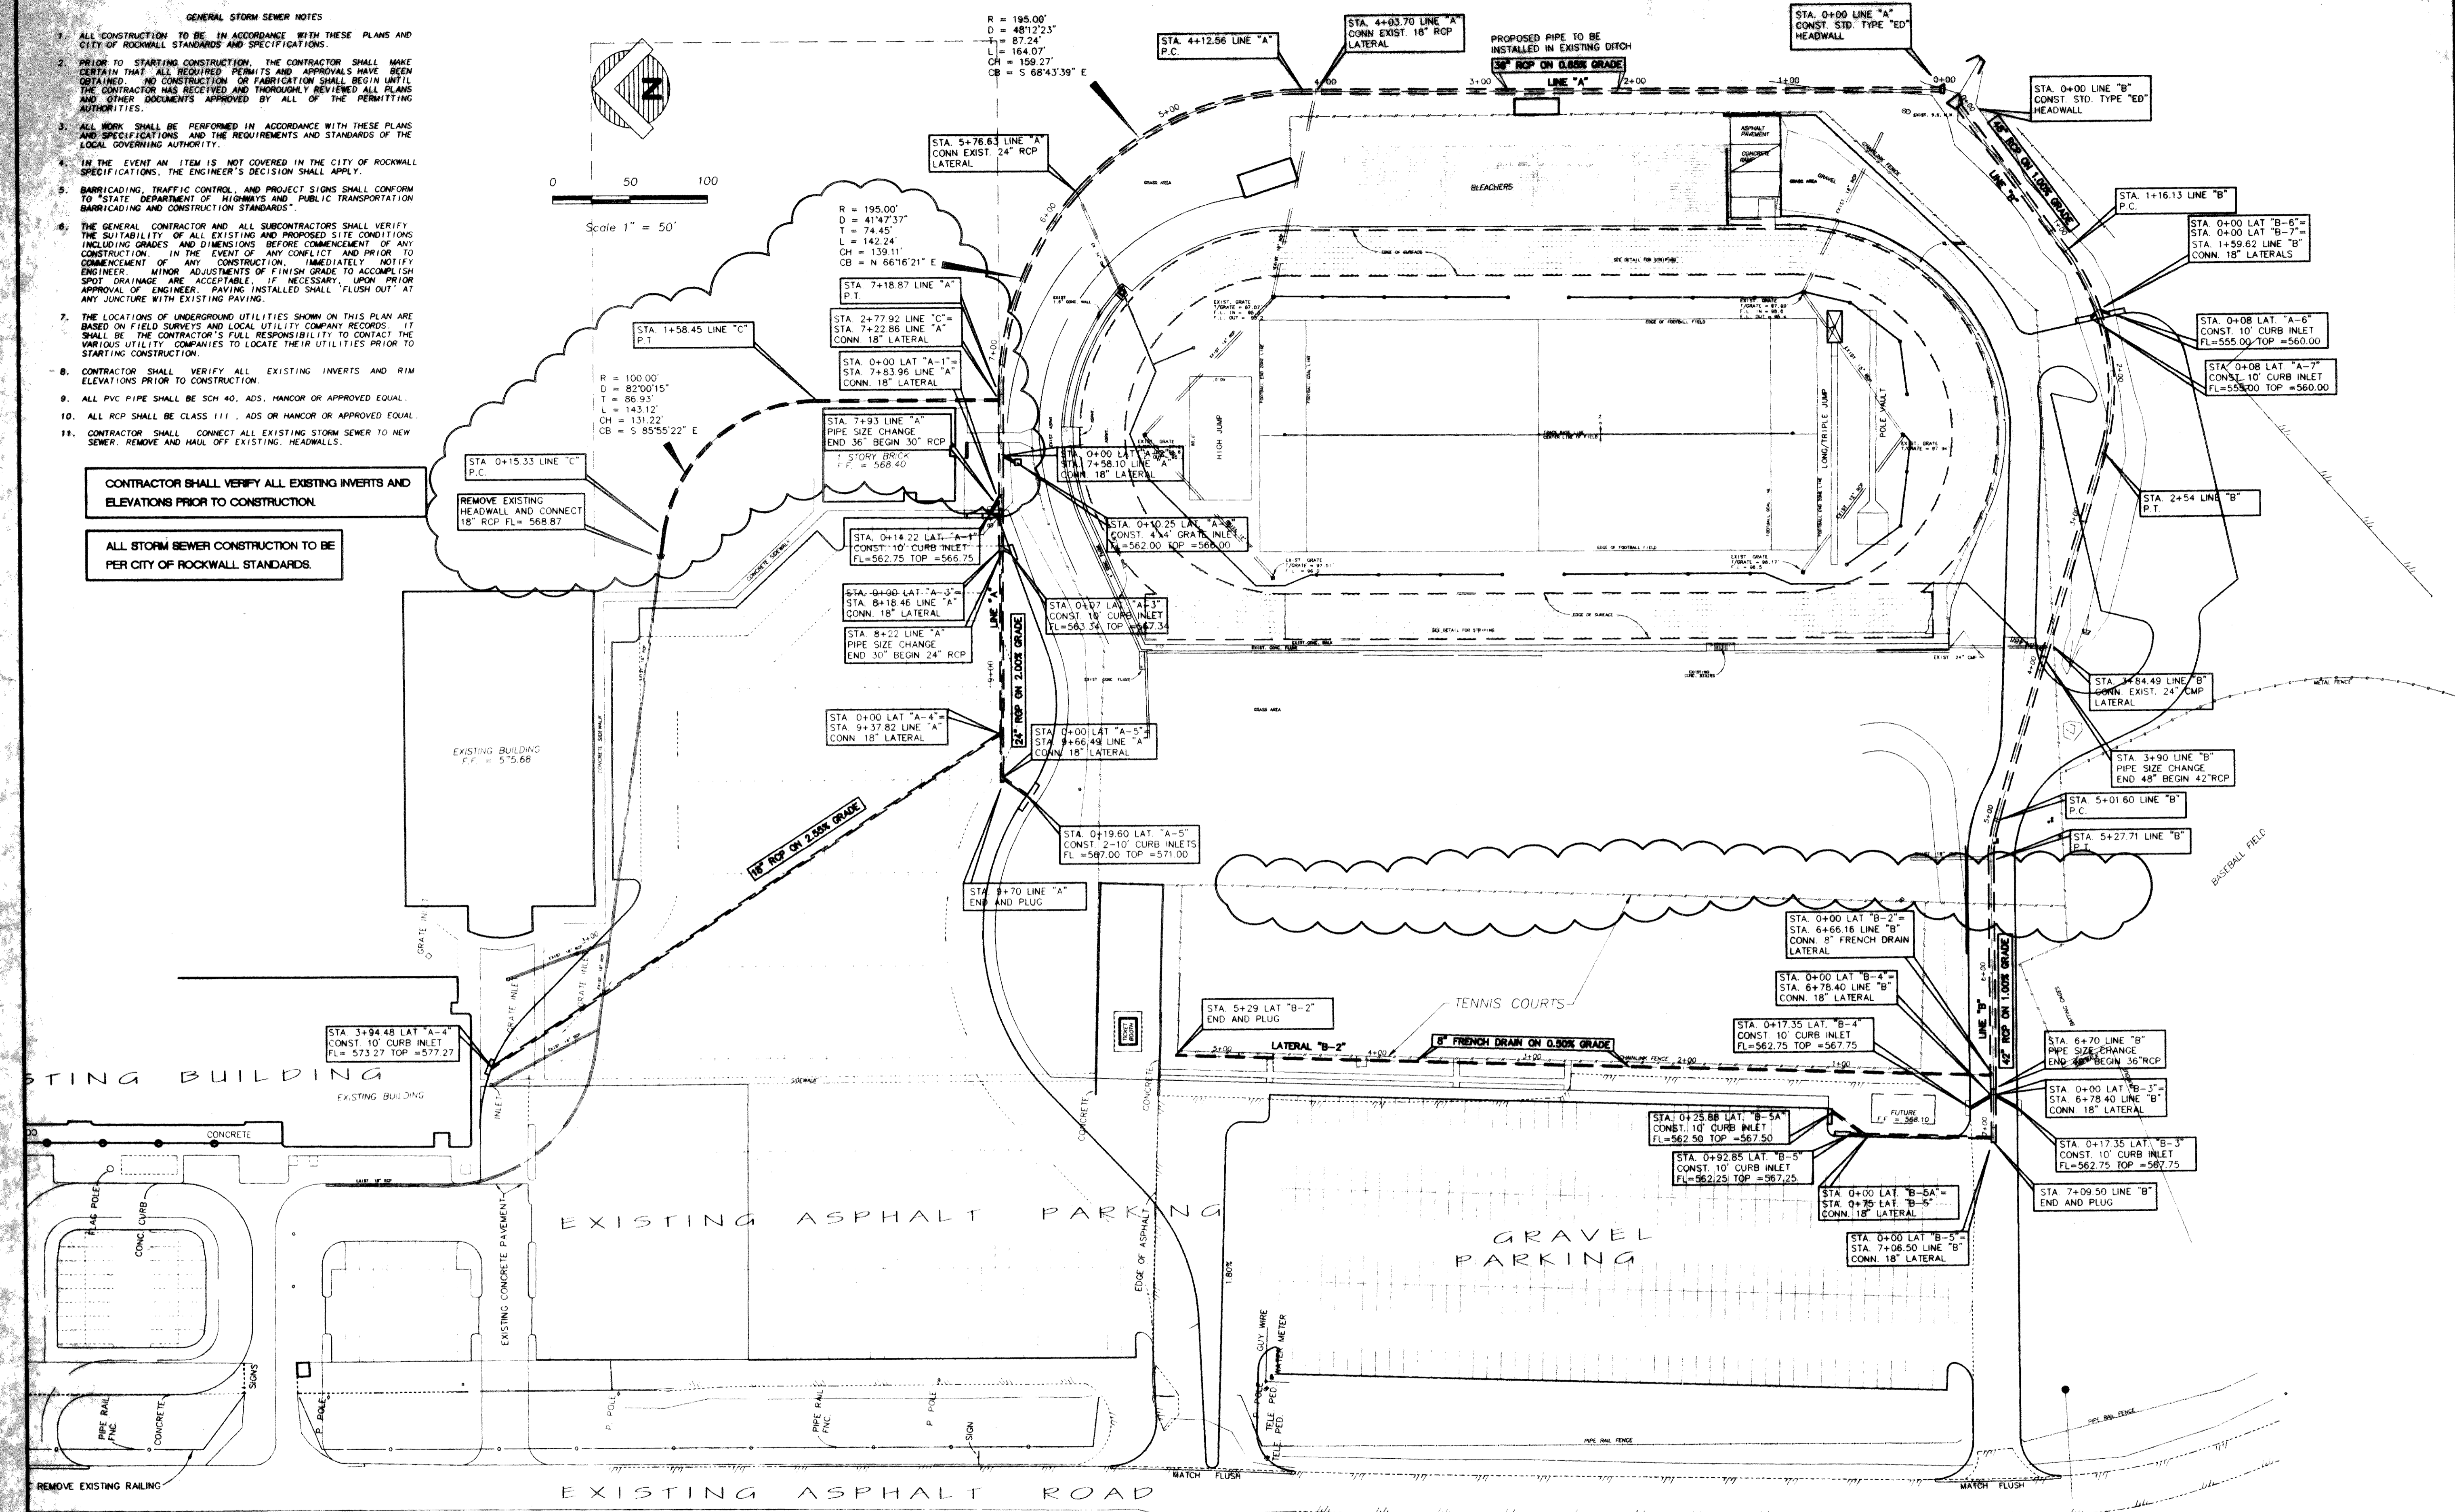

STORM SEWER PLAN

SCALE: 1" = 50'

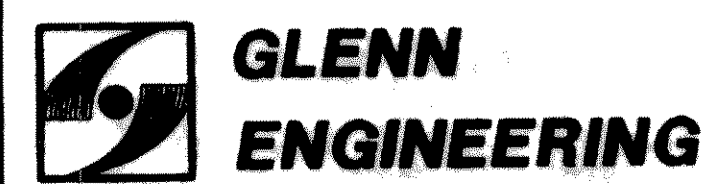

GLENN ENGINEERING

PHONE 972-770-0811
 100 DECKER COURT - SUITE 800
 ROCKWALL, TEXAS 75087

C:\WORK\150\VIEW\PLAN.dwg Wed Jun 17 16:24:20 1998