1999 SOCCER FIELD AND TRACK ADDITIONS TO
ROCKWALL HIGH SCHOOL
ROCKWALL, TEXAS

ABBREVIATIONS

A	
@	AT
A, AMP	AMPERES
AB	ANCHOR BOLT
ABV	ABOVE
A/C	AIR CONDITIONING
ACOU	ACOUSTICAL
ADJ.	ADJUSTABLE
ADMIN	ADMINISTRATIVE
AFC	ABOVE FINISHED CEILING
AFF	ABOVE FINISHED FLOOR
AGG	AGGREGATE
AHU	AIR HANDLING UNIT
AL.ST.	ALUMINUM STOREFRONT
ALUM	ALUMINUM
ALT	ALTERNATE
∠	ANGLE
ANOD	ANODIZED
AP	ACCESS PANEL
APC	ACOUSTICAL PANEL CEILING
APPROX	APPROXIMATELY
ARCH, ARCHL	ARCHITECTURAL
ASS'Y	ASSEMBLY
AUX	AUXILIARY
AWI	ARCHITECTURAL WOODWORK INSTITUTE
B	
BD	BOARD
BLDG	BUILDING
BLK	BLOCK
BLKG	BLOCKING
BLKHD	BULKHEAD
BM	BEAM
BOS	BOTTOM OF STEEL
B, BOTT	BOTTOM
BRZ	BRONZE
BTU	BRITISH THERMAL UNIT
BUR	BUILT-UP ROOF
C	
C	CENTIGRADE
CAB	CABINET
CBB	CEMENTITIOUS BACKER BOARD
CFMF	COLD-FORMED METAL FRAMING
CH	COAT HOOK
CHBD	CHALK BOARD
CI	CAST IRON
CJ	CONTROL JOINT
CL, ℄	CENTER LINE
CLG	CEILING
CLO	CLOSET
CLR	CLEAR
CMU	CONCRETE MASONRY UNIT
COL	COLUMN
CONC	CONCRETE
CONNX	CONNECTION
CONST	CONSTRUCTION
CONT	CONTINUOUS
CRDR	CORRIDOR
CRS	COURSE
CT	CERAMIC TILE
CTK	CURTAIN TRACK
CU	CUBIC
CUST	CUSTODIAN
CWFP	CEMENTITIOUS WOOD FIBER PLANK
D	
DBL	DOUBLE
DEF	DEFORMED
DF	DRINKING FOUNTAIN
DIA, ø	DIAMETER
DIAG	DIAGRAM
DIM	DIMENSION
DISP	DISPENSER
DIV	DIVISION
DN	DOWN
DP	DAMPPROOFING
DR	DOOR
DS	DOWNSPOUT
DTL	DETAIL
DWG	DRAWING
DWLS	DOWELS
DWR	DRAWER
E	
E, ELEC	ELECTRICAL
EA	EACH
EF	EXHAUST FLUE
EGSB	EXTERIOR GYPSUM SOFFIT BOARD
EIFS	EXTERIOR INSULATED FINISH SYSTEM
EJ	EXPANSION JOINT
EL. ELEV	ELEVATION
EQ	EQUAL
EQF	EPOXY QUARTZ FLOORING
EQUIP	EQUIPMENT
ETC	ET CETERA
EW	EACH WAY
EWC	ELECTRIC WATER COOLER
EXGR	EXISTING GRADE
EXH	EXHAUST
EXIST, EXC	EXISTING
EXP	EXPANSION
EXPD	EXPOSED
EXT	EXTERIOR
F	
F	FAHRENHEIT
FA	FIRE ALARM
FC	FIRE CODE
FD	FLOOR DRAIN
FE	FIRE EXTINGUISHER
FEC	FIRE EXTINGUISHER CABINET
FF	FINISH FLOOR
FFE	FINISH FLOOR ELEVATION
FGD	FINISH GRADE
FHC	FIRE HOSE CABINET
FIN	FINISH
FLASH	FLASHING
FLR	FLOOR
FOC	FACE OF CONCRETE
FOM	FACE OF MASONRY
FOLD PART	FOLDING PARTITION
FP	FILLER PANEL
FRP	FIBER REINFORCED PLASTIC
FR-WD	FIRE-RETARDANT TREATED WOOD
FS	FLOOR SCRAPER
FT	FEET
Fy	YIELD STRESS
FUR	FURRING
G	
G	GAS
GA	GAUGE
GALV	GALVANIZED
GB	GRAB BAR
GC	GENERAL CONTRACTOR
GD	GRADE
GDW, GYP.BD.	GYPSUM DRYWALL
GEN	GENERAL
GL	GLASS
GMMU	GLASS MESH MORTAR UNITS
GND	GROUND
GSFT	GLAZED STRUCTURAL FACING TILE
GYP	GYPSUM
H	
H-CONC	HARDENED CONCRETE
HB	HOSE BIBB
HC	HANDICAPPED, HOLLOW CORE
HCFV	HOLLOW CORE FINISH VENEER
HD	HEAD, HEADED, HEAVY DUTY
HDF	HANDICAP DRINKING FOUNTAIN
HDG	HOT-DIPPED GALVANIZED
HDWR	HARDWARE
HEWC	HANDICAP ELECTRIC WATER COOLER
HLB	HORIZONTAL LOUVER BLINDS
HM	HOLLOW METAL
HORIZ, H	HORIZONTAL
HR, HRS	HOUR, HOURS
HT	HEIGHT
HWD	HARD WOOD
I	
IAW	IN ACCORDANCE WITH
ID	INSIDE DIAMETER, DIMENSION
IG	INSULATING GLASS
IN	INCH, INCHES
INC	INCANDESCENT
INCL	INCLUDING
INSUL	INSULATION
INT	INTERIOR
IRWC	IMPACT-RESISTANT WALL COVERING
J	
JAN	JANITOR
JST	JOIST
JT	JOINT
L	
L	ANGLE SHAPE
LAM	LAMINATE
LAV	LAVATORY
LB	POUND
LF	LINEAR FOOT
LG	LENGTH
LIB	LIBRARY
LLH	LONG LEG HORIZONTAL
LLV	LONG LEG VERTICAL
LSD	LIQUID SOAP DISPENSER
LVR	LOUVER
LW	LIGHTWEIGHT
M	
MAS	MASONRY
MAINT	MAINTENANCE
MAX	MAXIMUM
MB	MOP BASIN
MC	MEDICINE CABINET
MECH, MECH'L	MECHANICAL
MFCS	MINERAL FIBER CEMENT SHINGLES
MFR	MANUFACTURER
MGR	MANAGER
MH	MANHOLE
MICS	MULTICOLORED INTER. COAT'G SYSTEM
MID	MIDDLE
MIN	MINIMUM
MIR	MIRROR
MISC	MISCELLANEOUS
MJ	MASONRY EXPANSION JOINT
MKBD	MARKER BOARD
MM	MILLIMETER
MMB	MEMBRANE
MO	MASONRY OPENING
MPH	MILES PER HOUR
MTD	MOUNTED
MT. MET	METAL
MULL	MULLION
N	
NA	NOT APPLICABLE
NEG	NEGATIVE
NIC	NOT IN CONTRACT
NO, #	NUMBER
NTS	NOT TO SCALE
O	
OC	ON CENTER
OCD	OVERHEAD COILING DOOR
OCG	OVERHEAD COILING GRILL
OD	OUTSIDE DIAMETER/DIMENSION
OFF	OFFICE
OH	OVERHEAD
OPH	OPPOSITE HAND
OPNG	OPENING
OPP	OPPOSITE
ORD	OVERFLOW ROOF DRAIN
P	
PA	PUBLIC ADDRESS
PAR	PARALLEL
PCP	PORTLAND CEMENT PLASTER
PEN	PENETRATION
PERP	PERPENDICULAR
PG	PLATE GLASS
PGB	PREDECORATED GYPSUM BOARD
PL, ℔	PLATE
PLAM	PLASTIC LAMINATE
PLAS	PLASTER
PLCP	PREMANUFACTURED LAMINATE CLAD PANELWORK
PLT	PLASTIC
PLYWD	PLYWOOD
PNL	PANEL
POS	POSITIVE
PPNL	PLASTIC LAMINATE PANEL
PR	PAIR
PREFAB	PREFABRICATED
PREFIN, PF	PREFINISHED
PNT	PAINT, PAINTED
PNTGR	PAINT GRADE
PT	PRESSURE TREATED
PTD	PAPER TOWEL DISPENSER
PTN	PARTITION
PVC	POLYVINYL CHLORIDE
PVMT	PAVEMENT
Q	
QA	QUALITY ASSURANCE
QT	QUARRY TILE
R	
R	RADIUS
RAF	RESILIENT ATHLETIC FLOORING
RASF	RUBBERIZED ASPHALT SHEET FLASHING
RBR	RUBBER
RCP	REINFORCED CONCRETE PIPE
RD	ROOF DRAIN
REINF	REINFORCED, REINFORCEMENT
REF	REFER, REFERENCE
REP	REPRESENTATIVE
REQD	REQUIRED
RO	ROUGH OPENING
RM	ROOM
RV	ROOF VENT
RWAF	RESILIENT WOOD ATHLETIC FLOORING
S	
SACB	SOUND ABSORBING CONCRETE BLOCK
SB	SPLASH BLOCK
SC	SOLID CORE
SCFV	SOLID CORE FLUSH VENEER
SCHED	SCHEDULE
SD	SMOKE DETECTOR
SEC	SECONDARY
SF	SQUARE FEET
SG	SLIDING GLASS DOOR
SGFT	STRUCTURAL GLAZED FACING TILE
SGL	SINGLE
SH, SHT	SHEET
SHR	SHOWER
SIM	SIMILAR
SJ	SAWN CONTROL JOINT
SLD	SEALED
SND	SANITARY NAPKIN DISPOSAL UNIT
SNT	SEALANT
SNV	SANITARY NAPKIN VENDOR
SPA	SPACES
SQ	SQUARE
SR	SHOWER ROD
SS	STAINLESS STEEL
SSK	SERVICE SINK
STD	STANDARD
STL	STEEL
STOR, STO	STORAGE
STRUCT,STRCT	STRUCTURE, STRUCTURAL
SUS	SUSPENDED
T	
T, TEL	TELEPHONE
T	TOP
TC	TEACHER CABINET
TECH	TECHNICAL
TEMP	TEMPERATURE
TKBD	TACKBOARD
TKS	TACK STRIP
TKSF	TACK SURFACE
TLT	TOILET
TOC	TOP OF CURB
TOD	TOP OF DRAIN
TOM	TOP OF MASONRY
TOS	TOP OF STEEL
TP	TOILET PARTITION
TTD	TOILET TISSUE DISPENSER
TWC	TEXTILE WALL COVERING
TWP	TRANSLUCENT WALL PANEL
TYP	TYPICAL
U	
UBC	UNIFORM BUILDING CODE
UON	UNLESS OTHERWISE NOTED
URS	URINAL SCREEN
UTIL	UTILITY
V	
V	VOLTS
V, VERT	VERTICAL
VCT	VINYL COMPOSITION TILE
VEND	VENDING
VEST	VESTIBULE
VTR	VENT THROUGH ROOF
VWC	VINYL WALL COVERING
W	
W	WATTS
W/	WITH
WB	WIND BRACE
WBBP	WIND BRACE BASEPLATE
WC	WATER CLOSET
WD	WOOD
WH	WATER HEATER
WNDW	WINDOW
WO	WITHOUT
WOM	WOMEN
WP	WEATHERPROOF
WPG	WATERPROOFING
WR	WASTE RECEPTICLE
WRGBB	WATER RESISTANT GYPSUM BACKER BOARD
WR-WD	WATER-RESISTIVE TREATED WOOD
WSTRIP	WEATHER-STRIP
WT	WEIGHT
WWF	WELDED-WIRE FABRIC

VICINITY MAP

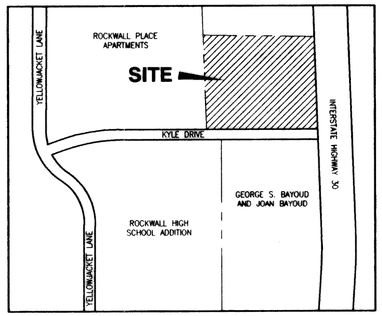

PLAN SYMBOLS

+ 445 — NEW OR REQUIRED POINT ELEVATION

+ 233.4 — EXISTING POINT ELEVATION

334 — EXISTING CONTOURS

225 — NEW CONTOURS

NAME / A101 — ROOM NAME AND NUMBER

1 / A — COLUMN REFERENCE GRID (LETTER,NUMBER)

11 / A100 — DOOR MARK, DOOR DETAIL GROUP, DOOR NUMBER

1 — WALL TYPE

1 / A1 — SECTION

1 / A1 — ELEVATION

1 / A1 — DETAIL

A — WINDOW TYPE

1 — FRAME TYPE

LEVEL LINE

P1 — COLOR MARK

1 — REVISION #

1 — DEMOLITION NOTE

DIM TO ℄ | DIM TO FACE OF STUD OR MASONRY | DIM TO FACE OF FINISH MATERIAL

TRUE NORTH

PLAN NORTH

MATERIAL LEGEND

- EARTH (UNDISTURBED)
- EARTH (COMPACTED)
- POROUS FILL (STONE OR GRAVEL, ETC.)
- ROCK
- STRUCTURAL CONCRETE
- BRICK (COMMON OR FACE)
- CONCRETE MASONRY UNITS (CMU)
- GLAZED STRUCTURAL FACING TILE (GSFT)
- CUT STONE
- METAL (LARGE SCALE)
- METAL (SMALL SCALE)
- RESILIENT FLOORING
- ACOUSTICAL CEILING TILE
- TERRAZZO
- PLASTER, SAND, CEMENT, GROUT
- GYPSUM DRYWALL
- CERAMIC TILE
- GLASS
- RIGID INSULATION
- BATT INSULATION
- ROUGH WOOD (CONTINUOUS)
- ROUGH WOOD (NON-CONTINUOUS)
- FINISH WOOD
- PLYWOOD

INDEX OF DRAWINGS

GENERAL

G1.1 COVER SHEET

CIVIL

C2.5 SITE PLAN
C2.6 KYLE DRIVE - PLAN AND PROFILE
C2.7 PAVING DETAILS
C2.8 NOT USED
C2.9 NOT USED
C2.10 NOT USED
C2.11 GRADING AND DRAINAGE PLAN
C2.12 DRAINAGE AREA MAP
C2.13 TRACK STORM SEWER PLAN
C2.14 STORM SEWER DETAILS
C2.15 SEDIMENT CONTROL PLAN
C2.16 SEDIMENT CONTROL DETAILS
C2.17 SEDIMENT CONTROL DETAILS

C2.18
C2.20
C2.21
C2.22
C2.23
C2.24
C2.25

Electrical
E9.0
E9.01
E9.02

DATE 31 AUG 1999
DRAWN BY KKE
CHECKED RAH
COMM NO. ~~0494425~~
REVISED 1494471

1999 SOCCER FIELD AND TRACK ADDITIONS TO
ROCKWALL HIGH SCHOOL
ROCKWALL INDEPENDENT SCHOOL DISTRICT
ROCKWALL, TEXAS

SHW Group Inc.
Architects + Engineers

SHEET NUMBER G-R 1.1
OF 1
SET NUMBER

GLENN ENGINEERING
PHONE 972-772-0225 FAX 972-772-0330
100 DECKER COURT - SUITE 300 IRVING, TEXAS 75062

E:\PROJ\1997\Soccer-Track\R1997-Cover_Sheet-12-13-1999.dwg Mon Dec 13 14:12:01 1999 JEFF-NT