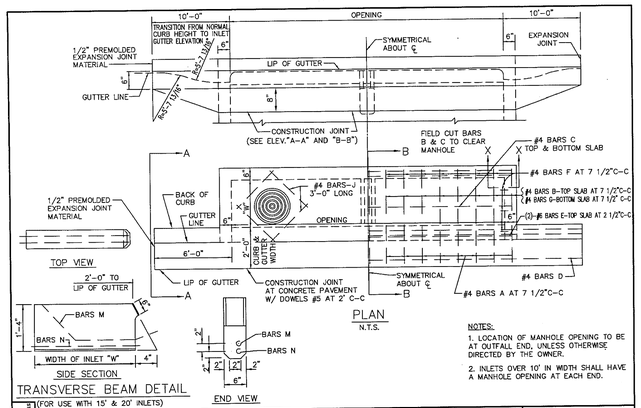

NOTES:
1. LOCATION OF MANHOLE OPENING TO BE AT OUTFALL END, UNLESS OTHERWISE DIRECTED BY THE OWNER.
2. INLETS OVER 10' IN WIDTH SHALL HAVE A MANHOLE OPENING AT EACH END.

6020A (DN, CK, QA, QC, DRAWING APPROVED)	CURB INLET 5', 10', 15' OR 20' OPENING	North Central Texas Council of Governments	STANDARD SPECIFICATION REFERENCE 702 DATE OCT. '04 / STANDARD DRAWING NO. 6020A

*MODIFICATIONS
1. ALL CONCRETE STRUCTURES SHALL BE CLASS F (4200 PSI, MINIMUM 6.5 SACK CEMENT)
2. NO FLY ASH ALLOWED IN CONCRETE FOR STRUCTURES

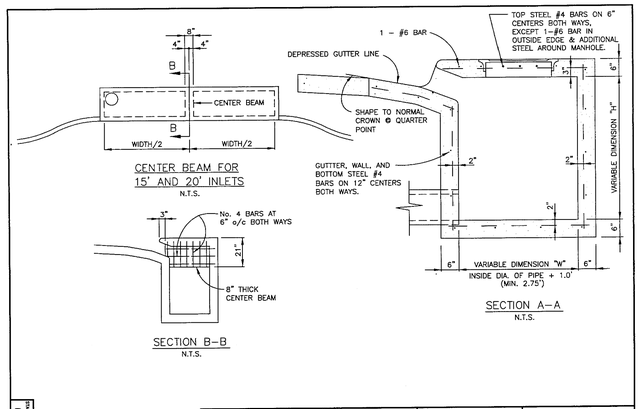

6030B (DN, CK, QA, QC, DRAWING APPROVED)	CURB INLET RECESSED CROSS SECTION & CENTER BEAM	North Central Texas Council of Governments	STANDARD SPECIFICATION REFERENCE 702 DATE OCT. '04 / STANDARD DRAWING NO. 6030B

*MODIFICATIONS
1. ALL CONCRETE STRUCTURES SHALL BE CLASS F (4200 PSI, MINIMUM 6.5 SACK CEMENT)
2. NO FLY ASH ALLOWED IN CONCRETE FOR STRUCTURES

GENERAL NOTES:
1. IN GENERAL, REINFORCING STEEL SHALL BE #4 BARS ON 12" CENTERS BOTH WAYS FOR GUTTER, BOTTOM SLAB ENDS, FRONT AND BACK WALLS, AND #4 BARS ON 6" CENTERS BOTH WAYS FOR TOP SLAB. AN ADDITIONAL #6 BAR SHALL BE PLACED IN THE FRONT EDGE OF THE TOP SLAB IN THE INLETS AND ADDITIONAL REINFORCING STEEL SHALL BE PLACED AROUND MANHOLES AS SHOWN.
2. ALL REINFORCING STEEL SHALL BE GRADE 60.
3. ALL CONCRETE SHALL BE CLASS "A". ALL EXPOSED CORNERS SHALL BE CHAMFERED 3/4".
4. ALL REINFORCING STEEL SHALL HAVE A MINIMUM COVER OF 2" TO THE CENTERS OF THE BARS.
5. 10'-0" OF EXISTING CURB AND GUTTER UPSTREAM AND 10'-0" OF EXISTING CURB AND GUTTER DOWNSTREAM SHALL BE REMOVED AND REPOURED INTEGRALLY WITH EACH INLET.
6. ALL BACK FILLING SHALL BE PERFORMED BY MECHANICAL TAMPING TO 90% STANDARD PROCTOR DENSITY.

RECORD DRAWING
THIS IS TO CERTIFY THAT CHANGES AND CORRECTIONS HAVE BEEN MADE TO CONFORM TO THE CONTRACTOR'S RECORD OF THIS PROJECT.
SIGN: Charalyn Arroyo
DATE: 06/01/2020
Glenn Engineering Corporation

6030D (DN, CK, QA, QC, DRAWING APPROVED)	CURB INLET RECESSED GENERAL NOTES	North Central Texas Council of Governments	STANDARD SPECIFICATION REFERENCE 702 DATE OCT. '04 / STANDARD DRAWING NO. 6030D

*MODIFICATIONS
1. ALL CONCRETE STRUCTURES SHALL BE CLASS F (4200 PSI, MINIMUM 6.5 SACK CEMENT)
2. NO FLY ASH ALLOWED IN CONCRETE FOR STRUCTURES
3. ALL BACKFILL SHALL BE COMPACTED TO 95% STANDARD PROCTOR DESNITY

BILL OF REINFORCING STEEL

| DEPTH "D" | ALL WIDTHS AND LENGTHS | | |