$$$$$$$$$$$$$$$$$$dgnspec$$$$$$$$$$$$$$$$$$$

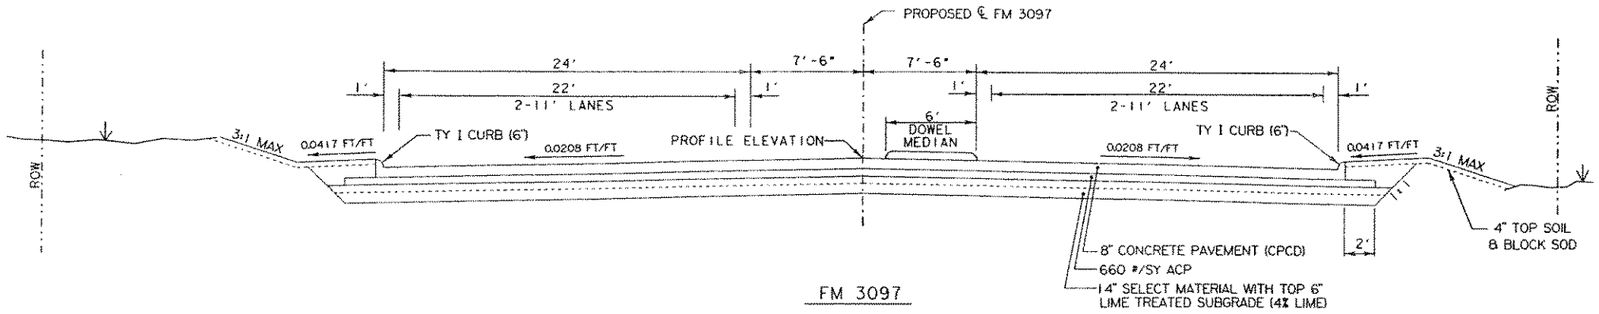

FM 3097

STA 0+45.08 TO STA 1+84.75

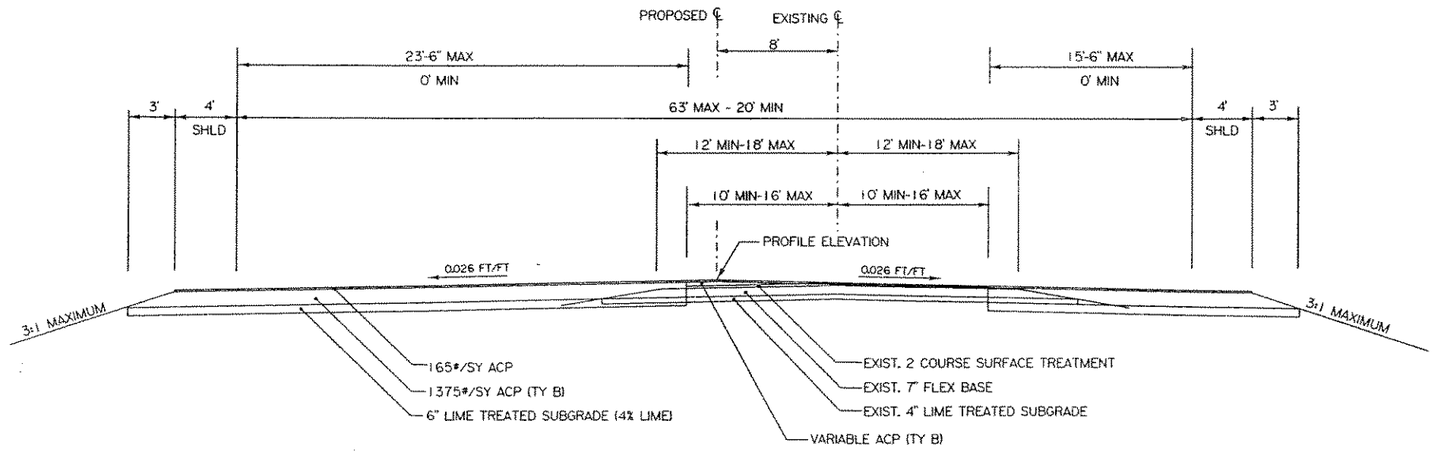

FM 3097

STA 1+84.75 TO STA 4+60

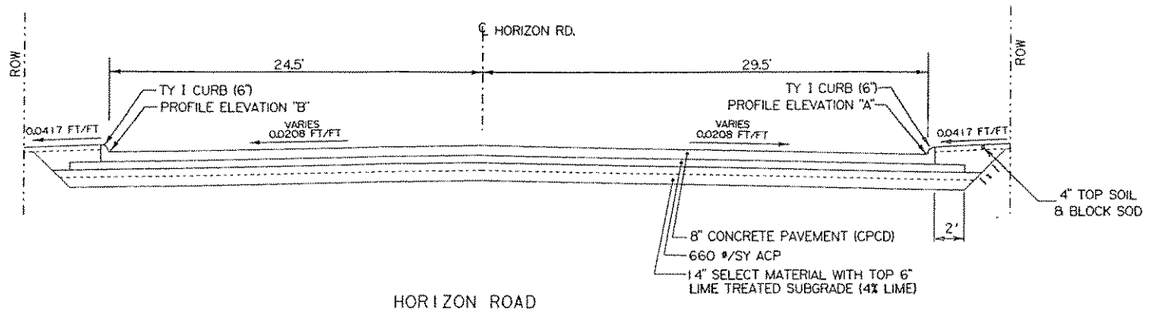

HORIZON ROAD

STA 15+33.52 TO STA 16+54.18

G. K. Wetzig
5-29-96

TYPICAL SECTIONS
SHEET 2 OF 2

FED. RD. DIV. NO.	FEDERAL AID PROJECT NO.		SHEET NO.
6	STP 96(830)MM		3
STATE	STATE DIST. NO.	COUNTY	
TEXAS	DALLAS	ROCKWALL	
CONT.	SECT.	JOB	HIGHWAY NO.
1014	03	041	FM 740

REFERENCE FILES
HORIZONTAL & VERTIC. ALIGNMENT
DRAINAGE
REMOVALS
DESIGN FILES
FM740TYPDGN

$$$$date$$$$