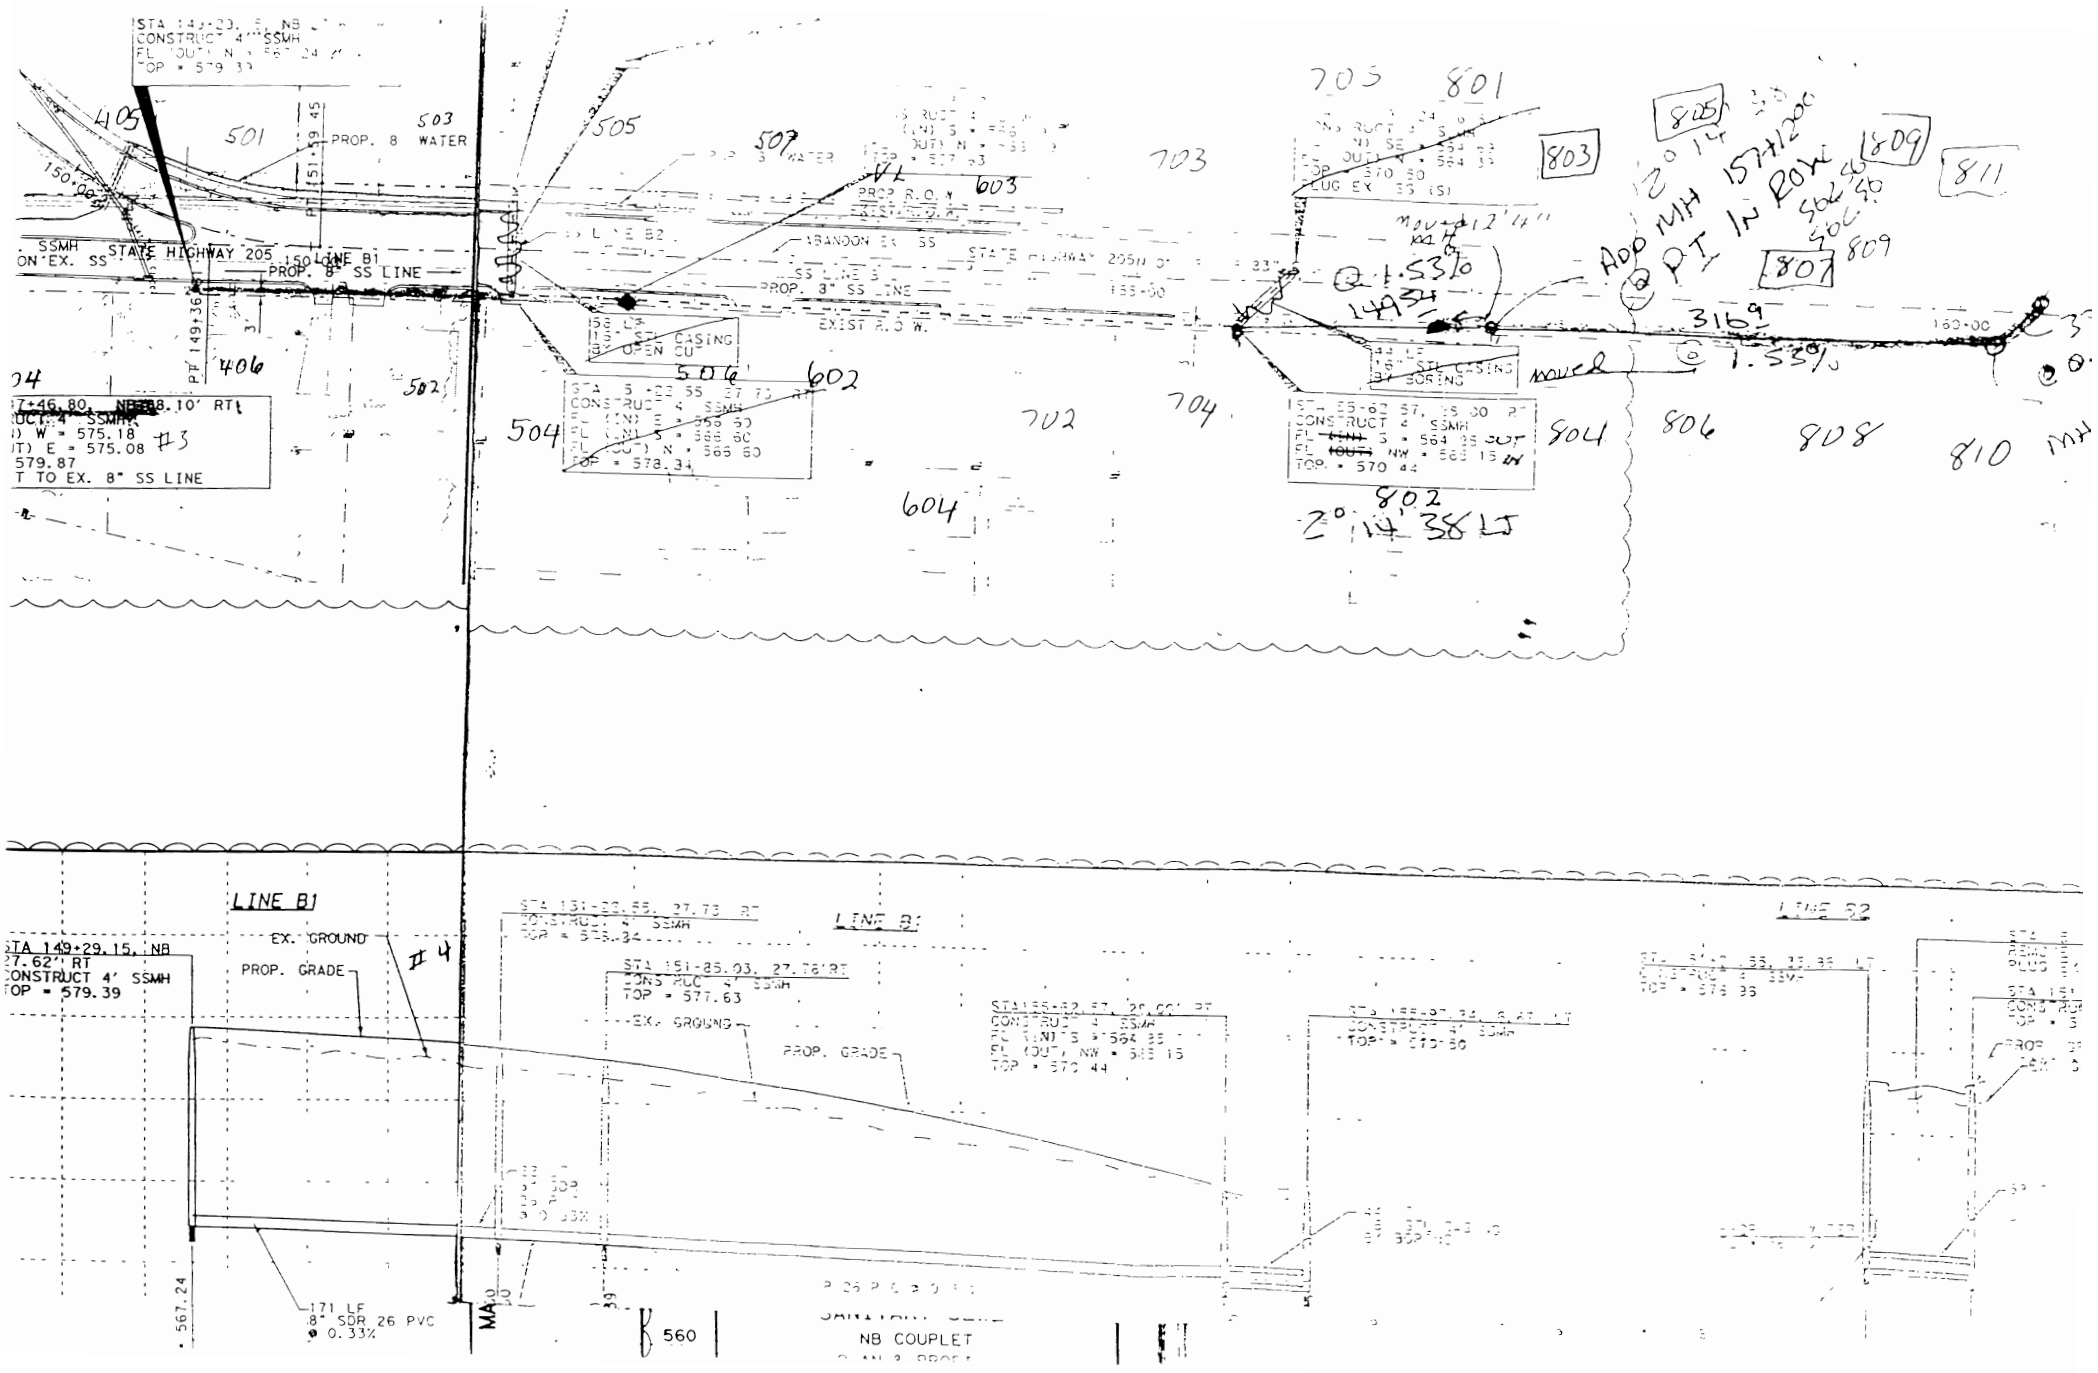

STATE HIGHWAY 205
PROP. 8" SS LINE
PROP. 8 WATER
EXIST R.O.W.
ABANDON EX. SS
STA 149+29.15, NB
27.62' RT
CONSTRUCT 4' SSMH
TOP = 579.39
LINE B1
EX. GROUND
PROP. GRADE
#4
STA 151-85.03, 27.76' RT
CONSTRUCT 4' SSMH
TOP = 577.63
171 LF
8" SDR 26 PVC
@ 0.33%
NB COUPLET
560
LINE B2
ADD MH 157+12.00
@ PT IN ROW
moved