
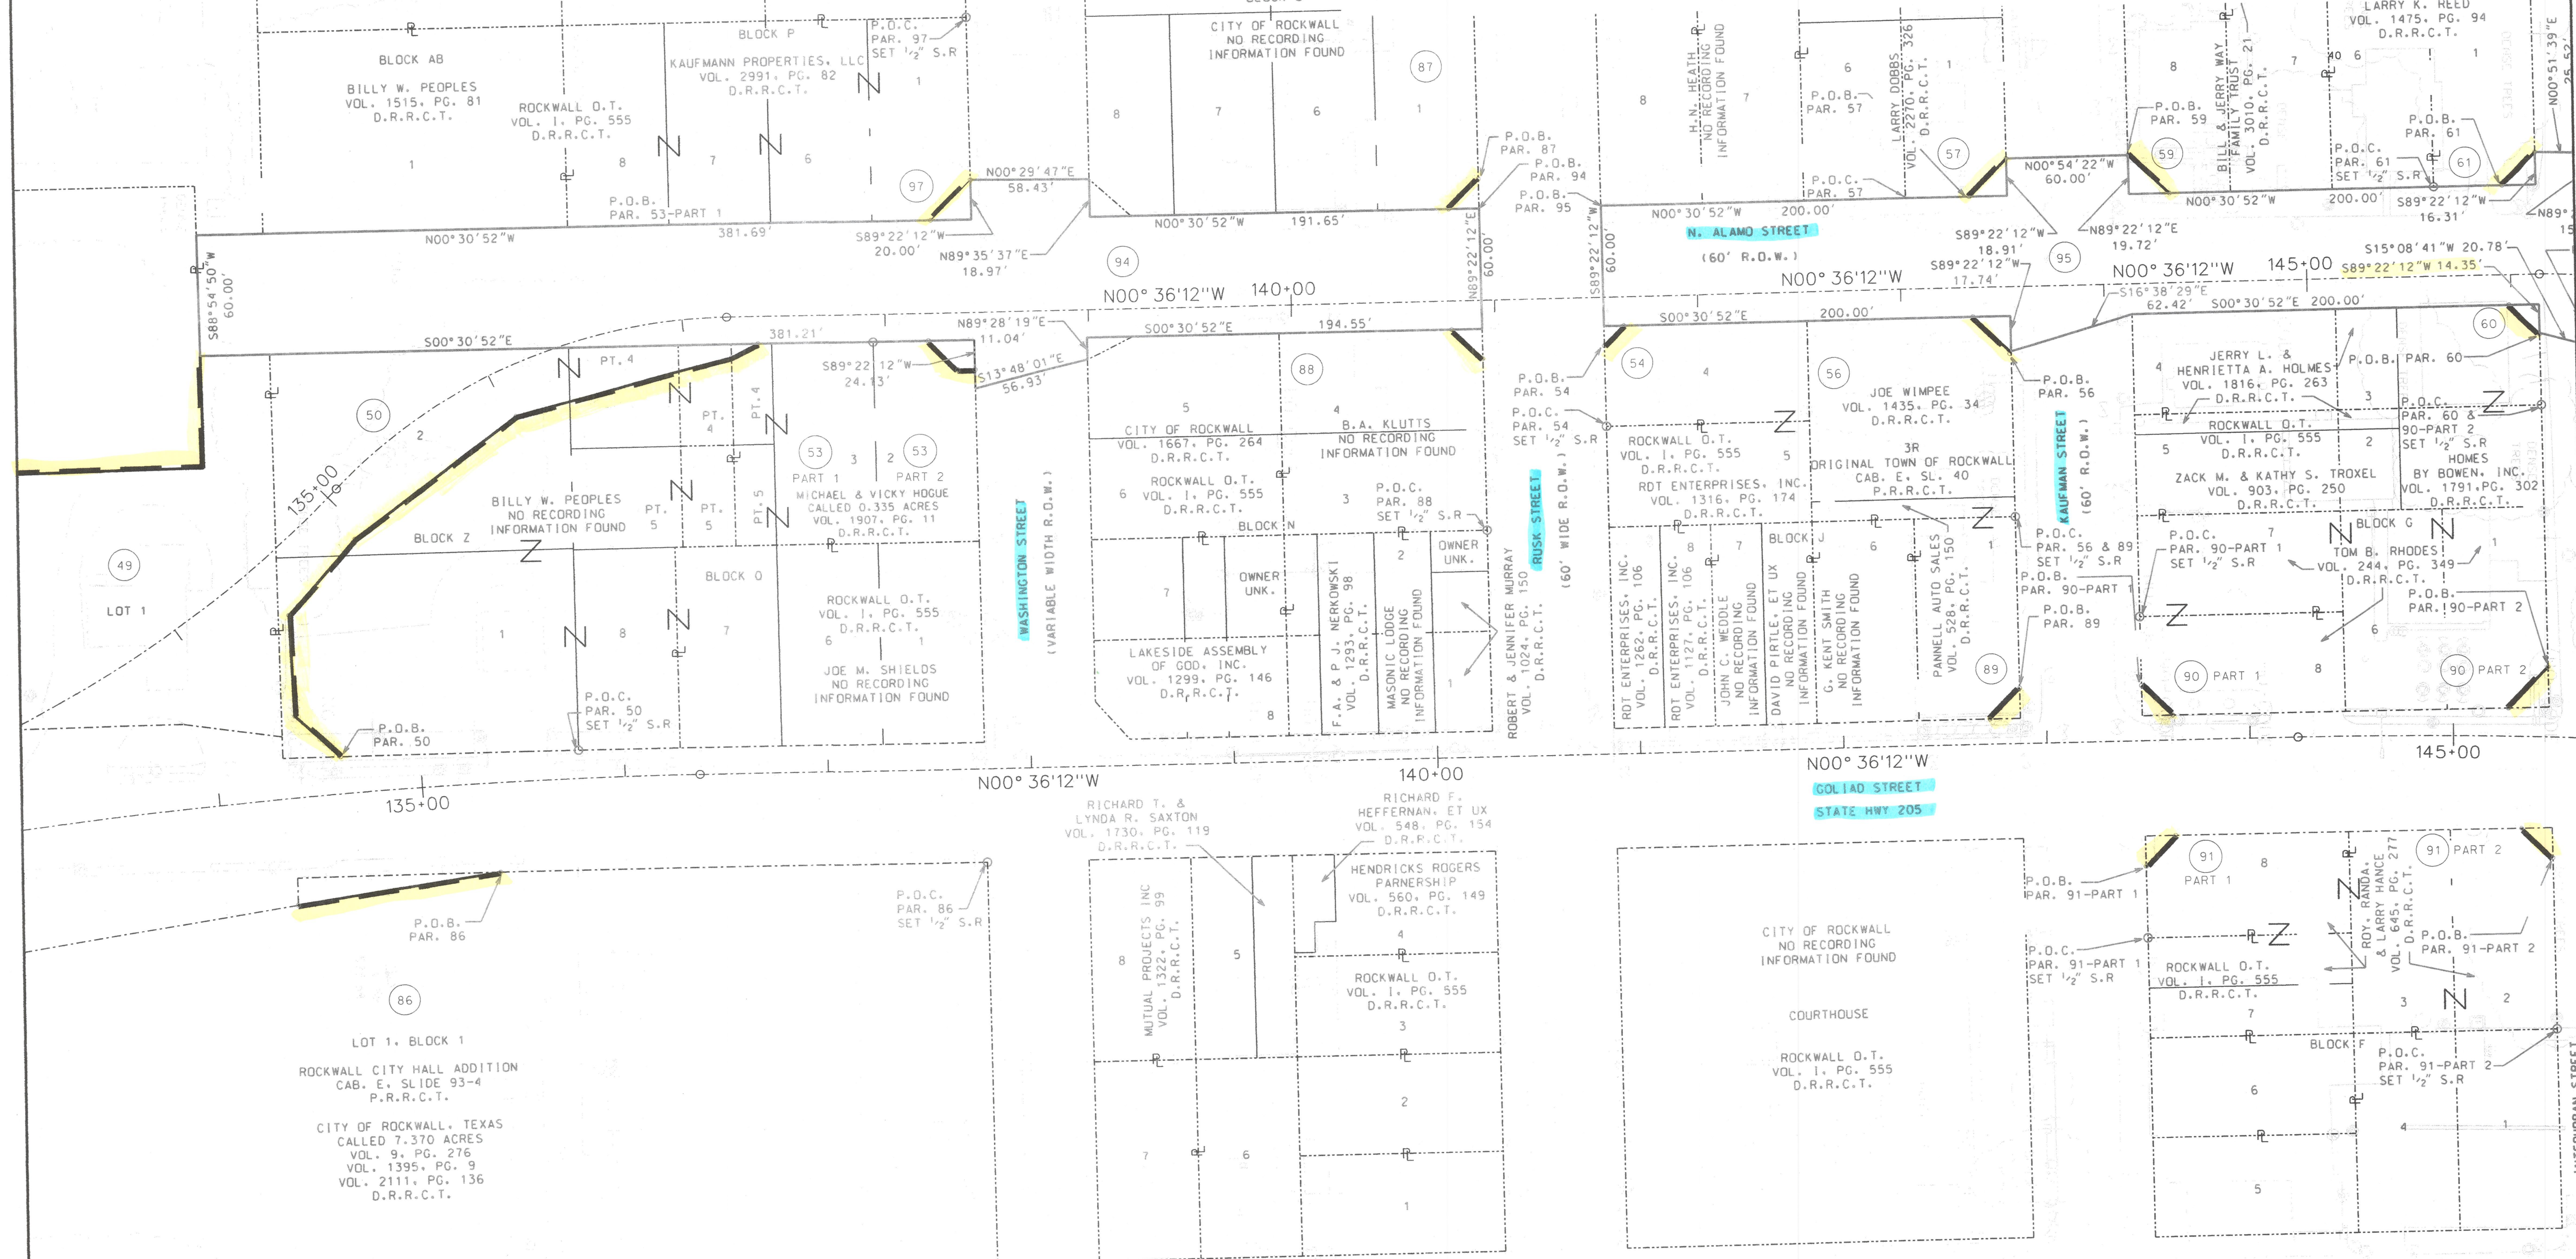


PAR. NO.	STATION TO STATION	OWNER	TYPE OF CONV.	CONVEYANCE		AREA TO BE ACQ.	REMAINDER	
				VOL.	PAGE		LEFT	RIGHT
94	135+07.43 - 140+93.36	CITY OF ROCKWALL	FEE	4896	44	0.9183 AC.		

LEGEND

- PROPOSED ROW
- EXISTING ROW
- PROPERTY LINE
- COUNTY LINE
- CONTROL OF ACCESS LINE
- SURVEY LINE
- x-x- FENCE LINE
- CITY LIMITS
- EASEMENT
- RAILROADS
- STRUCTURE
- P.O.C. POINT OF COMMENCING
- P.O.B. POINT OF BEGINNING
- FOUND CONC. MONUMENT
- SET 5/8" STEEL ROD WITH ALUMINUM TXDOT CAP
- SET OR FOUND MONUMENTATION

GRAPHIC SCALE

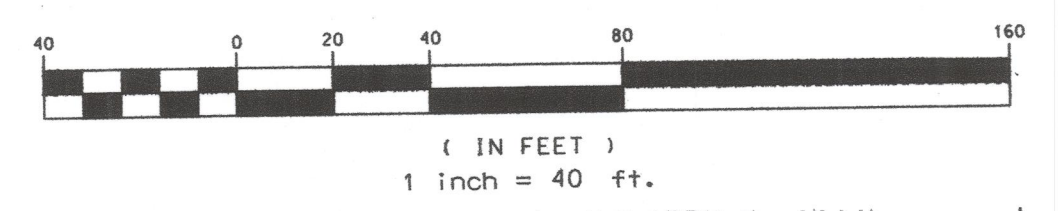

B. F. BOYDSTUN SURVEY
ABSTRACT NO. 14

NOTE:
All bearings are based upon the Texas State Plane Coordinate System, NAD 83, North Central Zone. Scale Factor: 1.000146135

2008-05-12: REVISED PARCEL 53 PT.2.
2006-07-12: REVISED PARCEL 94.

FED. RD. DIST. NO.	STATE	FEDERAL AID PROJECT NO.	HIGHWAY NO.
6	TEXAS		SH 205
STATE DISTRICT NO.	COUNTY	CONTROL NO.	SECTION NO.
18	ROCKWALL	0451	01
JOB NO.	SHEET NO.		
043	13A		