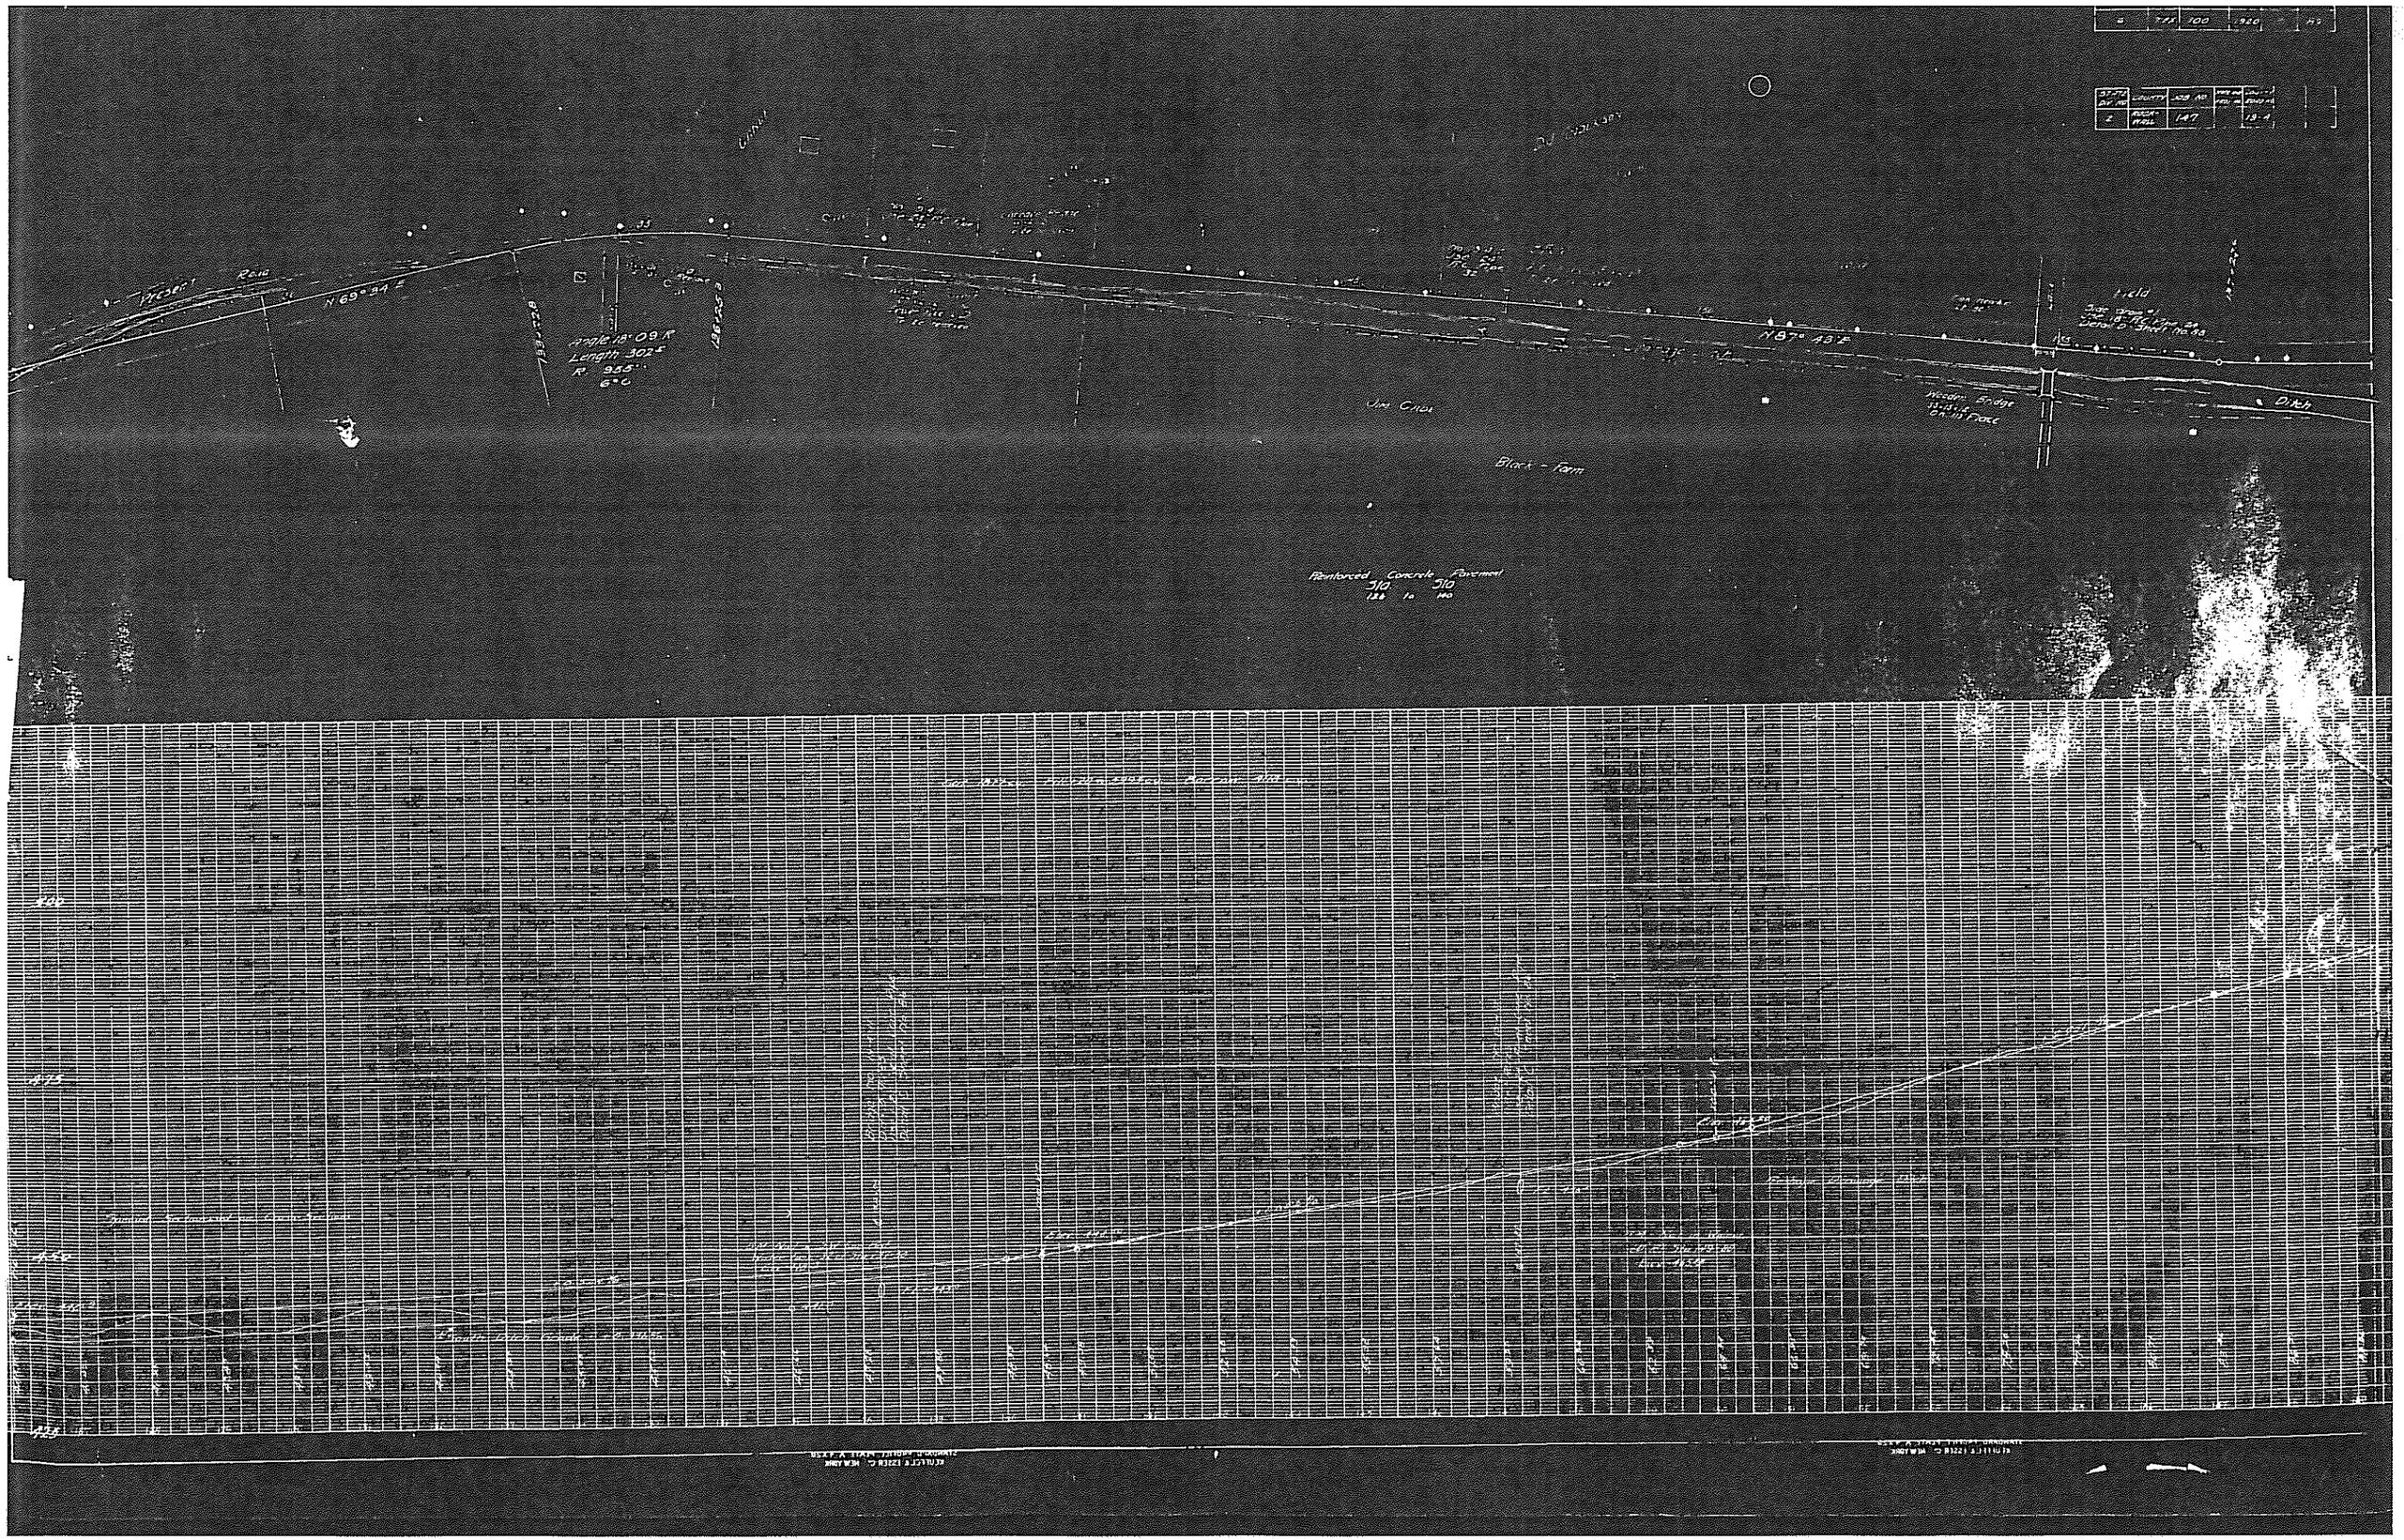
Present Road
N 69° 34' E
angle 18° 09' R
Length 302'
R 955'
6° 0
N 87° 43' E
Field
Ditch
Jim Crow
Black - Farm
Reinforced Concrete Pavement
3/10 3/10
188 to 190