



Block 501

C.W. LOWERY

MRS MELBY

N 80° 29' E

N 80° 29' E

C.W. LOWERY

MRS MELBY

Black Soil


M.K.B.T. RY. OF TEXAS

Reinforced Concrete Pavement  
510 - 510  
399 to 400

Additional Area 4.9 Sq. Yds.



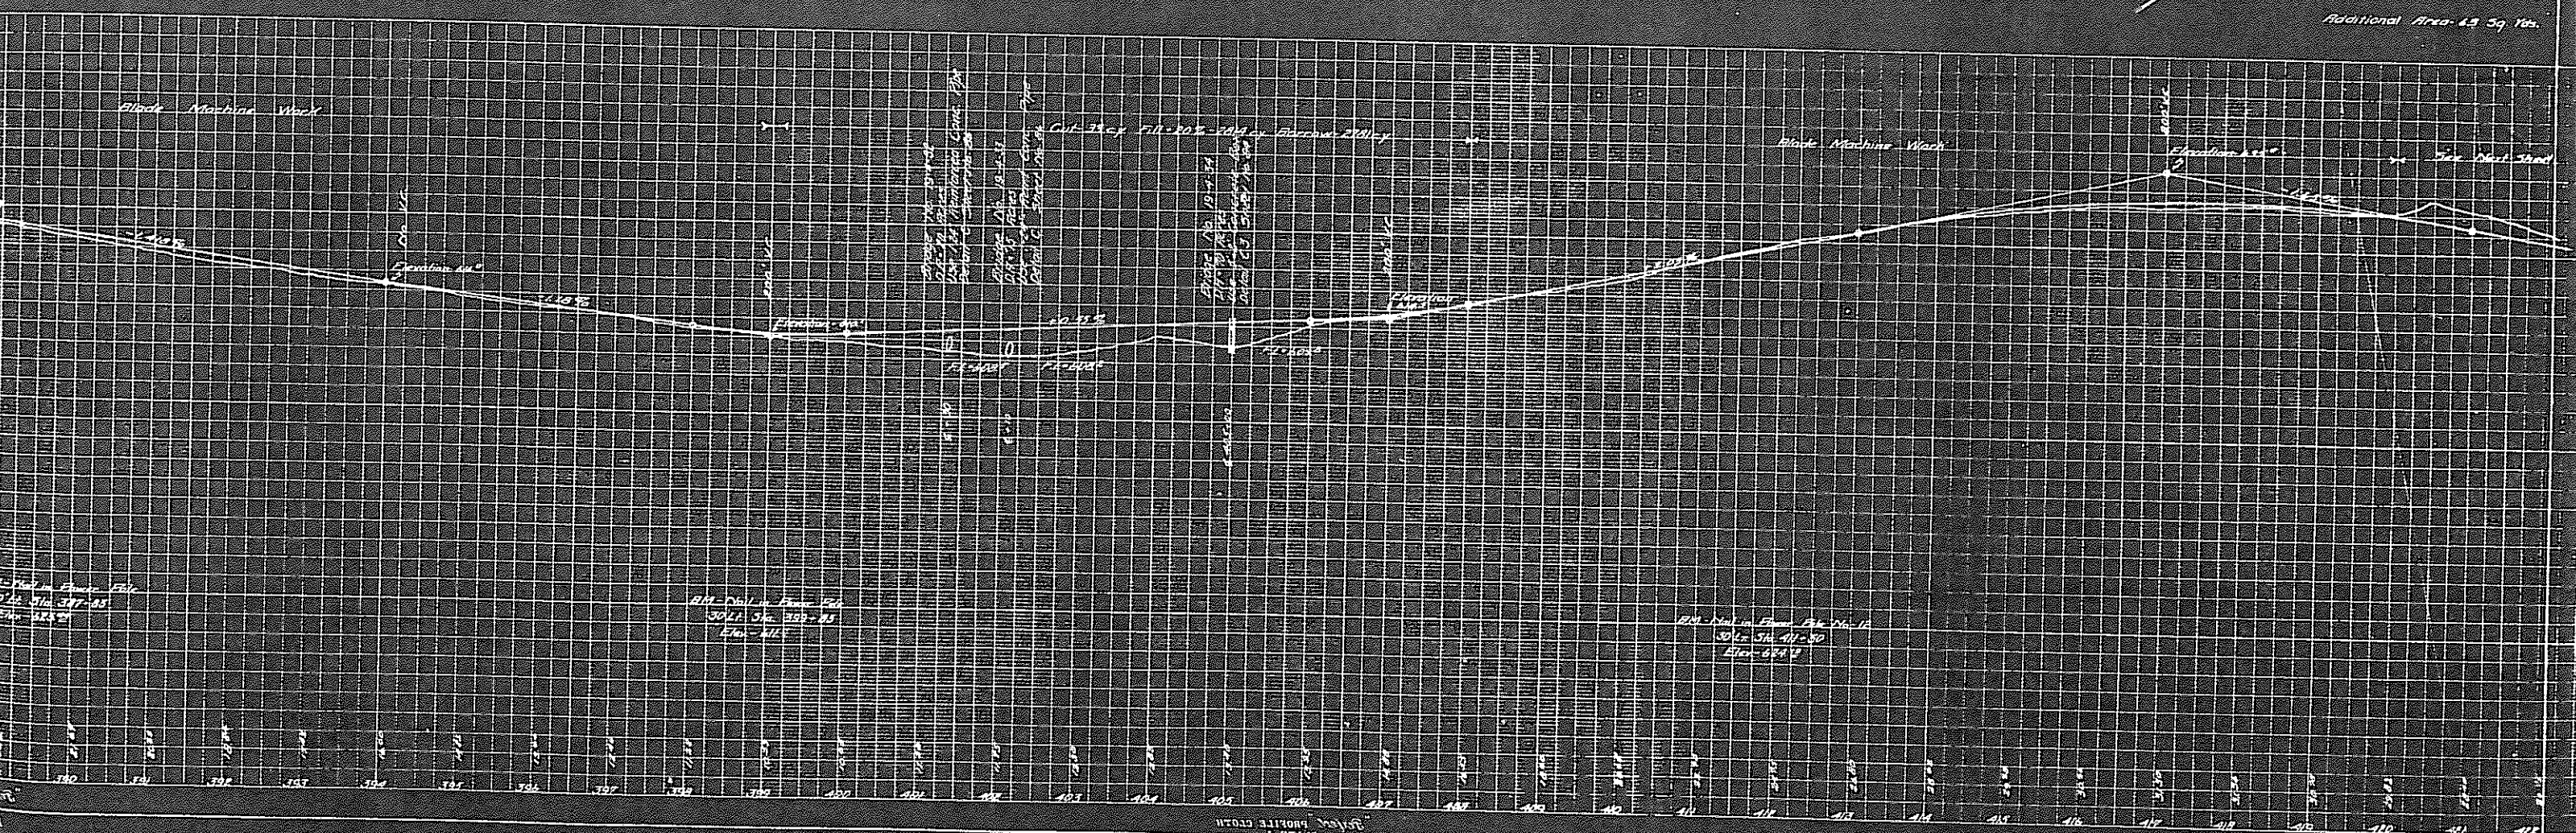




ENGINEERING DEPARTMENT  
PROF. PROFILE FORM